


PARENT PARCEL: 03-00-037-111-035 THRU -050, & -073, 03-00-037-112-007 THRU -021, & -043

CHILD PARCEL: 03-00-037-111-074 4.07 A.

22-04494

STARTING POINT: CL OF RICHELIEU AVE. & CL OF TREADWAY BLVD.

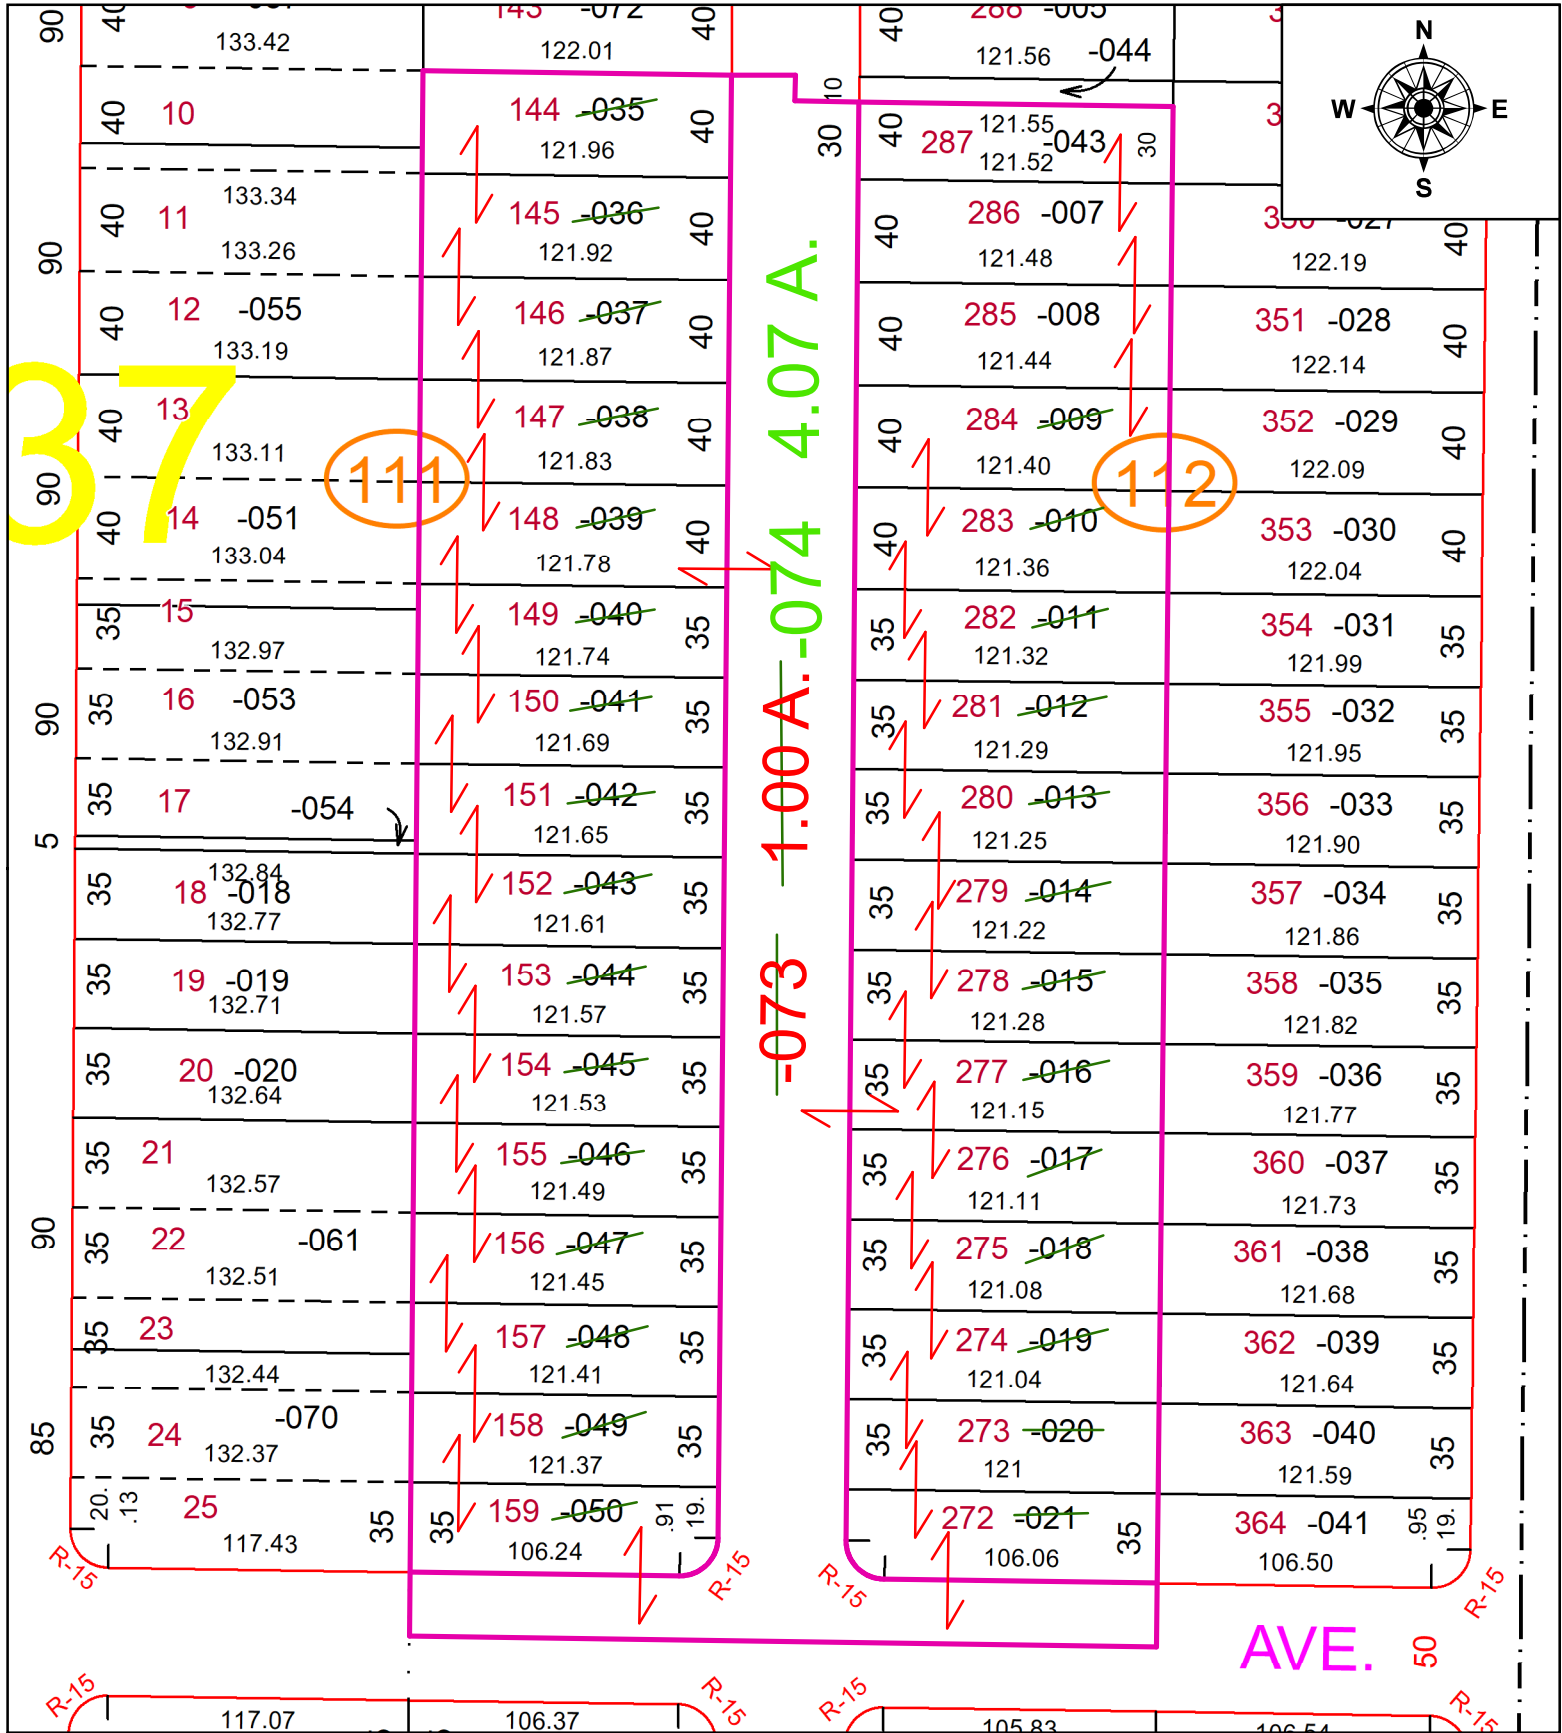

**SPLITS/DEEDS PROCESSED**  
 LORAIN COUNTY TAX MAP DEPARTMENT  
 226 MIDDLE AVE. ELYRIA, OH

**SURVEYED BY:** BRENT ANDERSON  
**CLOSURE:** 1: 33,000  
**MAP PAGE(S):** 3-00-037  
**APPROVED BY:** TJS **DATE:** 1/20/16  
**SCALE:** 1" = 75' **PRIOR INSTRUMENT:** DV XXXX/XXXX