
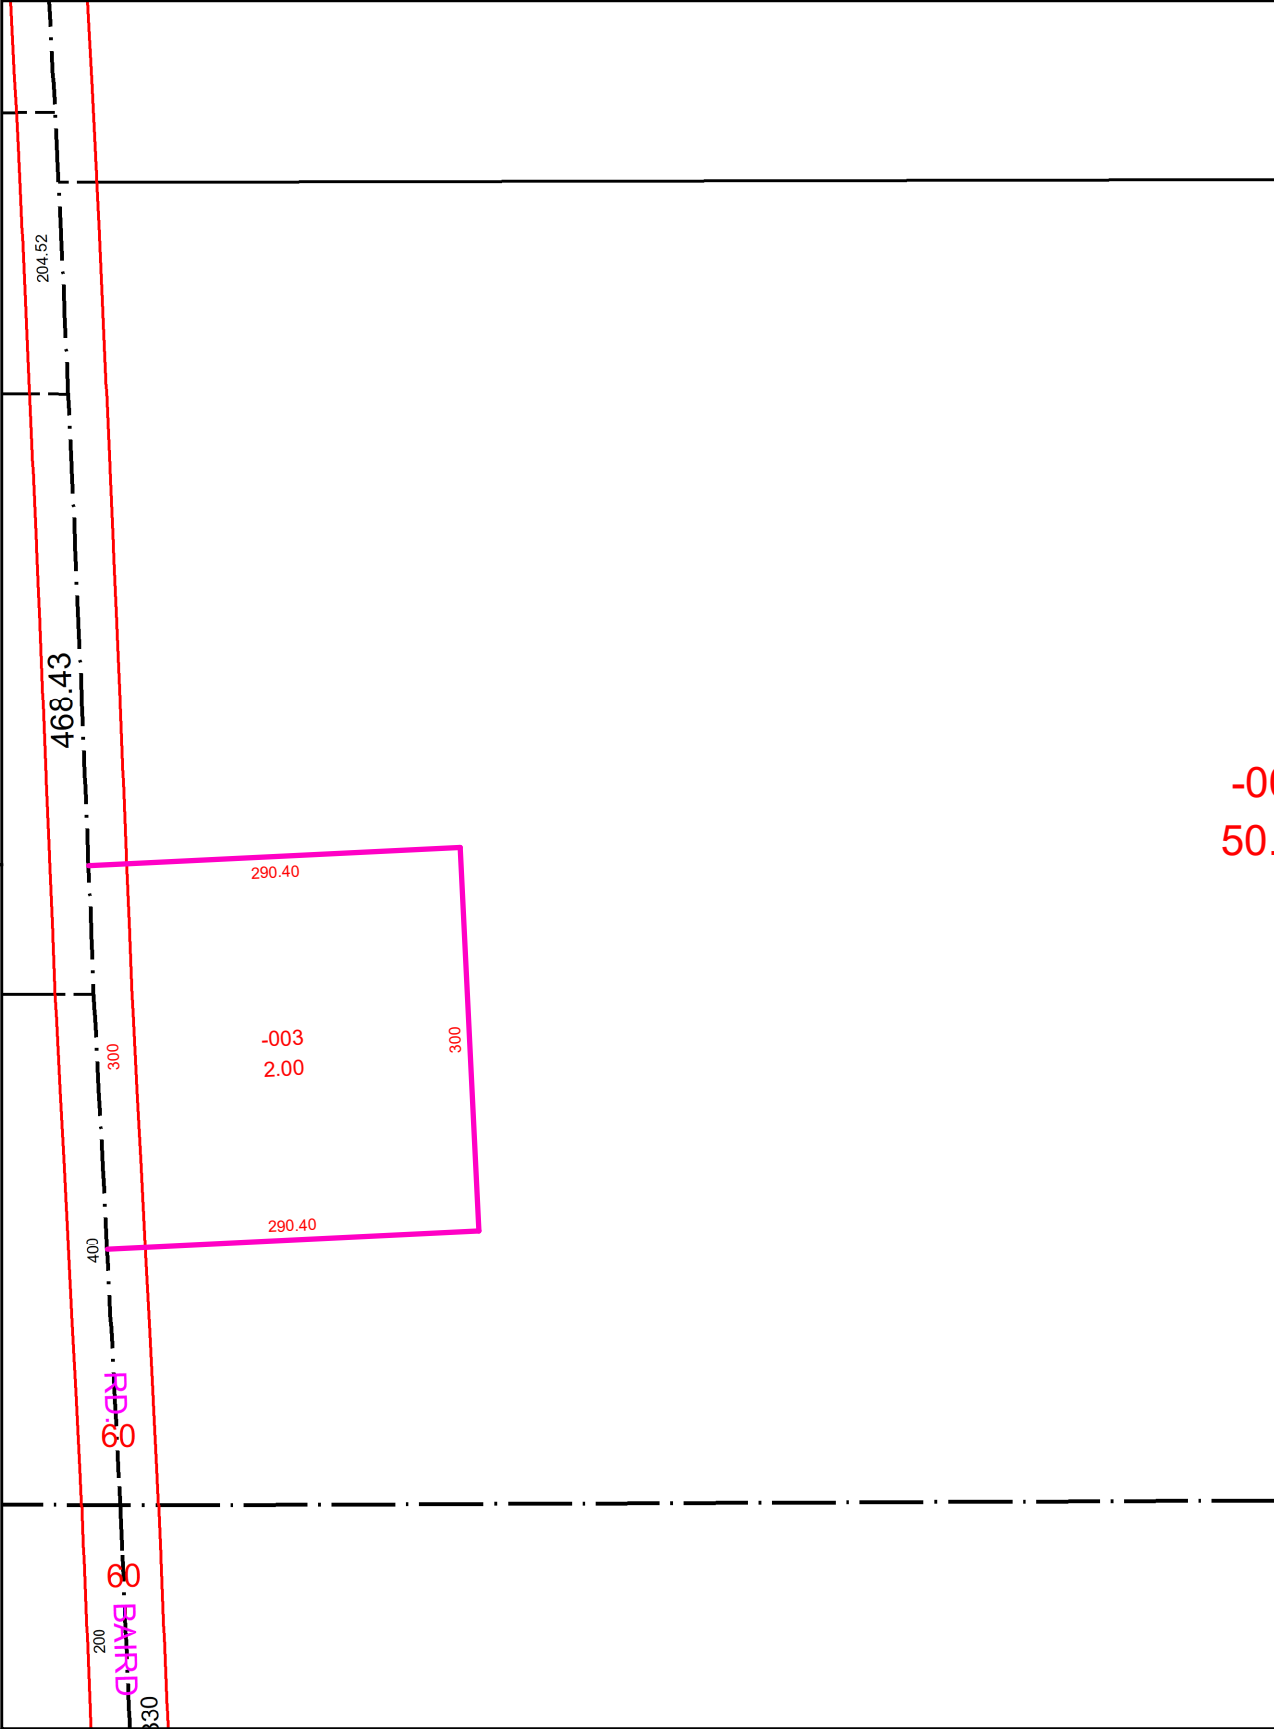


PARENT PARCEL: 08-13-004-000-002


CHILD PARCEL: 08-13-004-000-003 & -004

STARTING POINT: CL OF BAIRD RD. & S.W. CORNER OF O.L. 4 TRACT 13

22-04499

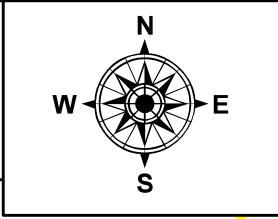

~~-004~~ ~~-002~~
50.00 52.00

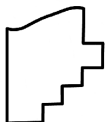

SPLITS/DEEDS PROCESSED
LORAIN COUNTY TAX MAP DEPARTMENT
226 MIDDLE AVE. ELYRIA, OH

SURVEYED BY: THOMAS SIMON
CLOSURE: 1: 2147483648
MAP PAGE(S): 08-13-004
APPROVED BY: DMA DATE: 6/13/2022
SCALE: 1" = 150' PRIOR INSTRUMENT: 2021-0853856