


PARENT PARCEL: 03-00-097-124-040, -044

CHILD PARCEL:

STARTING POINT: S/L 249 & SOUTH 22 FT OF S/L 248 IN FULTON DIVISION

21-04500-C

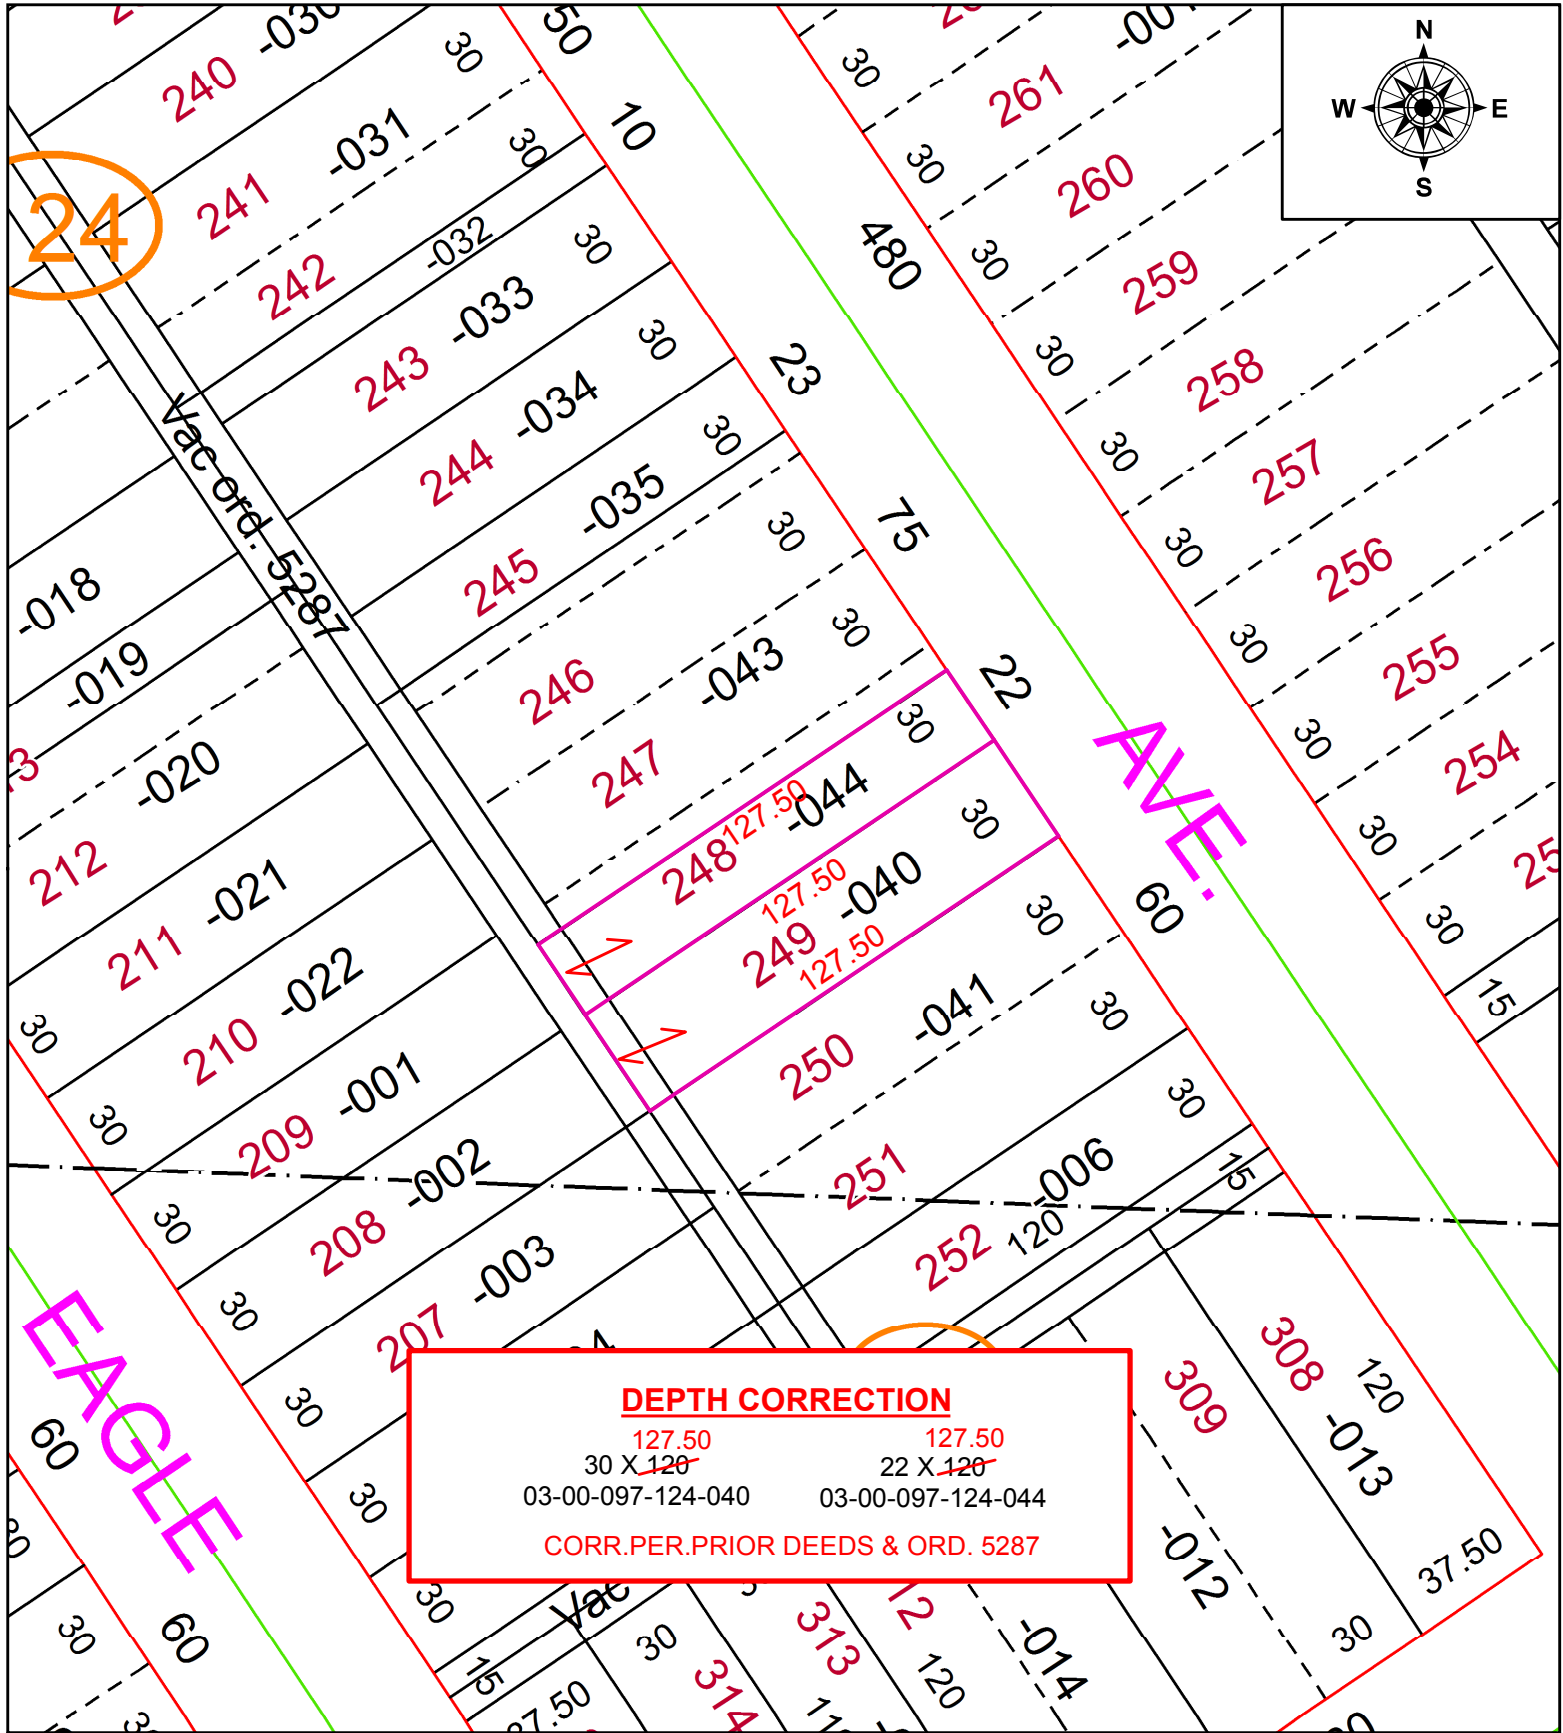

SPLITS/DEEDS PROCESSED
 LORAIN COUNTY TAX MAP DEPARTMENT
 226 MIDDLE AVE. ELYRIA, OH

SURVEYED BY: _____ N/A
 CLOSURE: _____ N/A
 MAP PAGE(S): _____ 3-00-097
 APPROVED BY: _____ RRM DATE: _____ 3-9-21
 SCALE: _____ 1" = 50 PRIORITY INSTRUMENT: _____ 20120410837