


PARENT PARCEL: 05-00-055-000-015, -017, -018, -029, 05-00-047-000-004, -029, 05-00-046-000-045, 005-00-054-000-063

CHILD PARCEL: 05-00-055-000-044, 05-00-047-000-032, 05-00-046-000-045, 005-00-054-000-063

22-04500

STARTING POINT: AC CORR PER SURV BY AMY M. KELLY

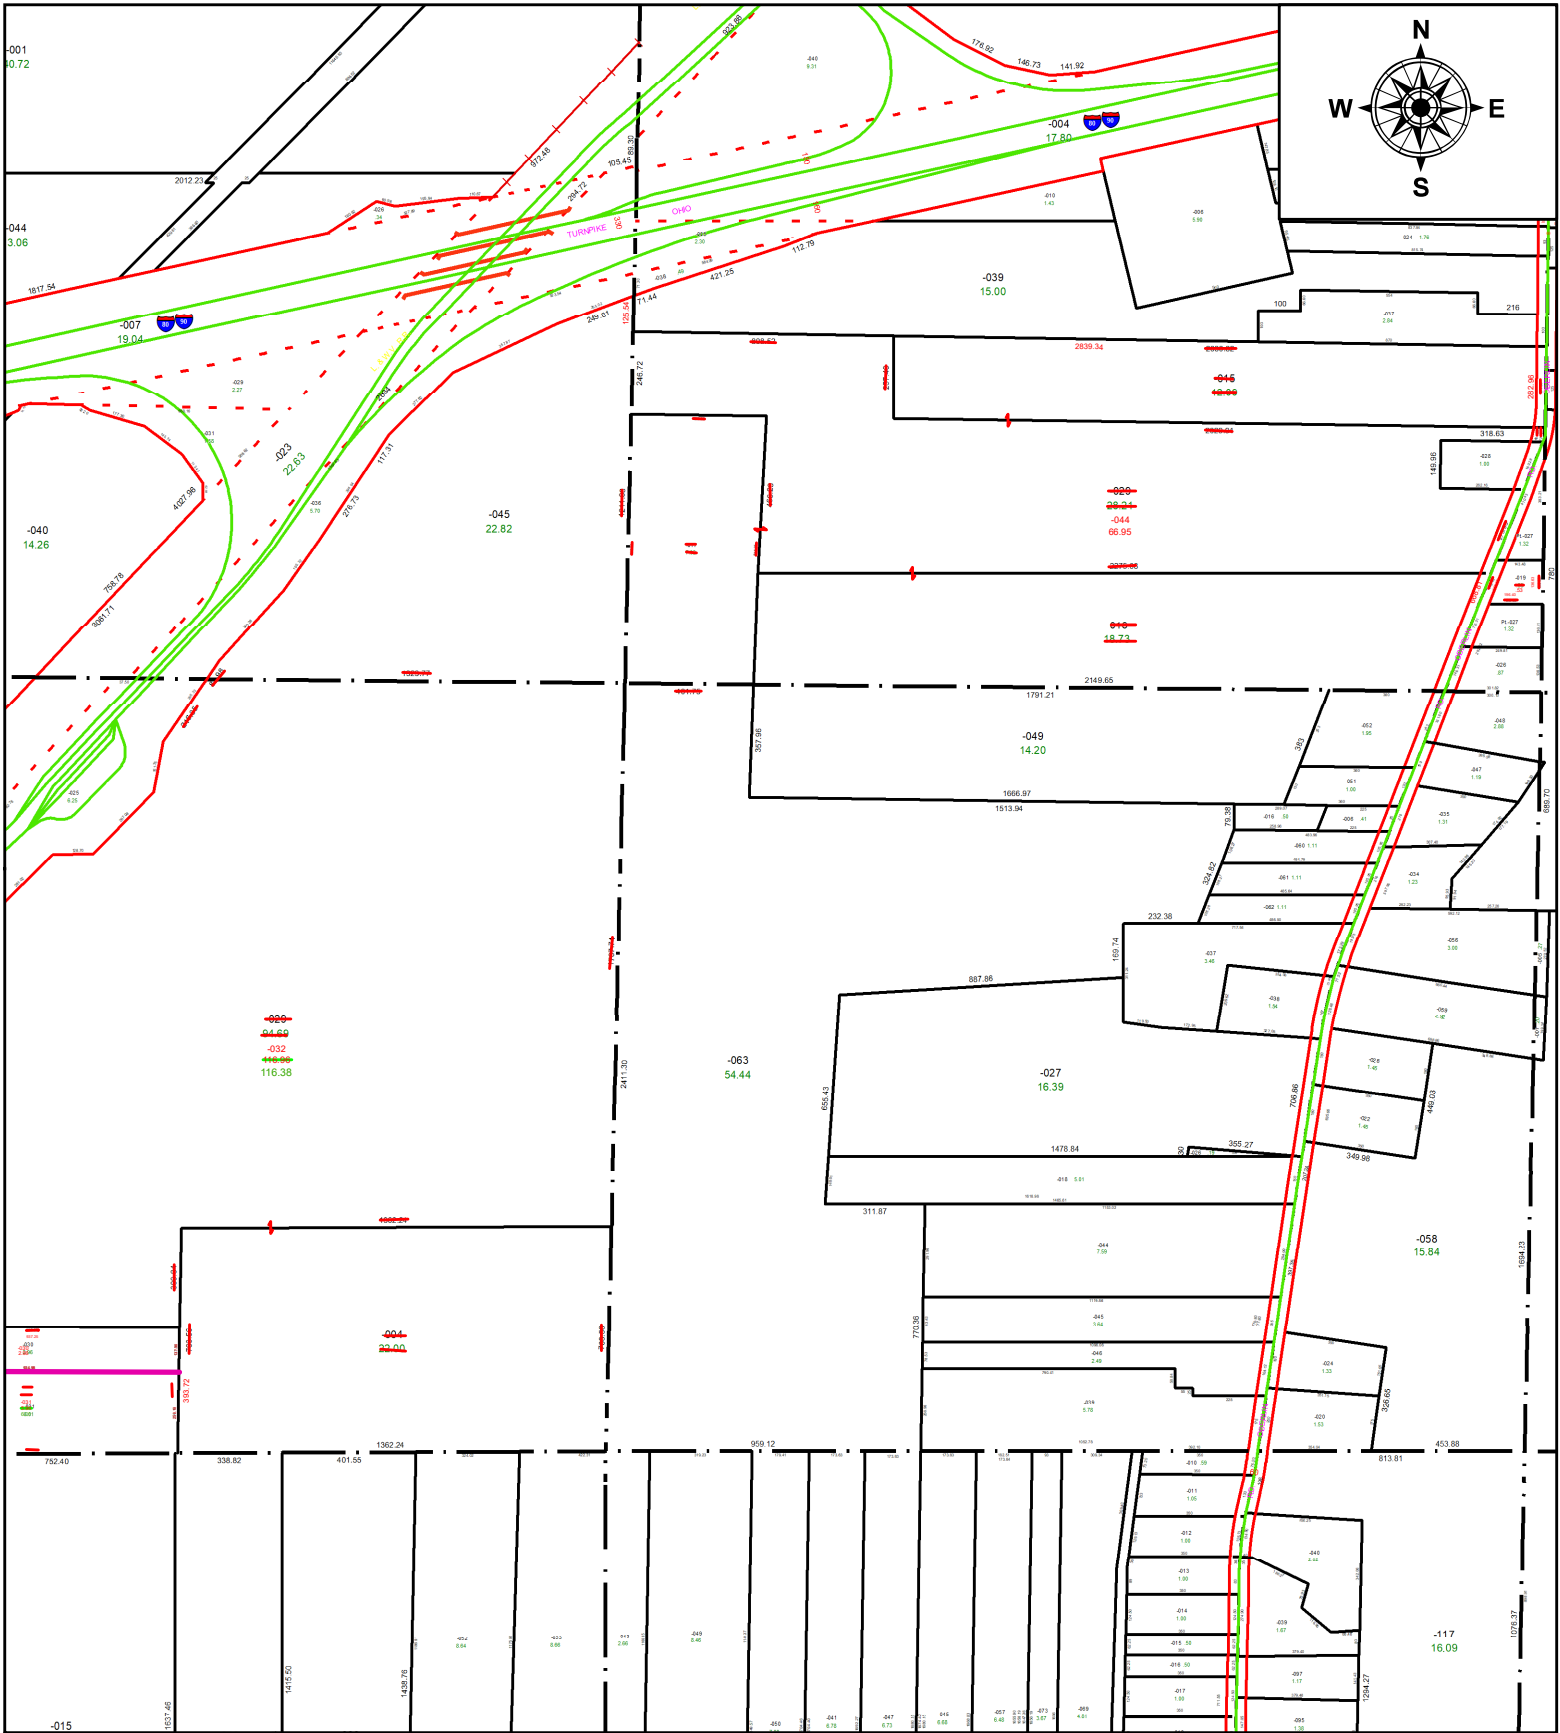

SPLITS/DEEDS PROCESSED

LORAIN COUNTY TAX MAP DEPARTMENT
226 MIDDLE AVE. ELYRIA, OH

SURVEYED BY: AMY M. KELLY

CLOSURE: 1: 100789

MAP PAGE(S): 05-00-055A, B

APPROVED BY: AC DATE: 6/14/2022

SCALE: 1" = 600 PRIOR INSTRUMENT: 2021- 0820616