




PARENT PARCEL: 10-00-020-103-111 & -114

CHILD PARCEL: 10-00-020-103-115

N/A

22-04501

STARTING POINT: INTERSECTION OF C/LS OF HASTINGS RD & HALE RD AT A MONUMENT BOX

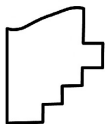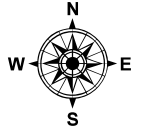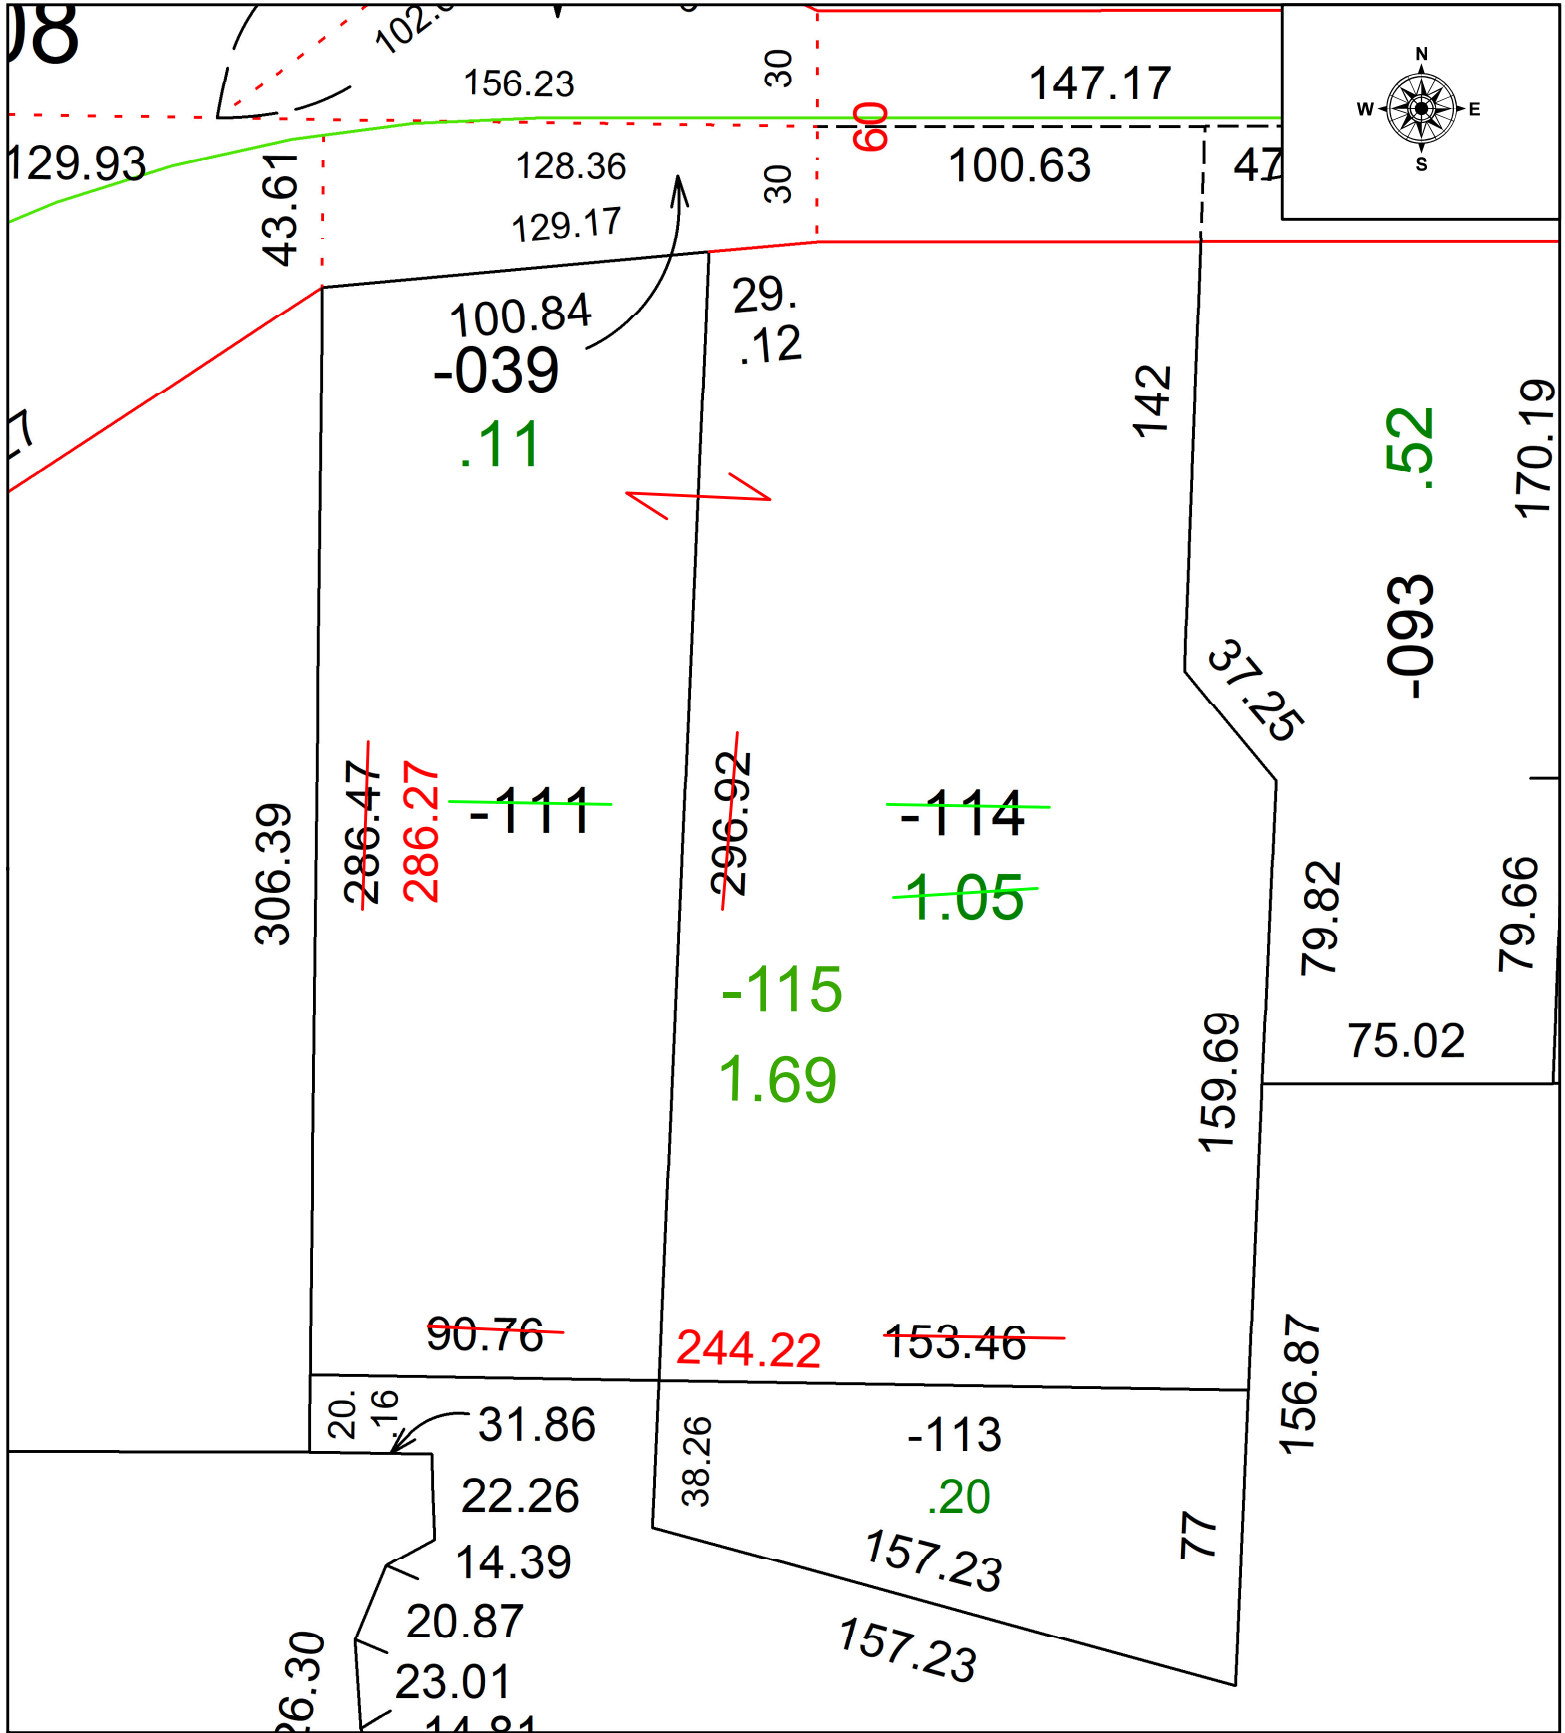

**SPLITS/DEEDS PROCESSED**  
 LORAIN COUNTY TAX MAP DEPARTMENT  
 226 MIDDLE AVE. ELYRIA, OH

SURVEYED BY: PHILA ROSEBUCK SURVEY # N/A  
 CLOSURE: 1: 217104  
 MAP PAGE(S): 10-00-020  
 APPROVED BY: WRZ DATE: 6/13/2022  
 SCALE: 1" = 50 PRIOR INSTRUMENT: 2013-06100327