
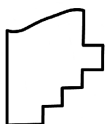
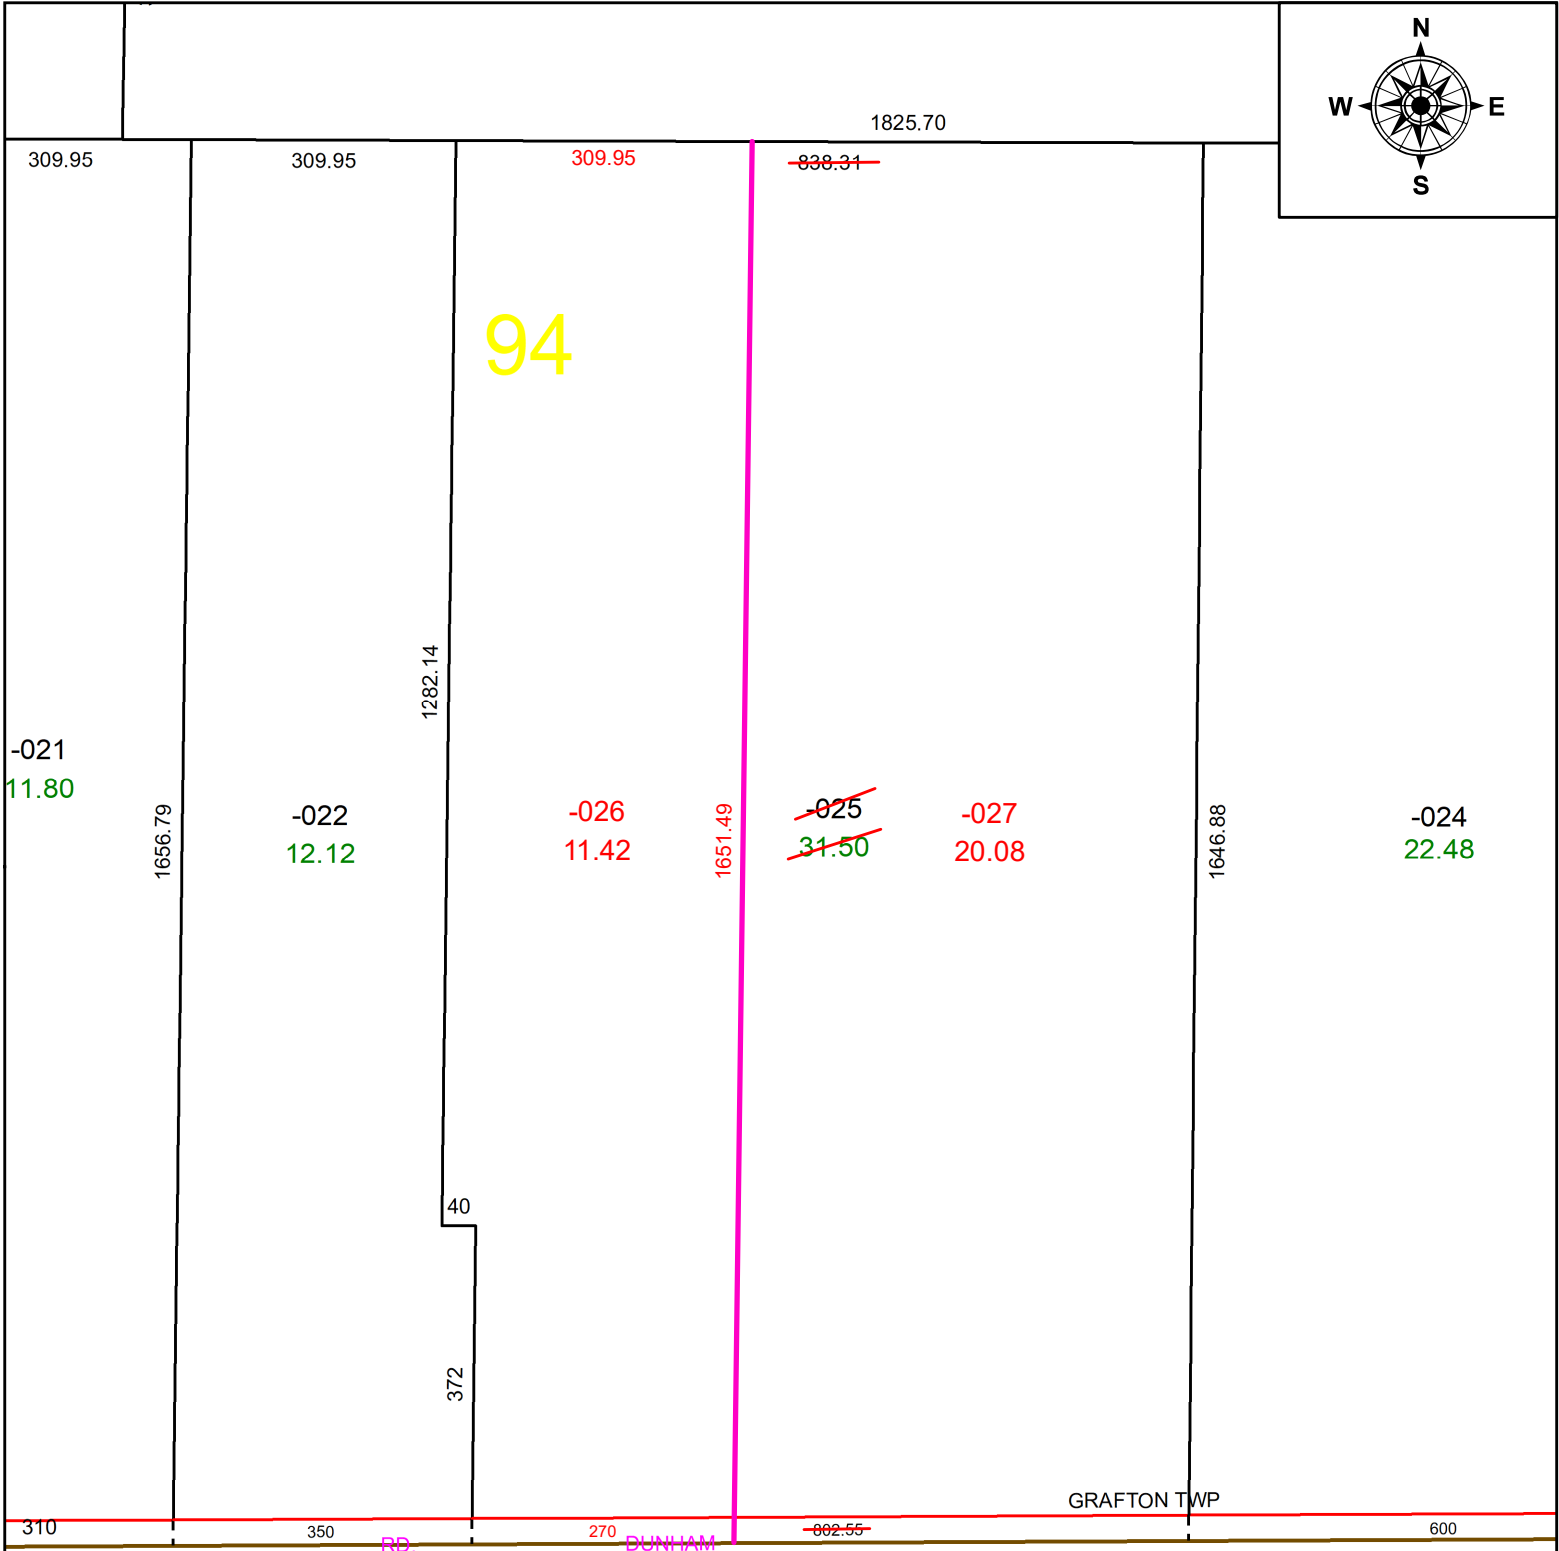


PARENT PARCEL: 16-00-094-000-025

CHILD PARCEL: 16-00-094-000-026 & -027

STARTING POINT: CL OF DUNHAM RD. & S.E. CORNER O.L. 94

22-04503

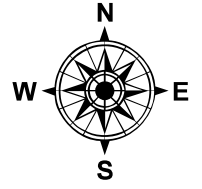

SPLITS/DEEDS PROCESSED
 LORAIN COUNTY TAX MAP DEPARTMENT
 226 MIDDLE AVE. ELYRIA, OH

SURVEYED BY: DOUGLAS JEWEL
CLOSURE: 1: 687087
MAP PAGE(S): 16-00-094
APPROVED BY: DMA **DATE:** 6/27/2022
SCALE: 1" = 225' **PRIOR INSTRUMENT:** 2011-0364852