
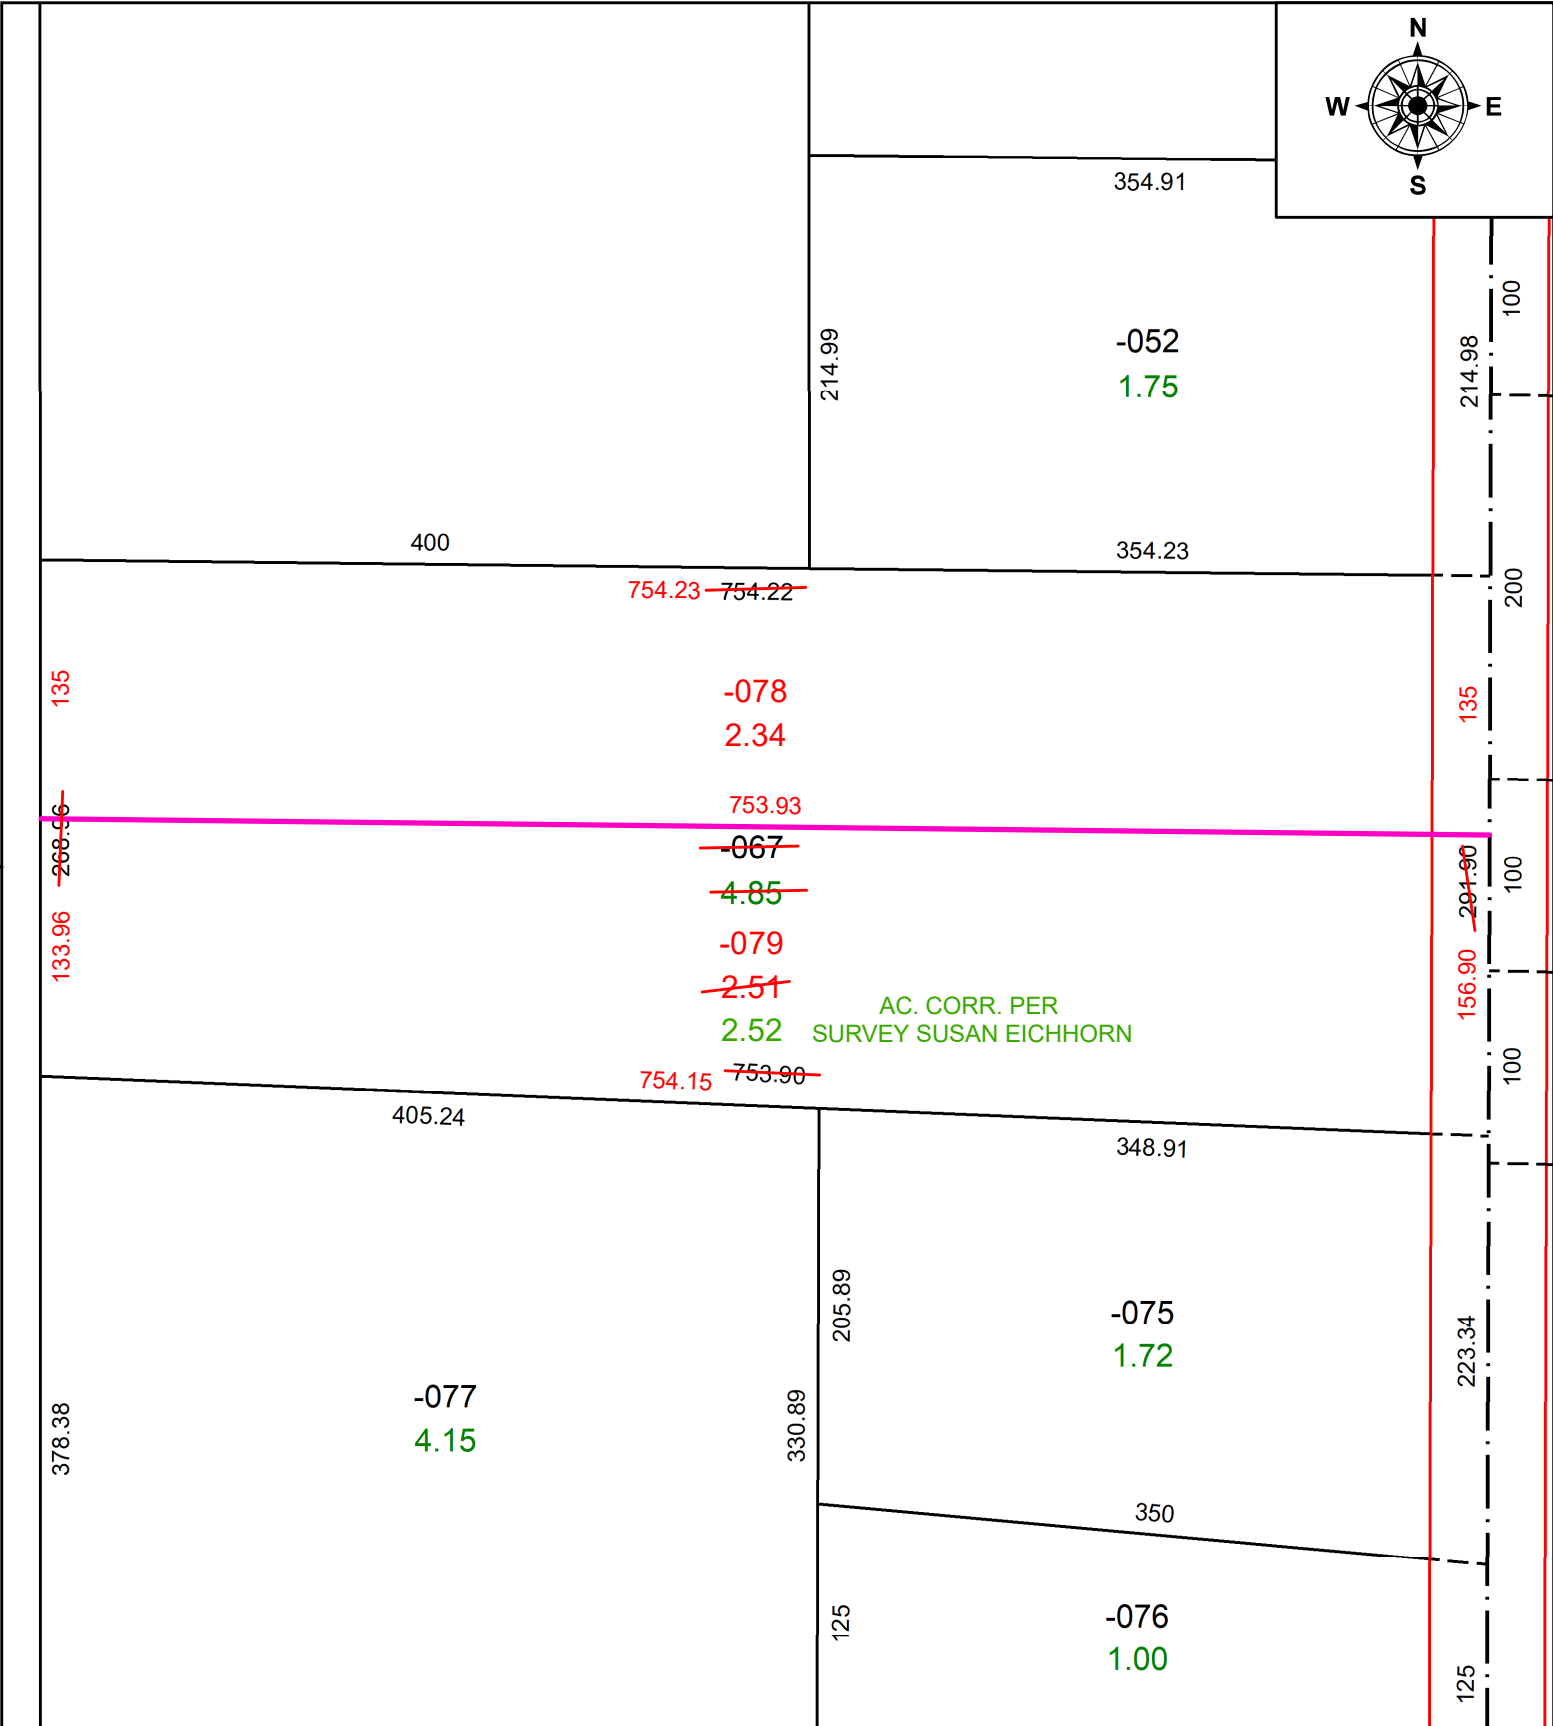


PARENT PARCEL: 11-00-085-000-067

CHILD PARCEL: 11-00-085-000-078 & -079

STARTING POINT: CL OF ROYALTON RD. & S. DURKEE RD.

22-04505

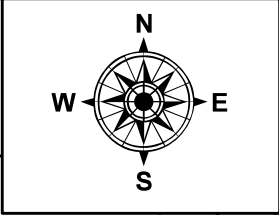

SPLITS/DEEDS PROCESSED
 LORAIN COUNTY TAX MAP DEPARTMENT
 226 MIDDLE AVE. ELYRIA, OH

SURVEYED BY: SUSAN EICHHORN
 CLOSURE: 1: 684295
 MAP PAGE(S): 11-00-085
 APPROVED BY: DMA DATE: 6/15/2022
 SCALE: 1" = 100' PRIOR INSTRUMENT: 2017-0653933