
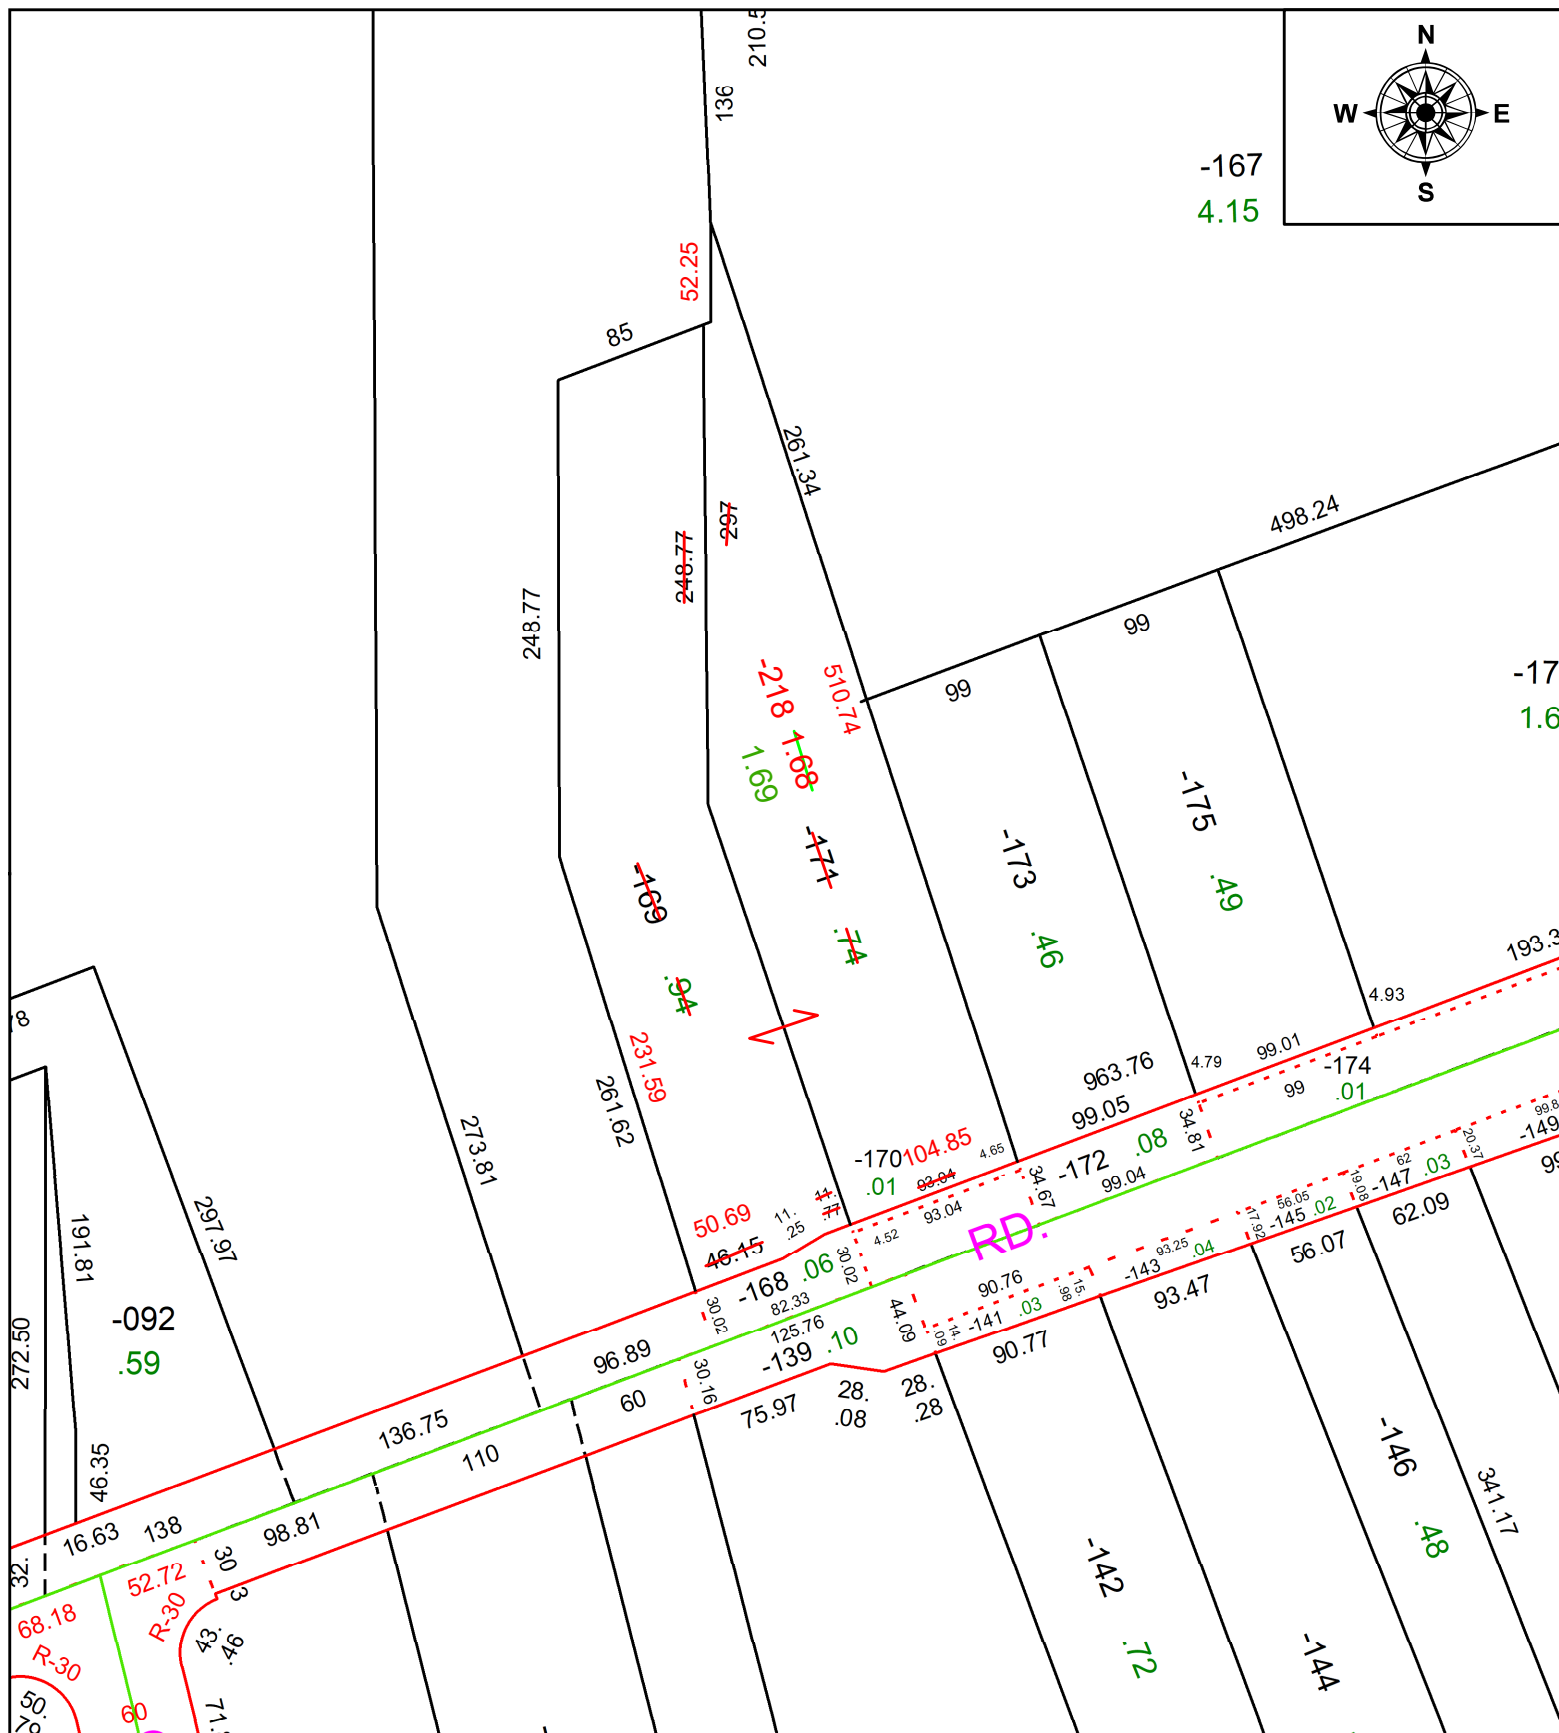


PARENT PARCEL: 07-00-028-101-169, -171

CHILD PARCEL: 07-00-028-101-218

22-04506

STARTING POINT: **AC CORR PER SURV BY EDWARD B. DUDLEY III**

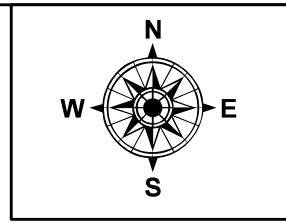

**SPLITS/DEEDS PROCESSED**  
LORAIN COUNTY TAX MAP DEPARTMENT  
226 MIDDLE AVE. ELYRIA, OH

**SURVEYED BY:** EDWARD B. DUDLEY III  
**CLOSURE:** 1: 224357  
**MAP PAGE(S):** 07-00-028-C  
**APPROVED BY:** AC **DATE:** 6/15/2022  
**SCALE:** 1" = 100 **PRIOR INSTRUMENT:** 2021- 0798498