
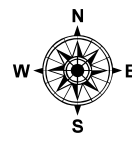


PARENT PARCEL: 02-01-007-102-051 & -066


CHILD PARCEL: 02-01-007-102-068, -069, & -070 ACREAGE CORRECTION PER SURVEYOR PATRICK MCGANNON

22-04507

STARTING POINT: INTERSECTION OF C/LS OF PEG DR & WASHINGTON AVE AT A MONUMENT BOX

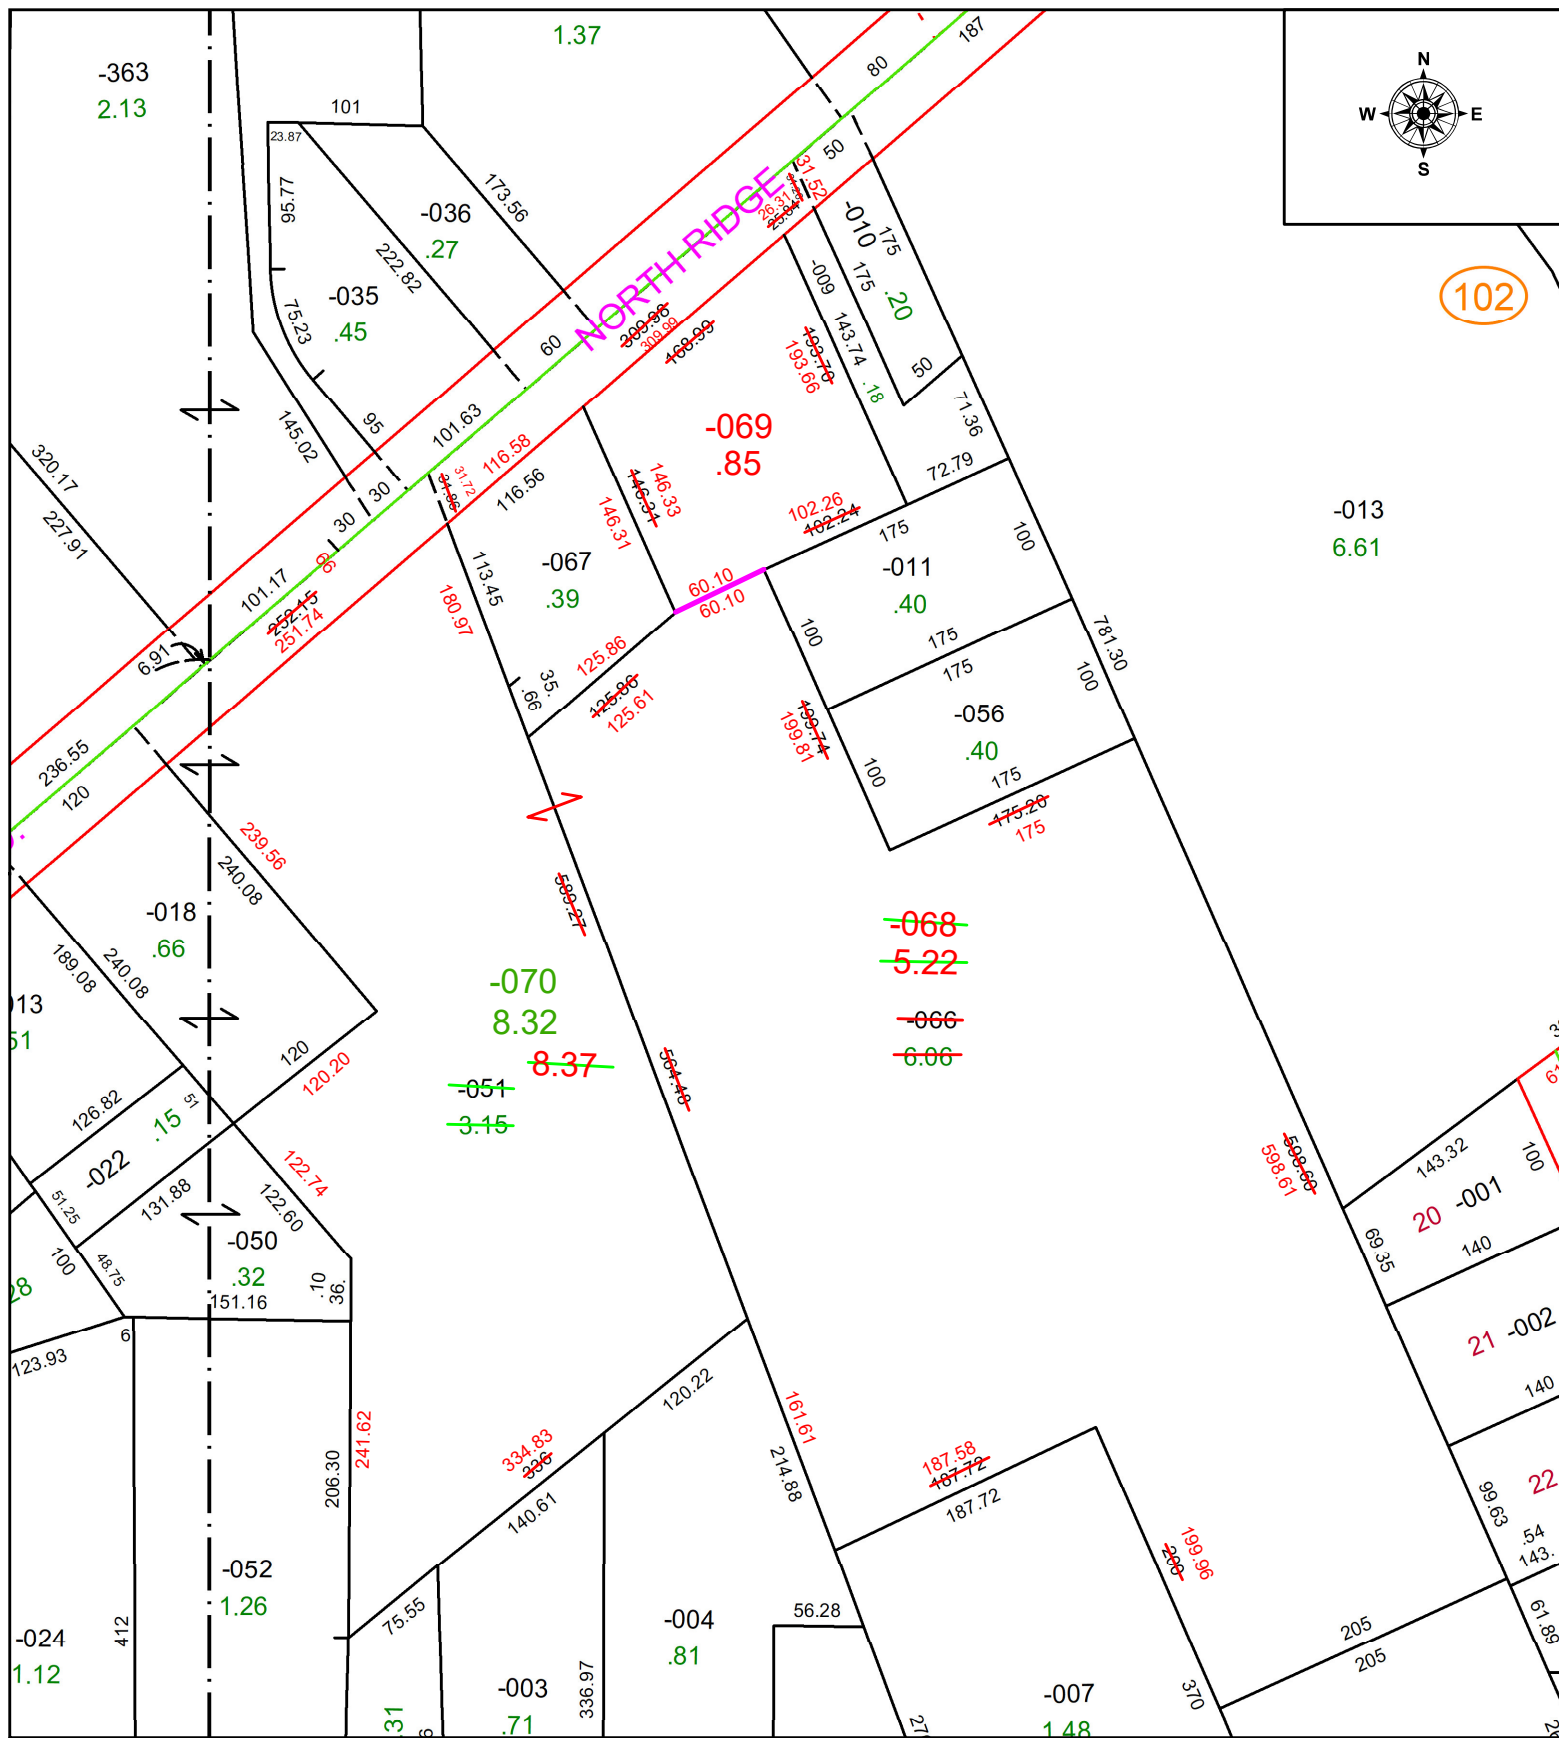

102

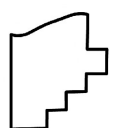

SPLITS/DEEDS PROCESSED
 LORAIN COUNTY TAX MAP DEPARTMENT
 226 MIDDLE AVE. ELYRIA, OH

SURVEYED BY: PATRICK MCGANNON SURVEY # 50609
 CLOSURE: 1:324335
 MAP PAGE(S): 02-01-007
 APPROVED BY: WRZ DATE: 6/15/2022
 SCALE: 1" = 125 PRIOR INSTRUMENT: 2021-0853876