
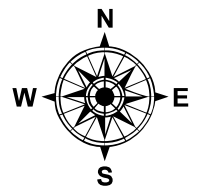


PARENT PARCEL: 04-00-027-101-182

CHILD PARCEL: 04-00-027-101-203 & -204

STARTING POINT: CL OF NAGEL RD. & MIDDLETON RD.

22-04508

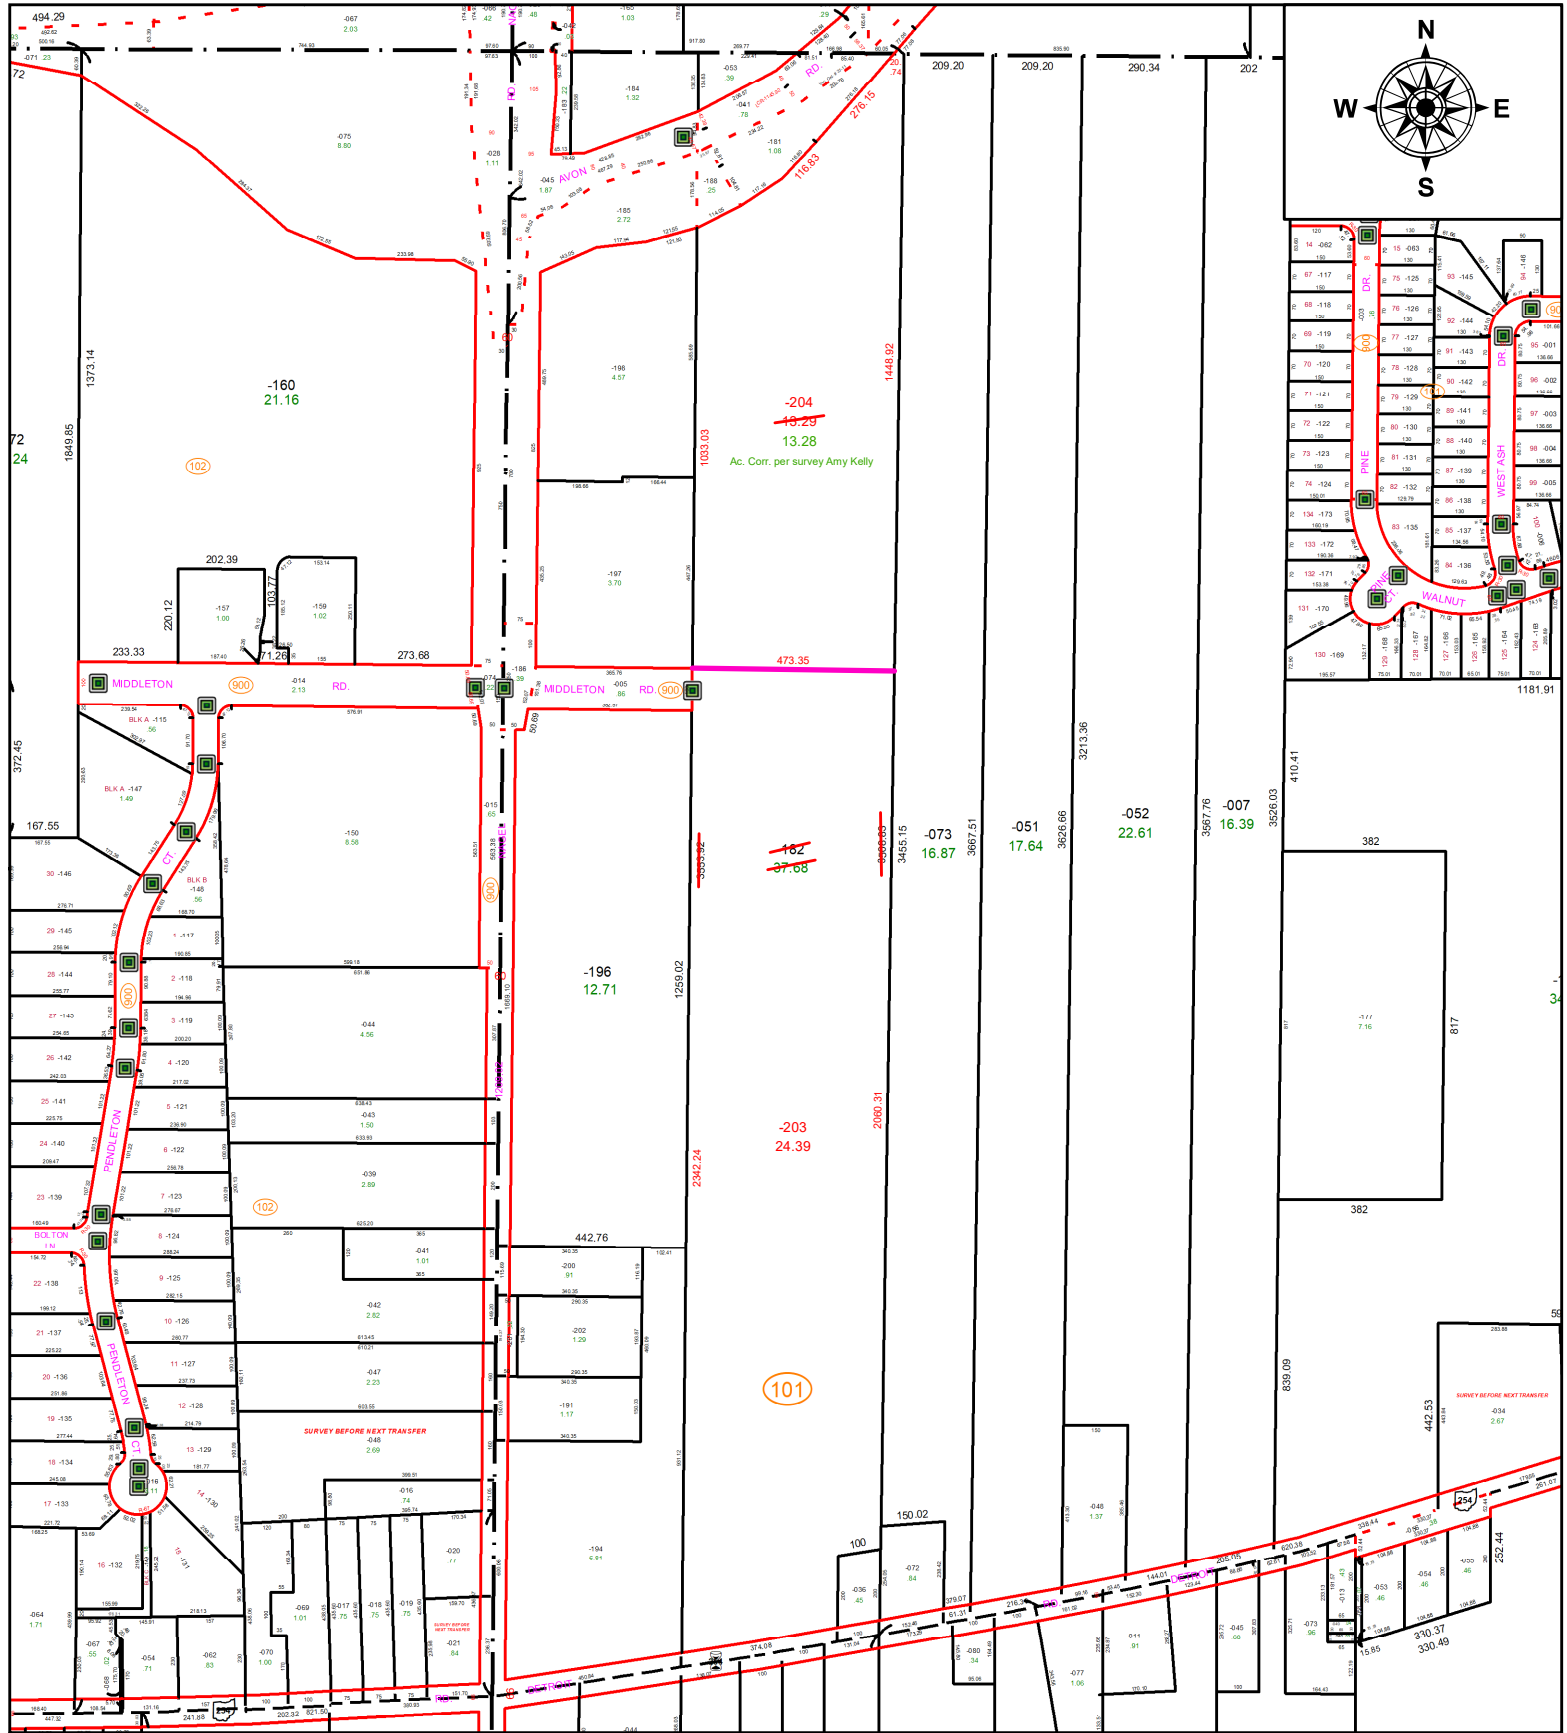

SPLITS/DEEDS PROCESSED
 LORAIN COUNTY TAX MAP DEPARTMENT
 226 MIDDLE AVE. ELYRIA, OH

SURVEYED BY: AMY KELLY
CLOSURE: 1: 1918367
MAP PAGE(S): 04-00-027
APPROVED BY: DMA **DATE:** 6/16/2022
SCALE: 1" = 450' **PRIOR INSTRUMENT:** 2017-0655261