


PARENT PARCEL: 04-00-022-102-073

CHILD PARCEL: 04-00-022-102-161 & -162

ACREAGE CORRECTION PER MICHAEL SPELLACY


22-04511

STARTING POINT: INTERSECTION OF C/LS NAGEL RD & DETROIT RD

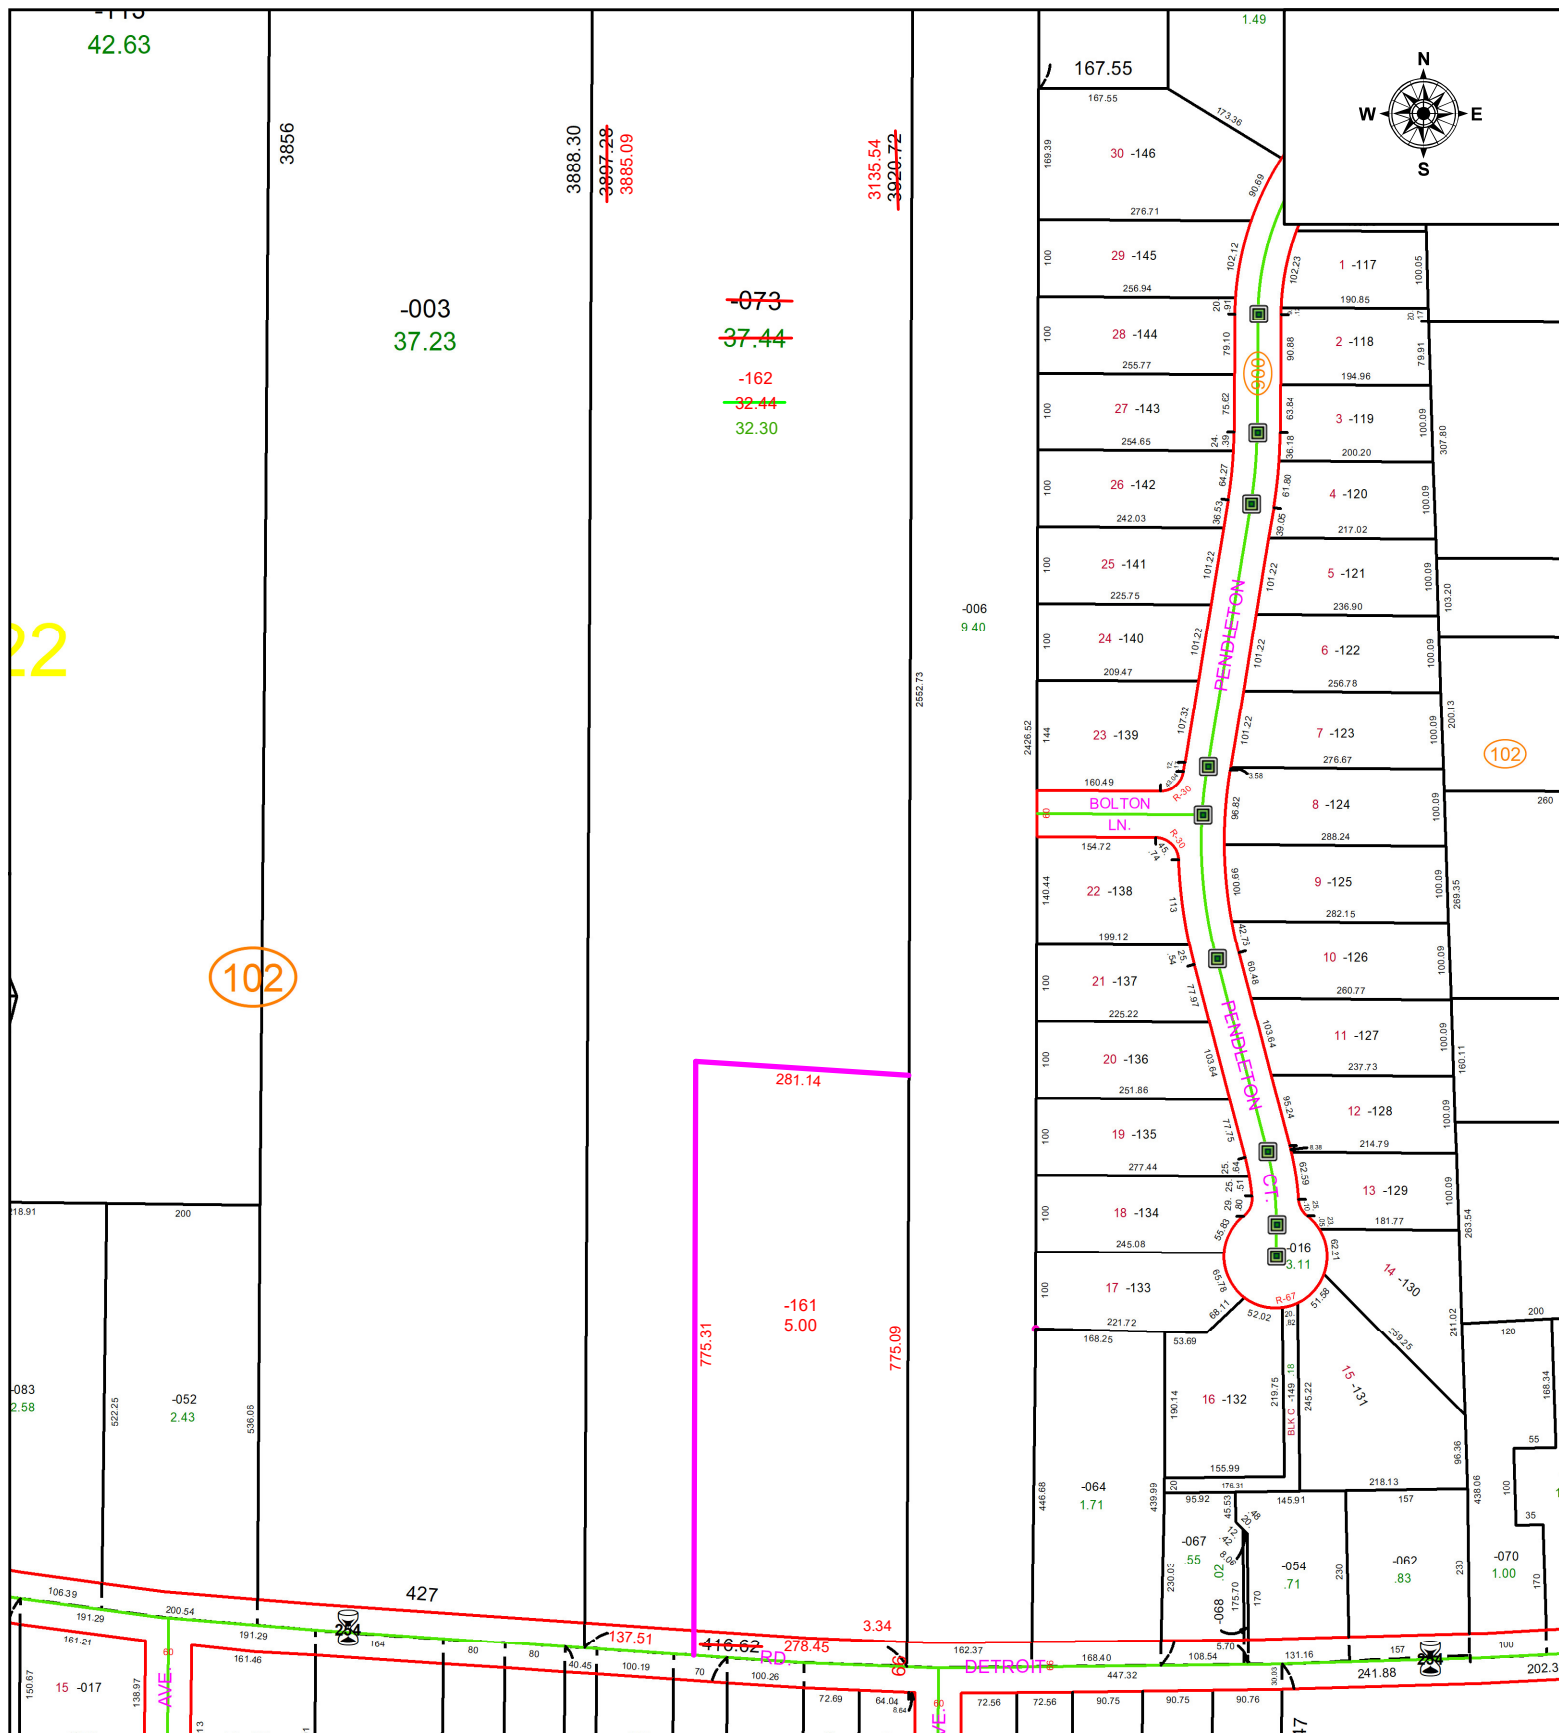

102

102

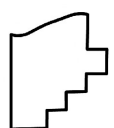

SPLITS/DEEDS PROCESSED
 LORAIN COUNTY TAX MAP DEPARTMENT
 226 MIDDLE AVE. ELYRIA, OH

SURVEYED BY: MICHAEL SPELLACY **SURVEY #** 50618
CLOSURE: 1: 297477
MAP PAGE(S): 04-00-022
APPROVED BY: WRZ **DATE:** 6/28/2022
SCALE: 1" = 250 **PRIOR INSTRUMENT:** 2012-0406758