
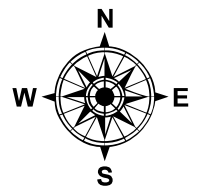


PARENT PARCEL: 09-00-086-103-036

CHILD PARCEL:

21-04512-A

STARTING POINT: NORTHEAST CORNER OF VILLAGE LOT 190 IN ORIGINAL PLAT OF OBERLIN

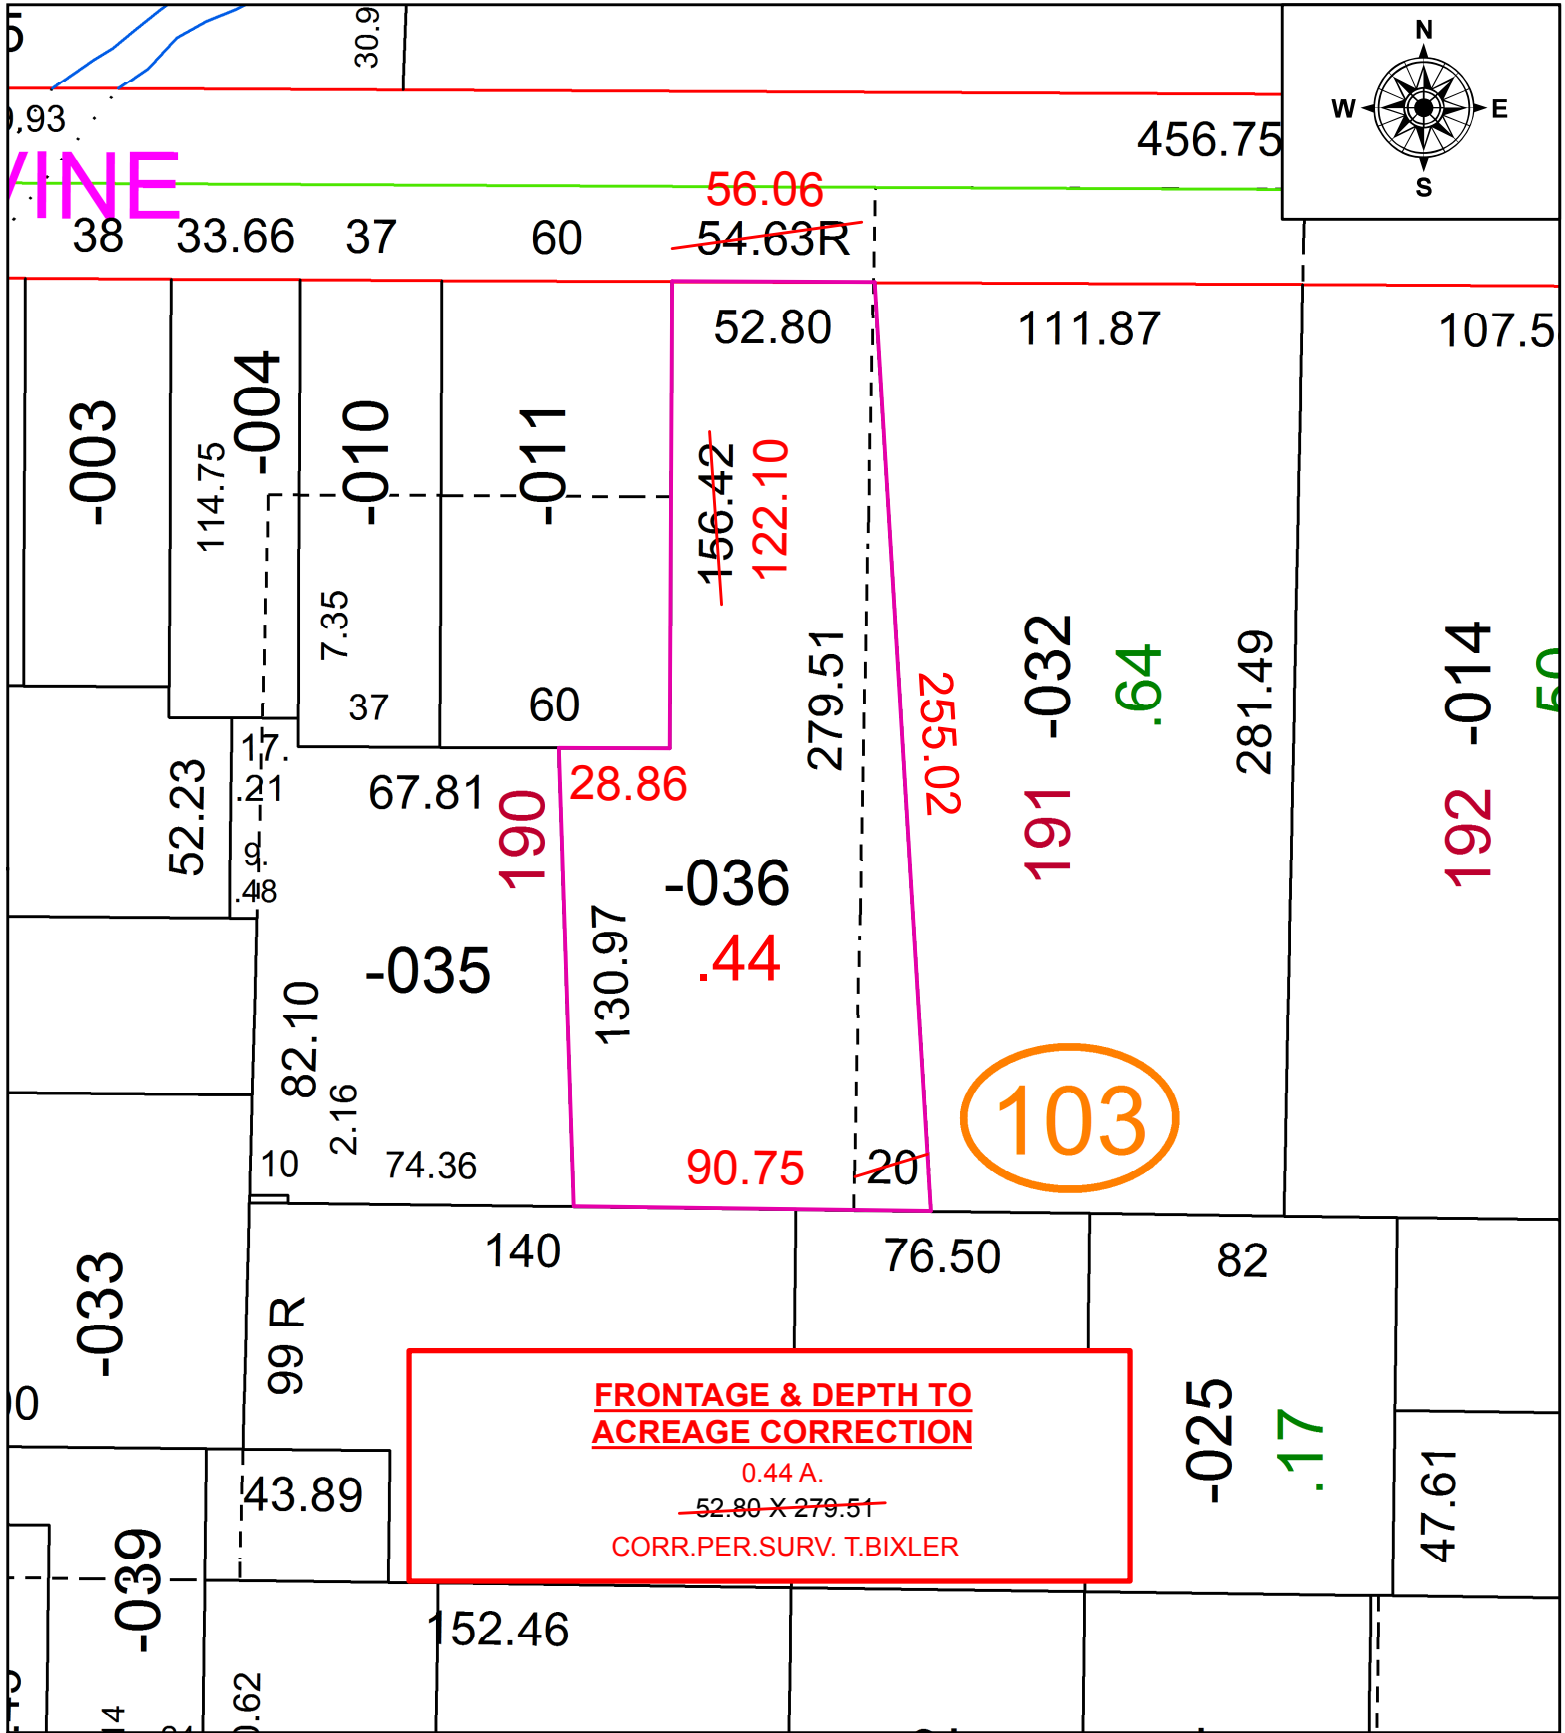

SPLITS/DEEDS PROCESSED
 LORAIN COUNTY TAX MAP DEPARTMENT
 226 MIDDLE AVE. ELYRIA, OH

SURVEYED BY: TREVOR A. BIXLER
 CLOSURE: 1:50,157
 MAP PAGE(S): 9-00-086
 APPROVED BY: RRM DATE: 3-31-21
 SCALE: 1" = 50 PRIOR INSTRUMENT: 20090299333