
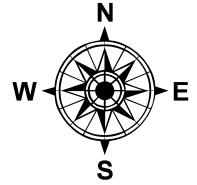


PARENT PARCEL: 05-00-048-000-009, 05-00-048-000-073

CHILD PARCEL: 05-00-048-000-079, -080, -081

STARTING POINT: C/L OF LEAVITT RD AND SR 113

22-04512

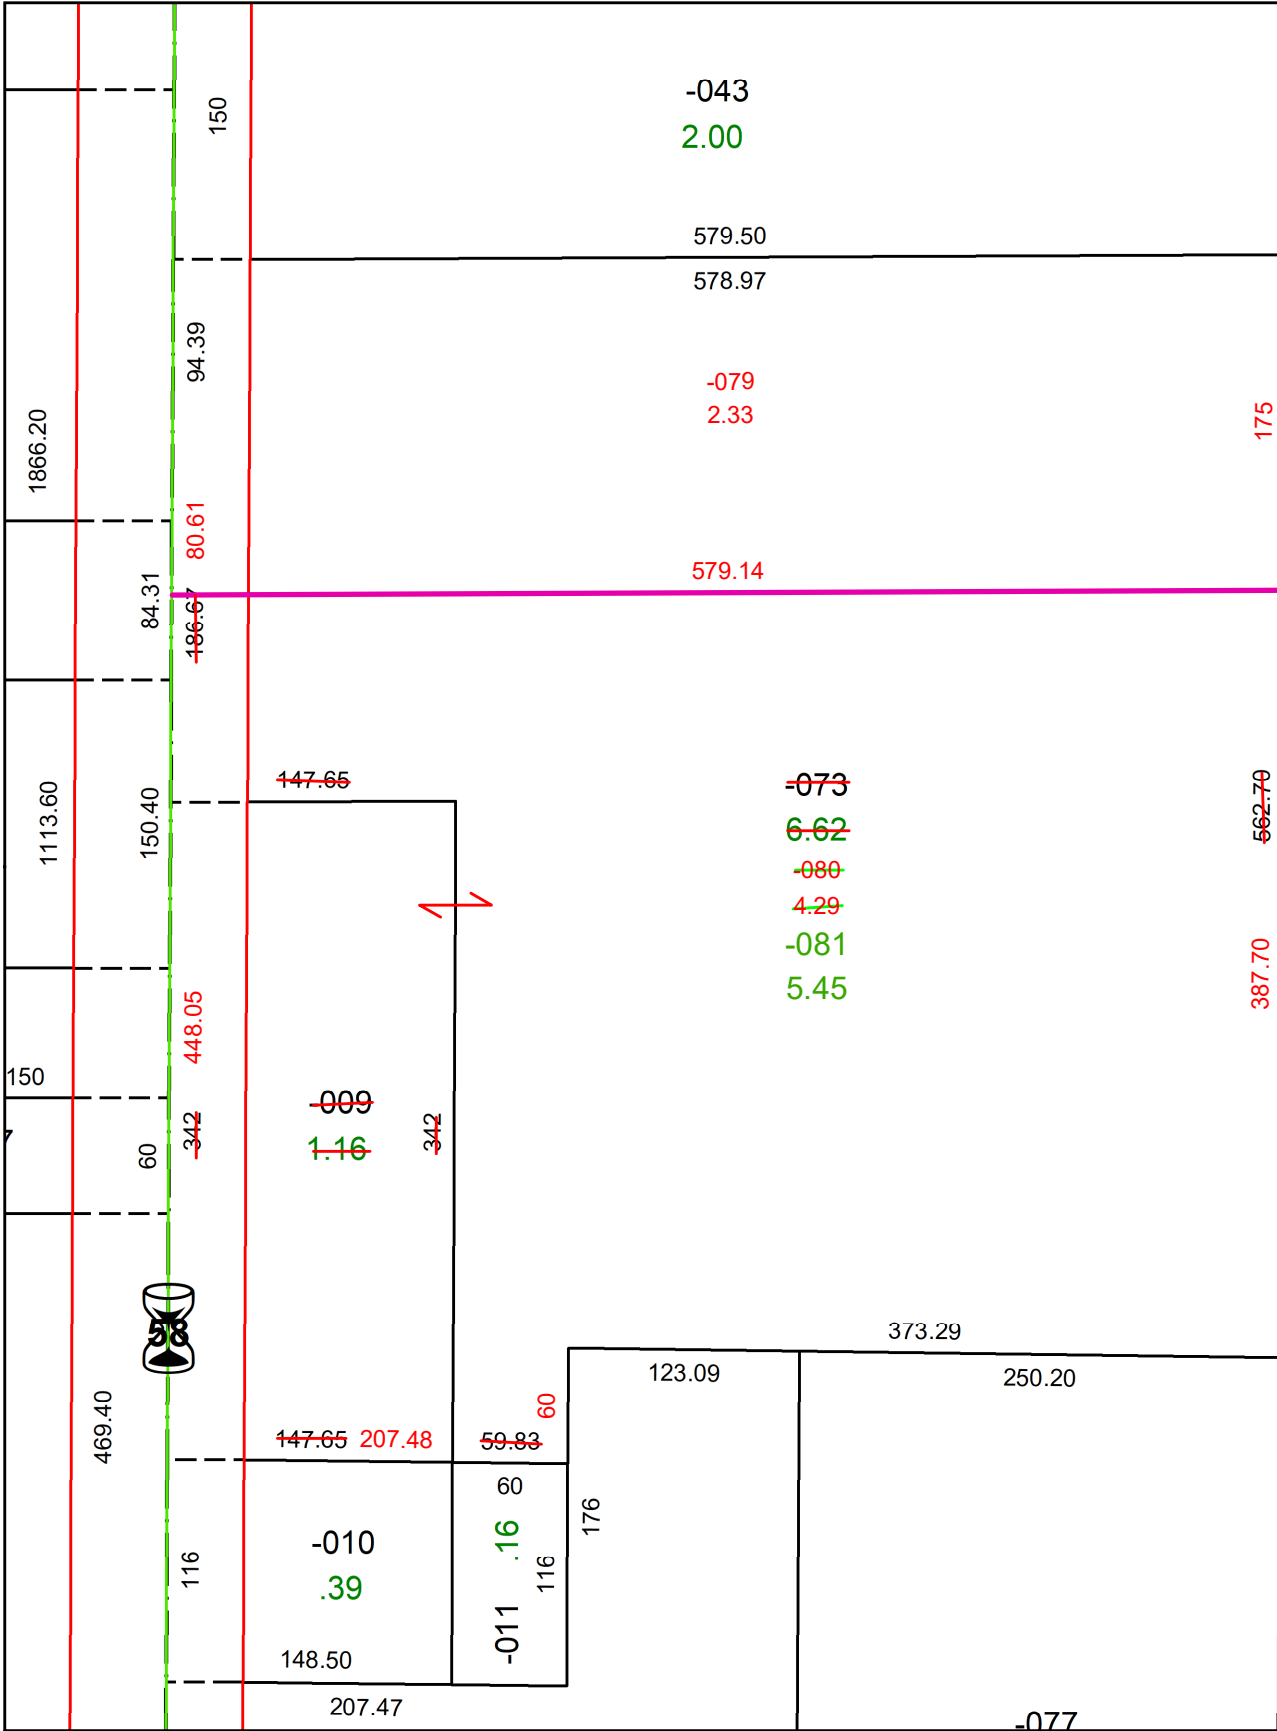

SPLITS/DEEDS PROCESSED
 LORAIN COUNTY TAX MAP DEPARTMENT
 226 MIDDLE AVE. ELYRIA, OH

SURVEYED BY: THOMAS A. SIMON
 CLOSURE: 1: 633270
 MAP PAGE(S): 05-00-048
 APPROVED BY: AC DATE: June 28, 2022
 SCALE: 1" = 100 PRIOR INSTRUMENT: 2014- 0517550