



PARENT PARCEL: 15-00-098-108-178 & -296

CHILD PARCEL: 15-00-098-108-301, -302, & -303

N/A

22-04513


STARTING POINT: SOUTHEASTERLY CORNER OF S/L 478 IN PHEASANT RUN VILLAGE PHASE NO. 1

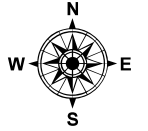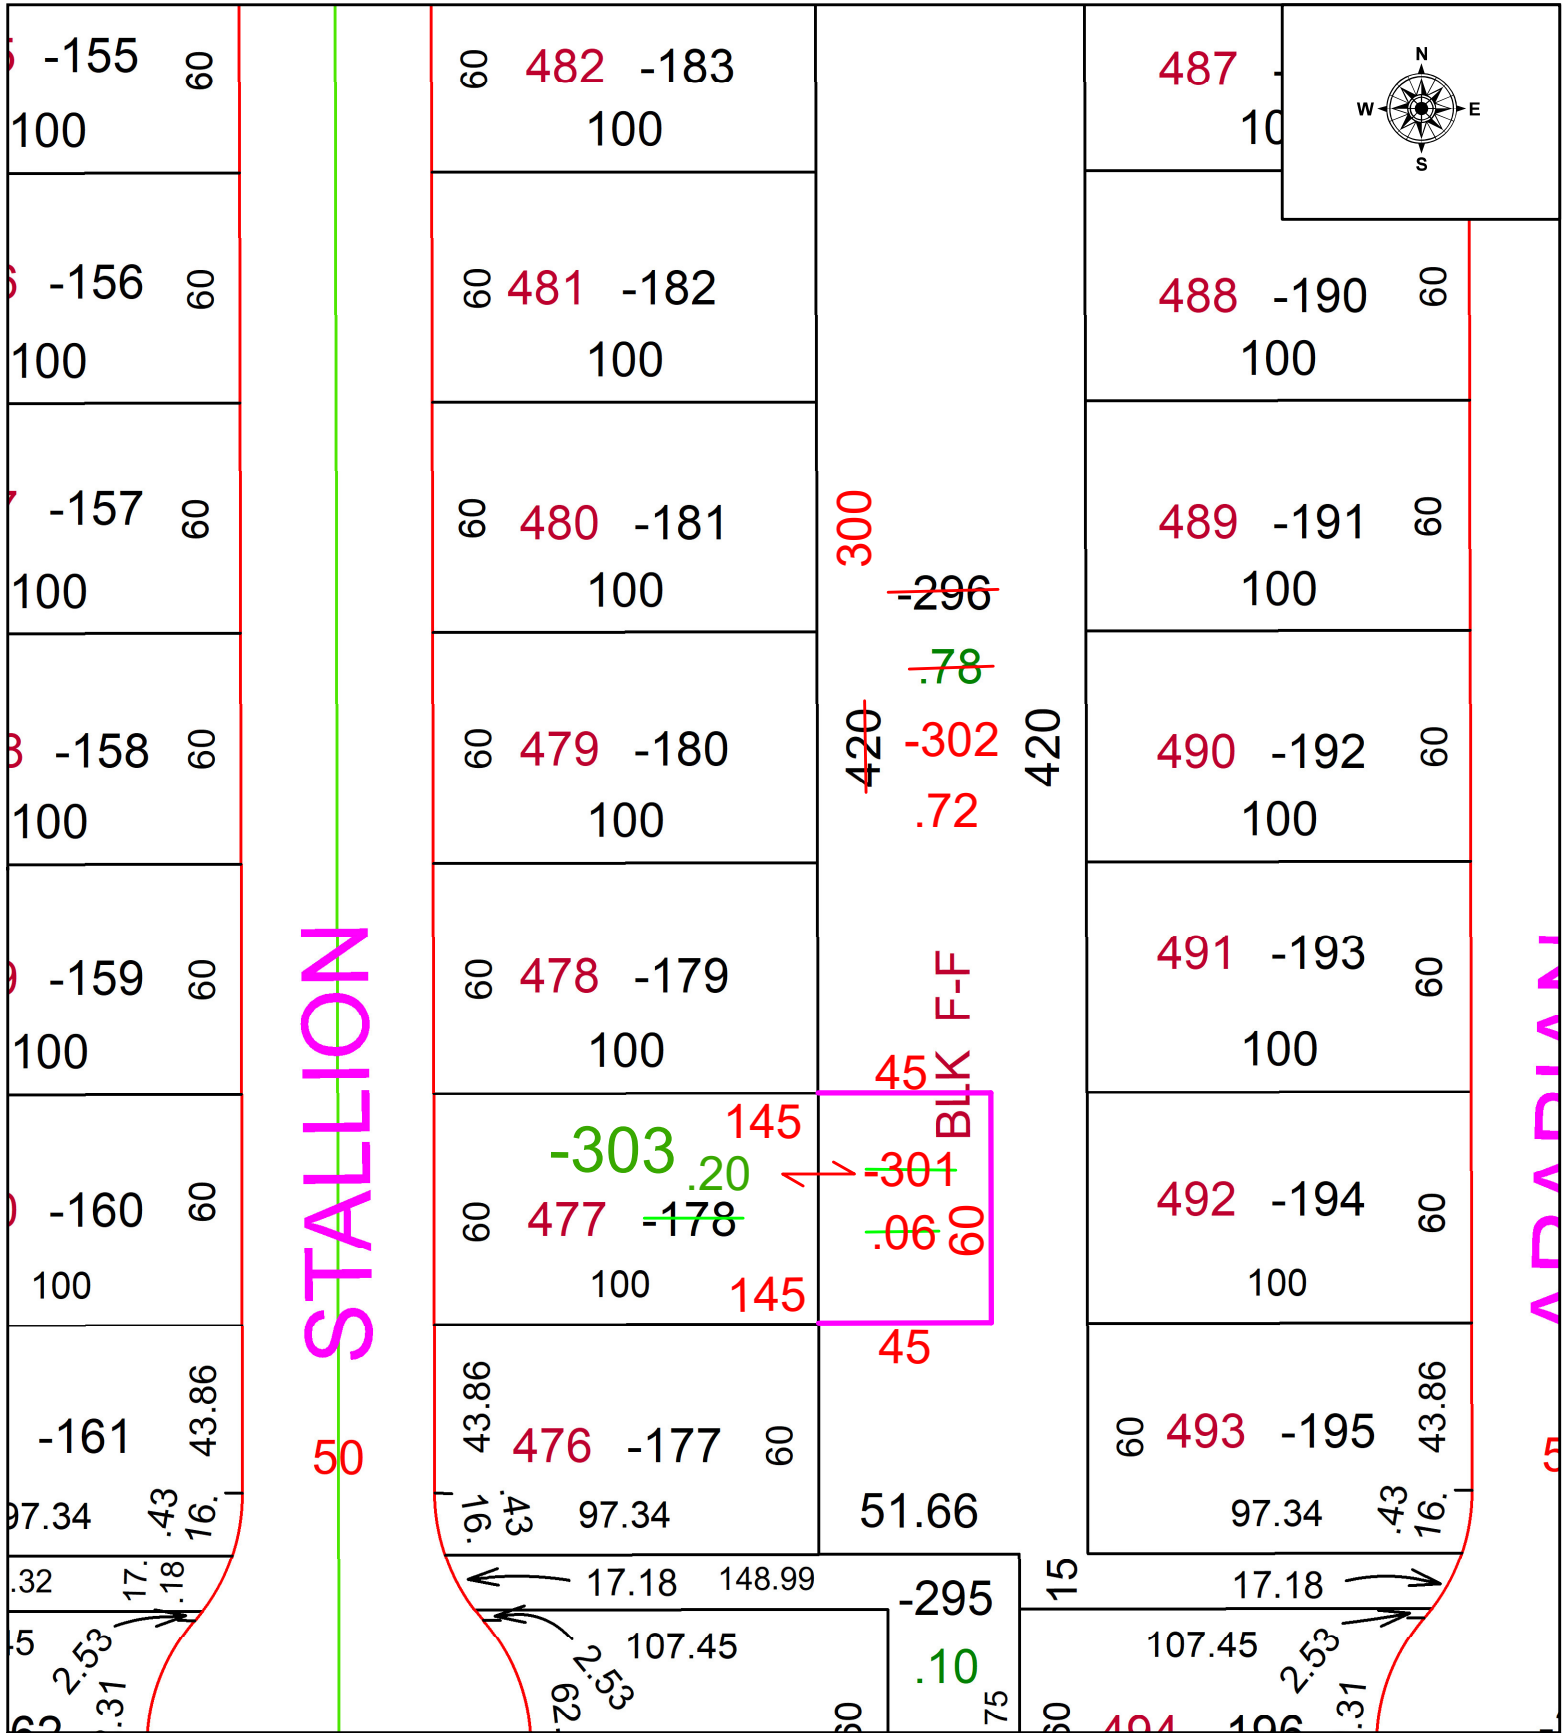

STALLION

50

BLK F-F

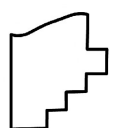

SPLITS/DEEDS PROCESSED
 LORAIN COUNTY TAX MAP DEPARTMENT
 226 MIDDLE AVE. ELYRIA, OH

SURVEYED BY: THOMAS SIMON SURVEY # 50681
 CLOSURE: 1: -2147483648
 MAP PAGE(S): 15-00-098
 APPROVED BY: WRZ DATE: 8/29/2022
 SCALE: 1" = 25' PRIOR INSTRUMENT: 2020-0745249