


PARENT PARCEL: 01-00-053-000-037 & -039

CHILD PARCEL: 01-00-053-000-042 THRU -044

STARTING POINT: CL OF CLAUD RD. & NORTHLINE OF O.L. 53

22-04518

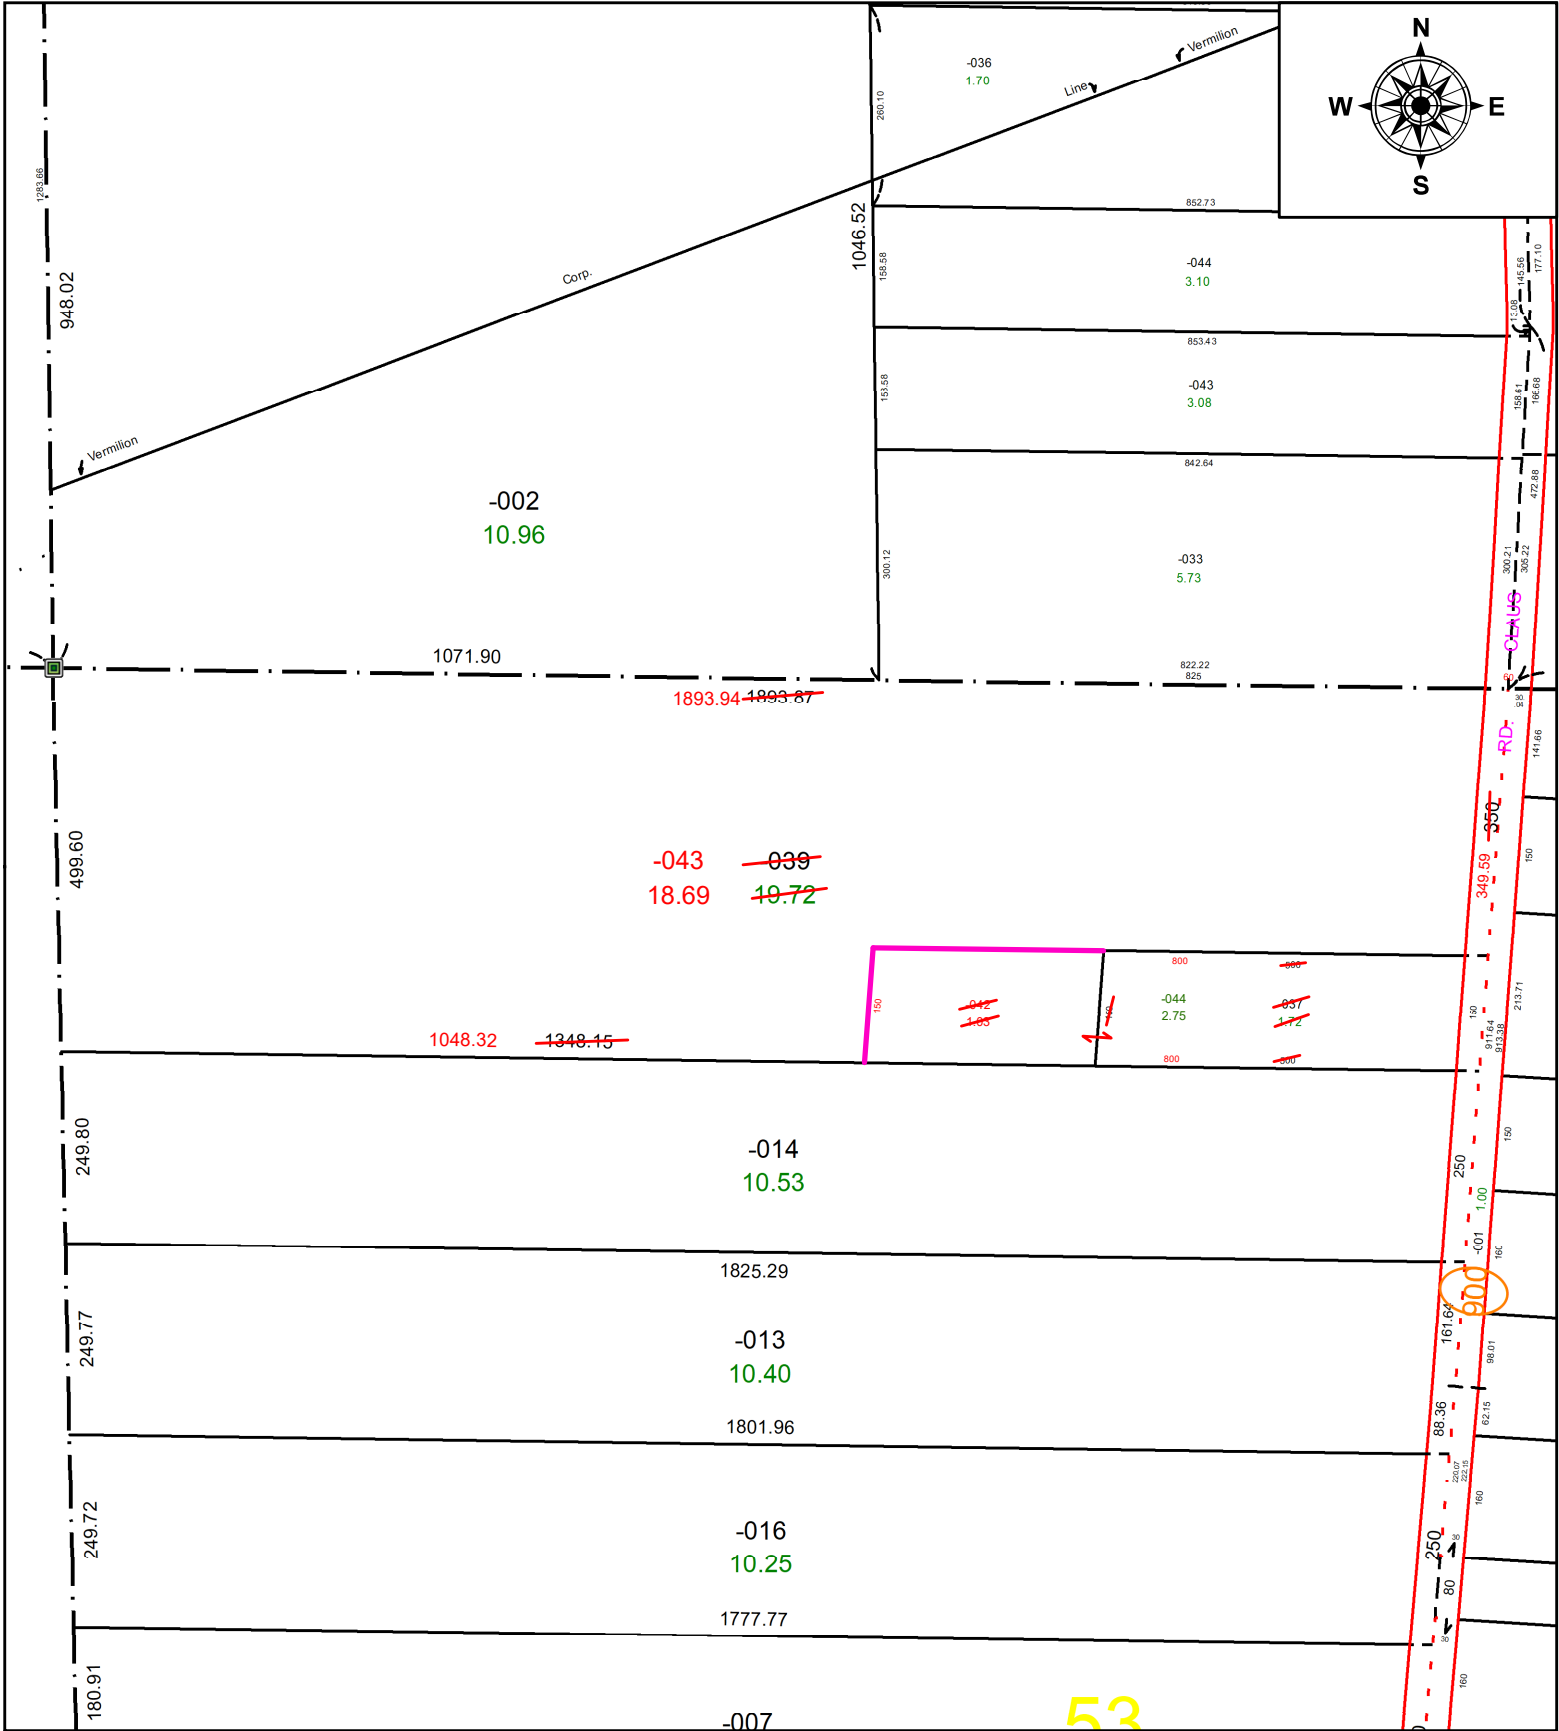

SPLITS/DEEDS PROCESSED
 LORAIN COUNTY TAX MAP DEPARTMENT
 226 MIDDLE AVE. ELYRIA, OH

SURVEYED BY: PATRICK McGANNON

CLOSURE: 1:-2147483648

MAP PAGE(S): 01-00-053

APPROVED BY: DMA **DATE:** 7/1/2022

SCALE: 1" = 250' **PRIOR INSTRUMENT:** 1999-0640867

53