
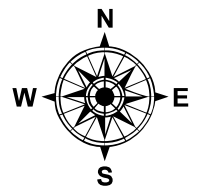


PARENT PARCEL: 07-00-043-103-099 & -100


CHILD PARCEL: 07-00-043-103-107, -108 & -109

STARTING POINT: CL OF CASE RD. & S.W. CORNER AVALON ESTATES # 1 P.V. 71 PG. 10.

22-04519

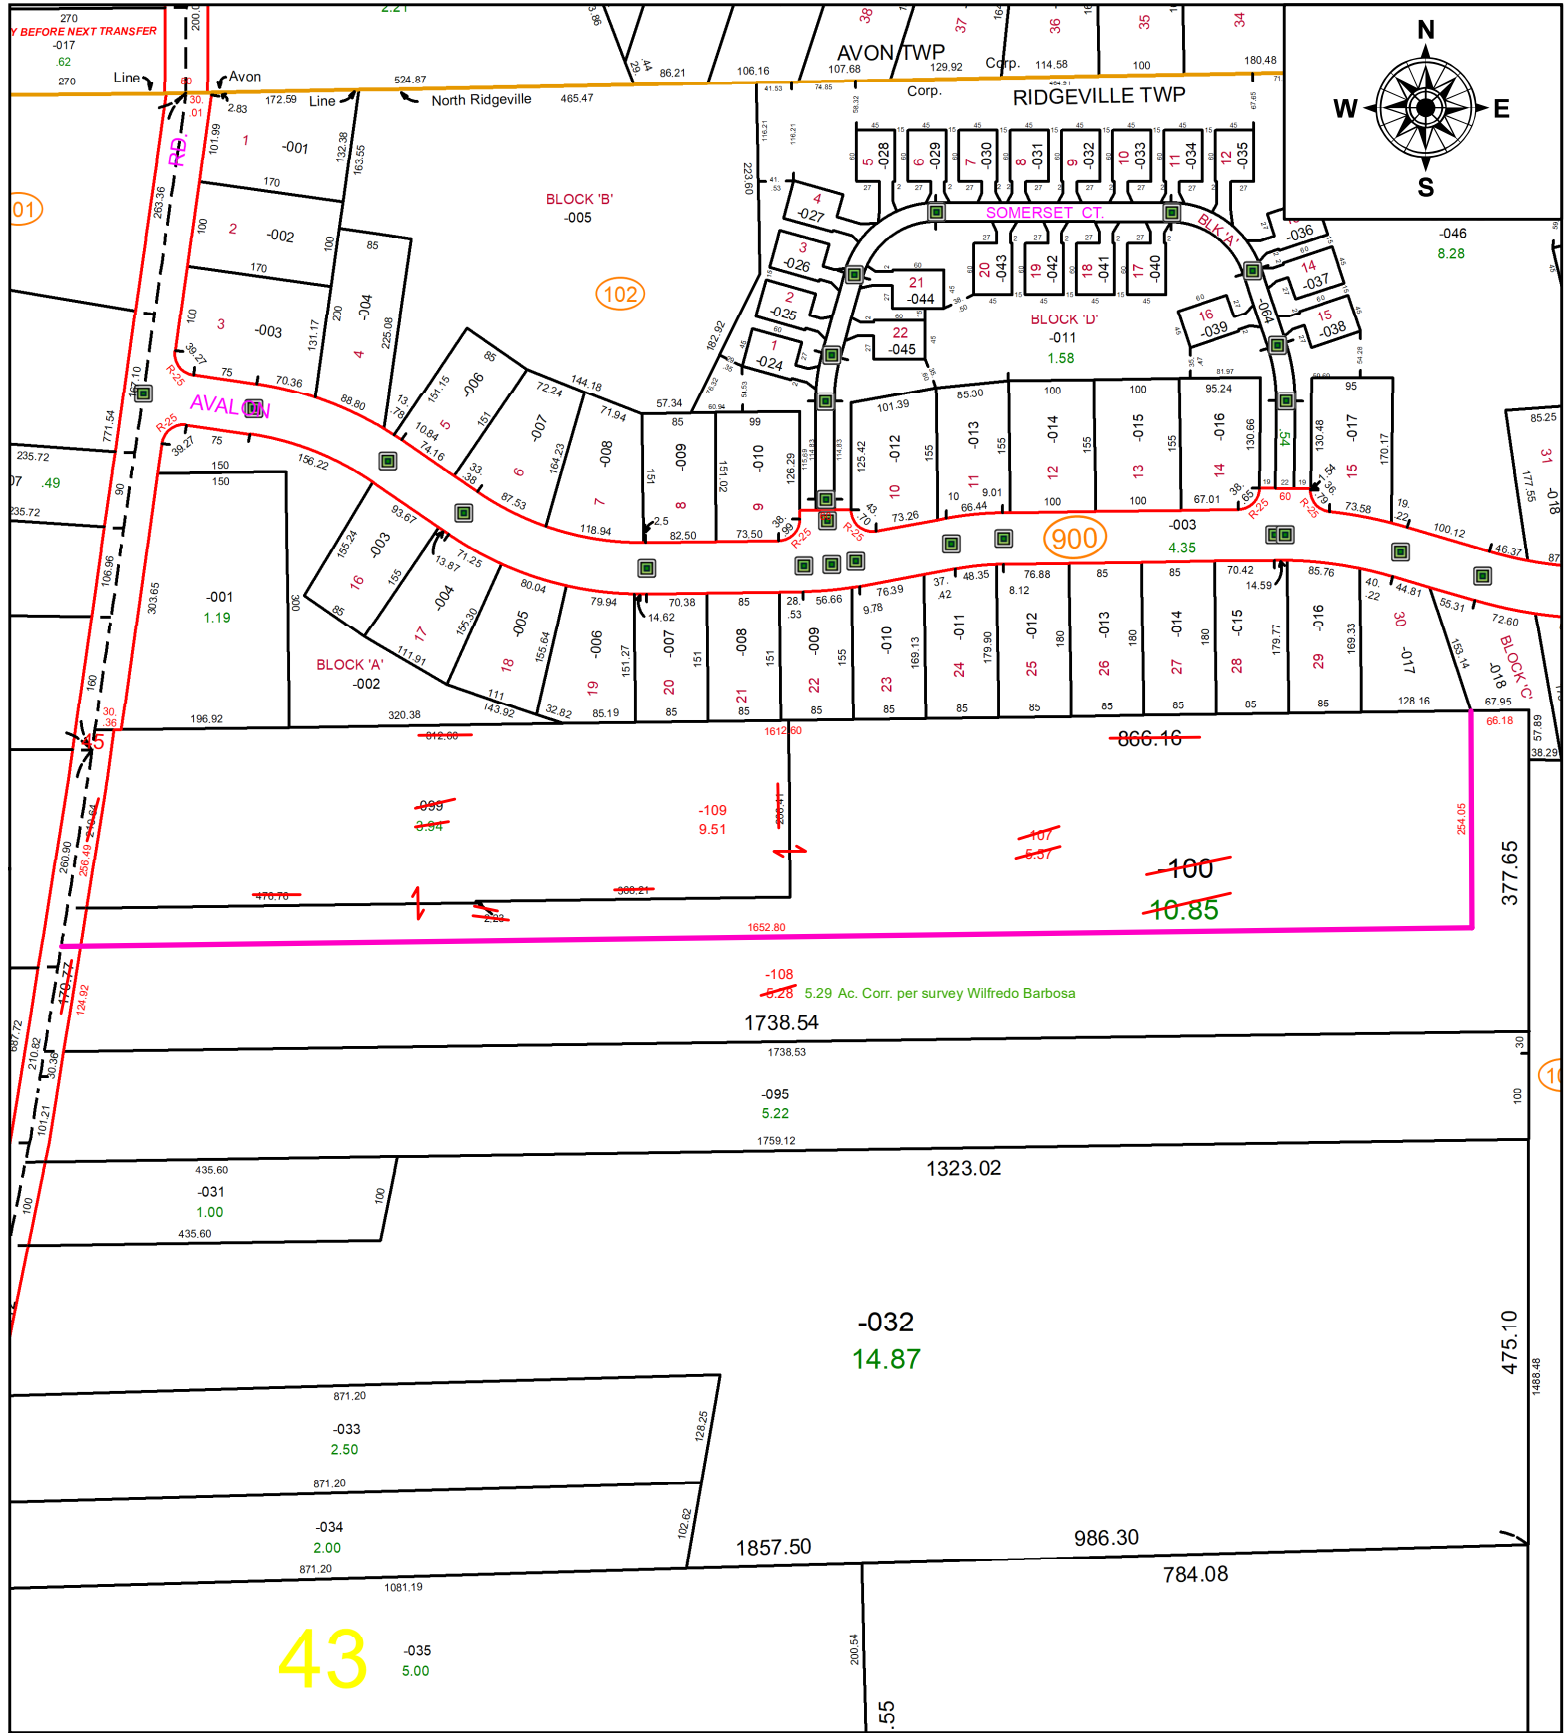

43

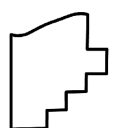

**SPLITS/DEEDS PROCESSED**  
 LORAIN COUNTY TAX MAP DEPARTMENT  
 226 MIDDLE AVE. ELYRIA, OH

**SURVEYED BY:** WILFREDO BARBOSA  
**CLOSURE:** 1: 33,000  
**MAP PAGE(S):** 07-00-043  
**APPROVED BY:** DMA **DATE:** 7/5/2022  
**SCALE:** 1" = 225' **PRIOR INSTRUMENT:** 2017-0646737