
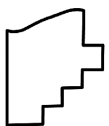


PARENT PARCEL: 11-00-008-000-059, -060

CHILD PARCEL: 11-00-008-000-070

STARTING POINT: C/L OF HAWKE RD AND E LINE OF O/L 8

22-04520

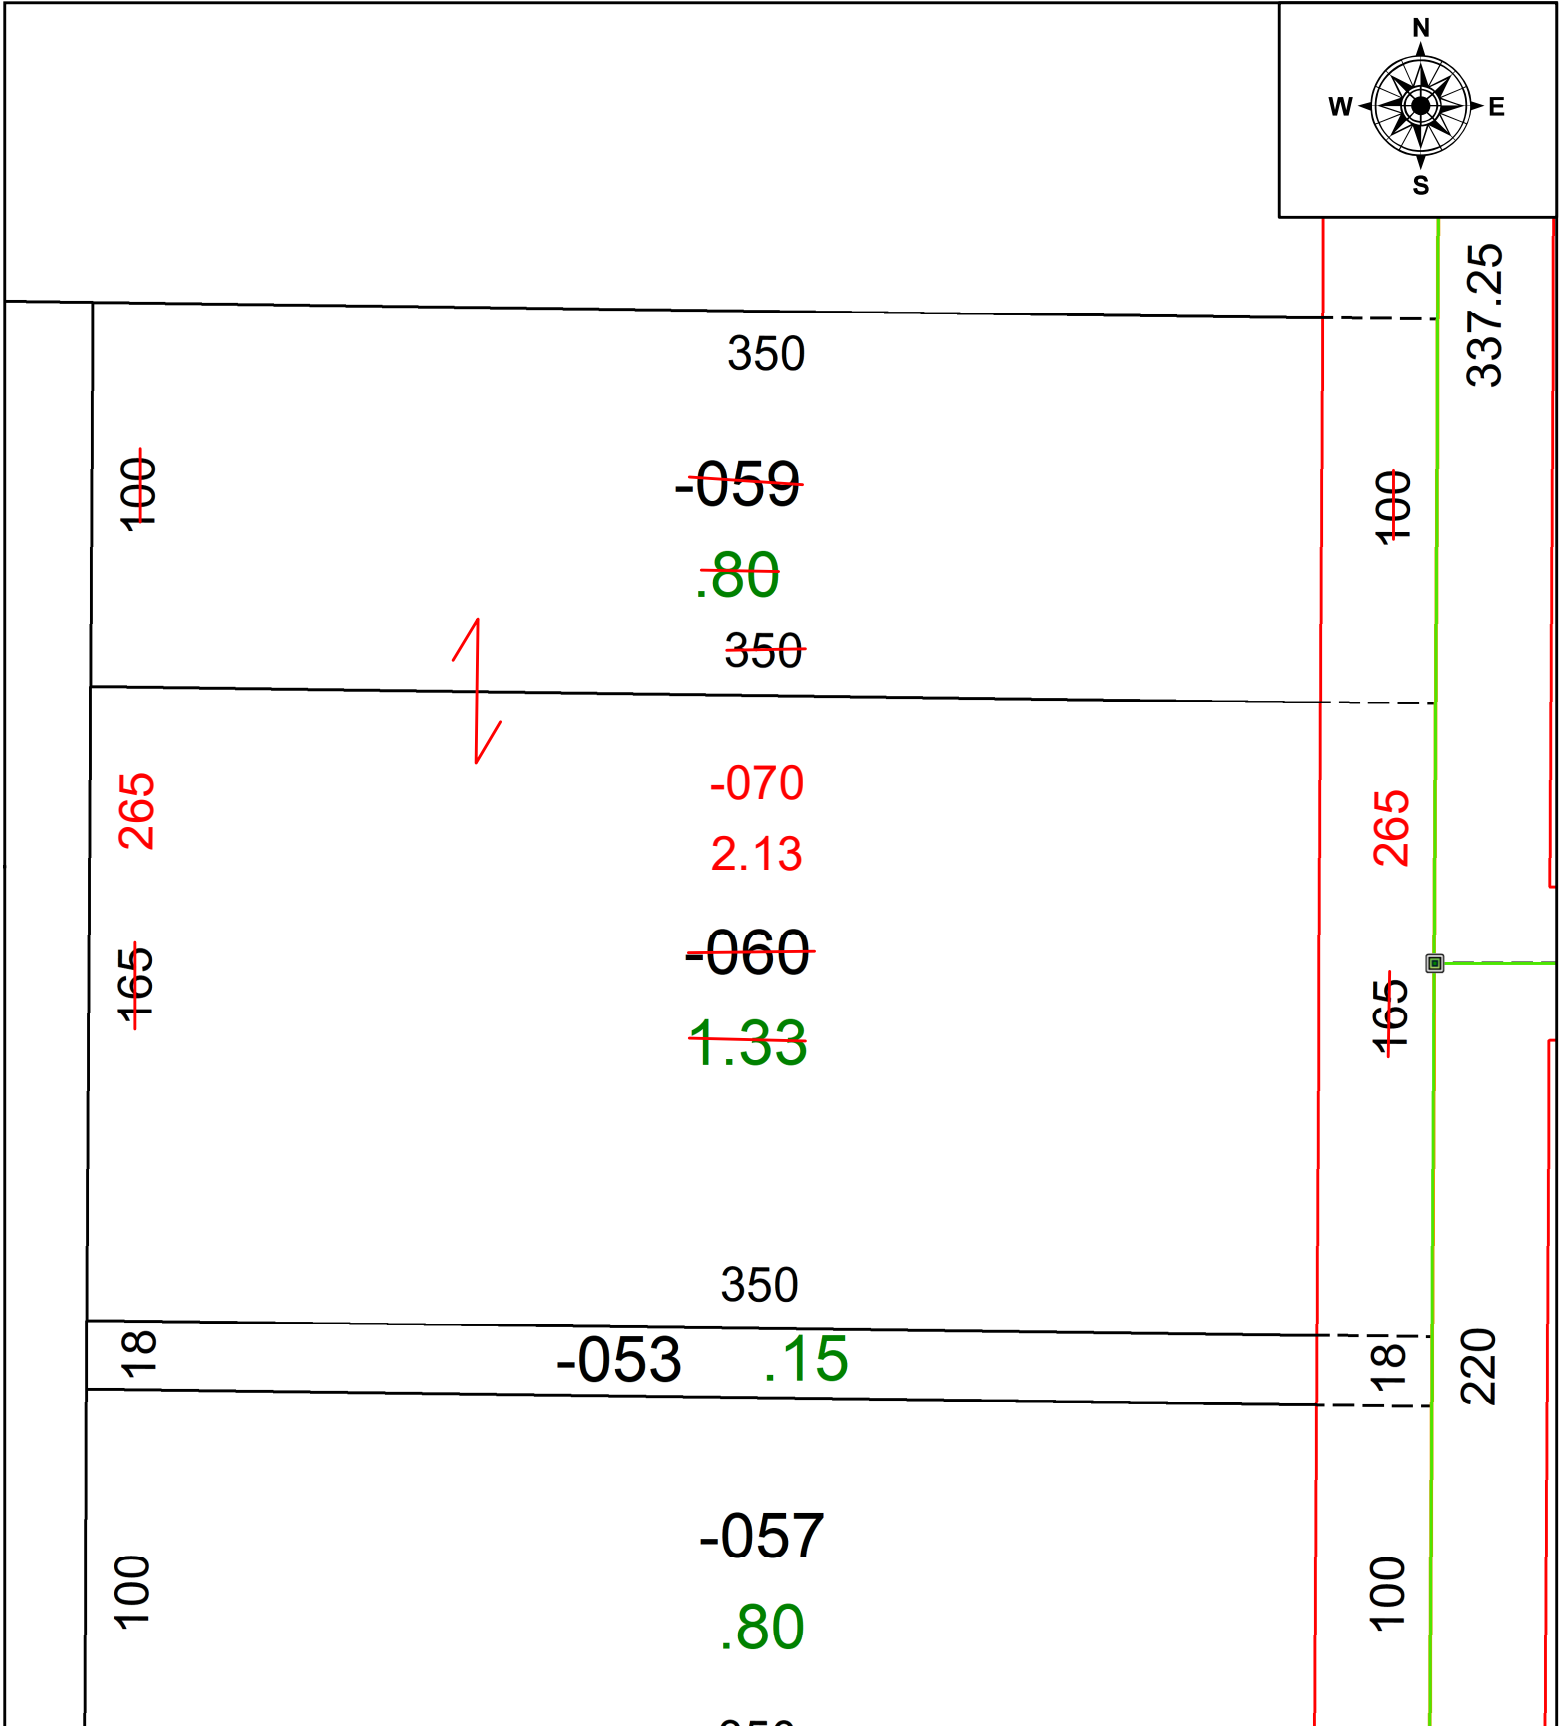

SPLITS/DEEDS PROCESSED
 LORAIN COUNTY TAX MAP DEPARTMENT
 226 MIDDLE AVE. ELYRIA, OH

SURVEYED BY: _____ N/A
 CLOSURE: _____ N/A
 MAP PAGE(S): 11-00-008-B
 APPROVED BY: _____ AC DATE: July 06, 2022
 SCALE: 1" = 50' PRIOR INSTRUMENT: 1988-0016472