


PARENT PARCEL: 07-00-029-000-056 & -444

CHILD PARCEL: 07-00-029-000-514, -515, & -516

N/A

22-04522

STARTING POINT: INTERSECTION OF MONUMENT BOX @ C/L OF S.R. 83 & SOUTHEASTERLY CORNER OF O.L. 29

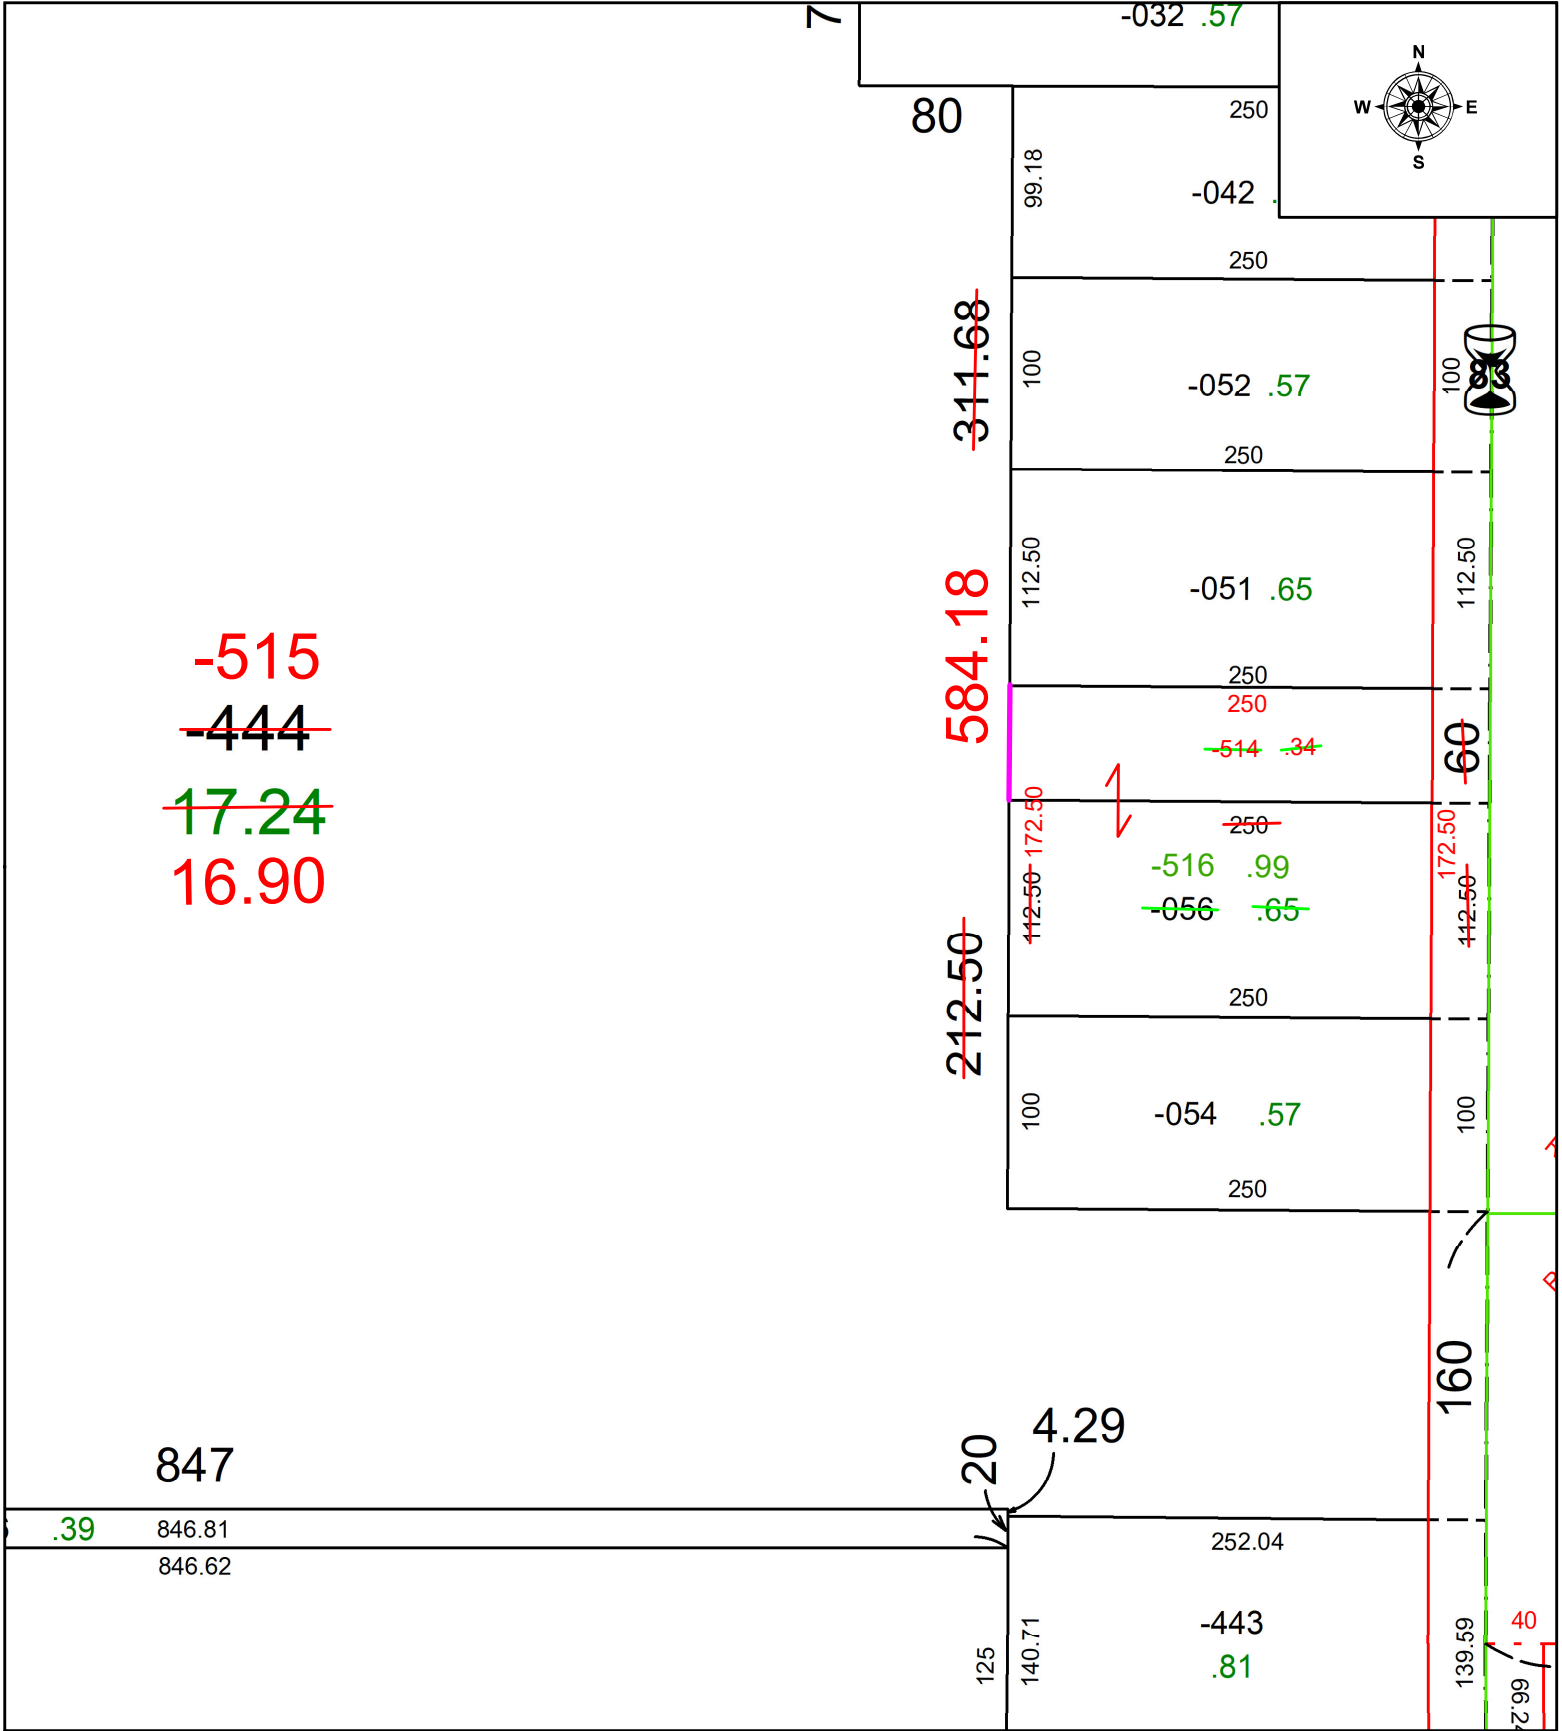

~~-515~~

~~-444~~

~~17.24~~

16.90

~~311.68~~

584.18

~~212.50~~

847

.39

846.81

846.62

SURVEYED BY: AMY KELLY


SURVEY # 50637

CLOSURE: 1: -2147483648

MAP PAGE(S): 07-00-029

APPROVED BY: WRZ DATE: 7/13/2022

SCALE: 1" = 100 PRIOR INSTRUMENT: 2021-0851350

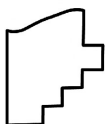

SPLITS/DEEDS PROCESSED
 LORAIN COUNTY TAX MAP DEPARTMENT
 226 MIDDLE AVE. ELYRIA, OH