


PARENT PARCEL: 05-00-045-000-061 & -091

CHILD PARCEL: 05-00-045-000-093 *05-00-044-000-036 STR. TRNS.

STARTING POINT: CL OF DEWEY RD. & RE-LOCATED MIDDLE RIDGE RD.

22-04523

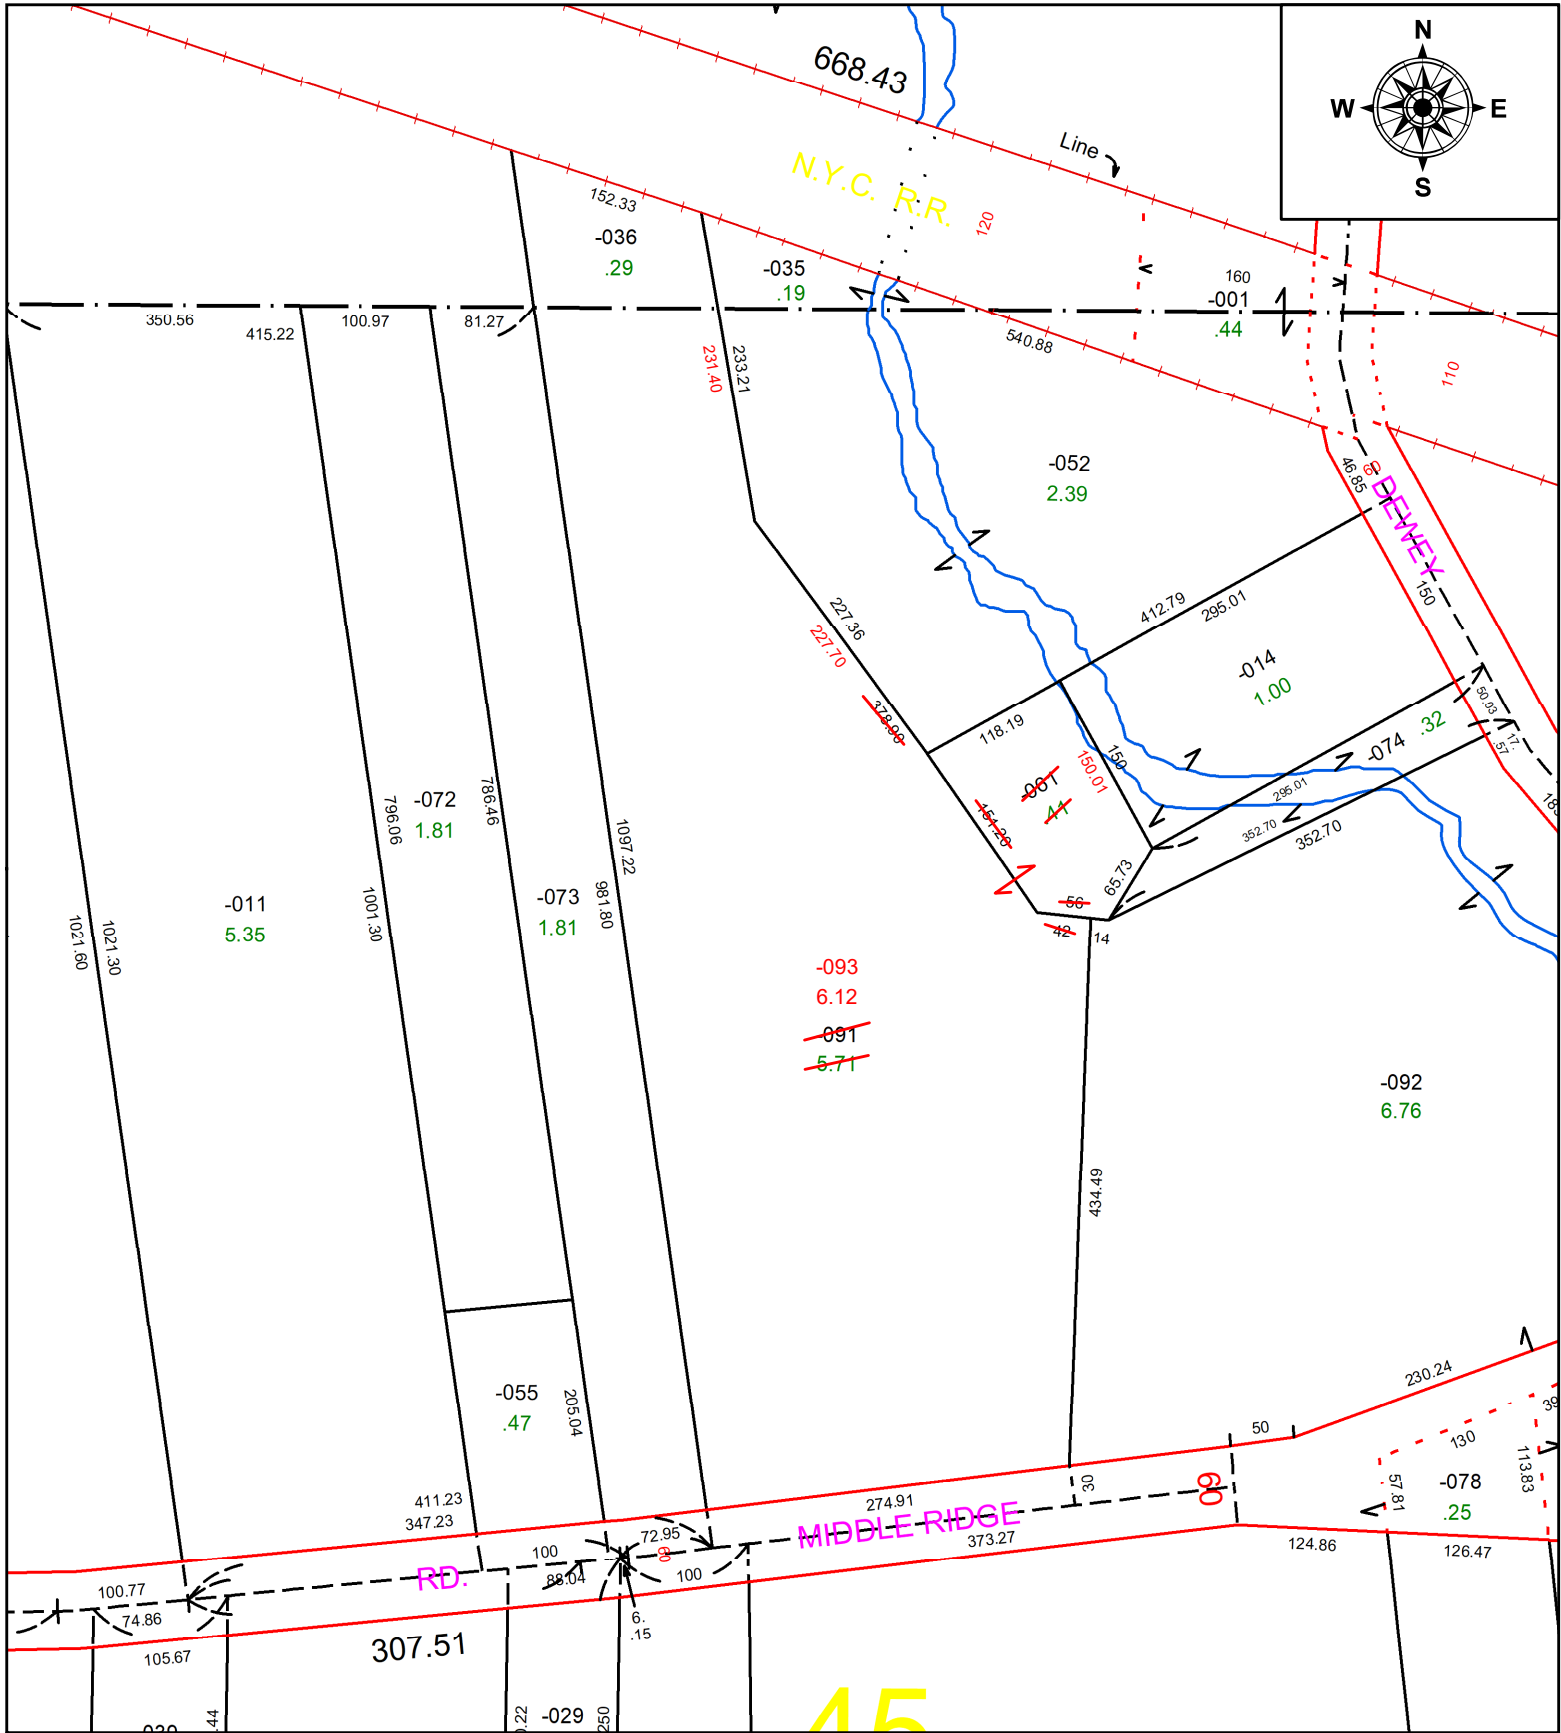

SPLITS/DEEDS PROCESSED
 LORAIN COUNTY TAX MAP DEPARTMENT
 226 MIDDLE AVE. ELYRIA, OH

SURVEYED BY: THOMAS SIMON
 CLOSURE: 1:14269513
 MAP PAGE(S): 05-00-045
 APPROVED BY: DMA DATE: 7/12/2022
 SCALE: 1" = 150' PRIOR INSTRUMENT: 2018-0672389