


PARENT PARCEL: 02-01-003-267-007

CHILD PARCEL:

21-04524-D

STARTING POINT: INTERSECTION OF C/L OF COTTONWOOD DR, AND C/L OF COOPER FOSTER PARK RD.

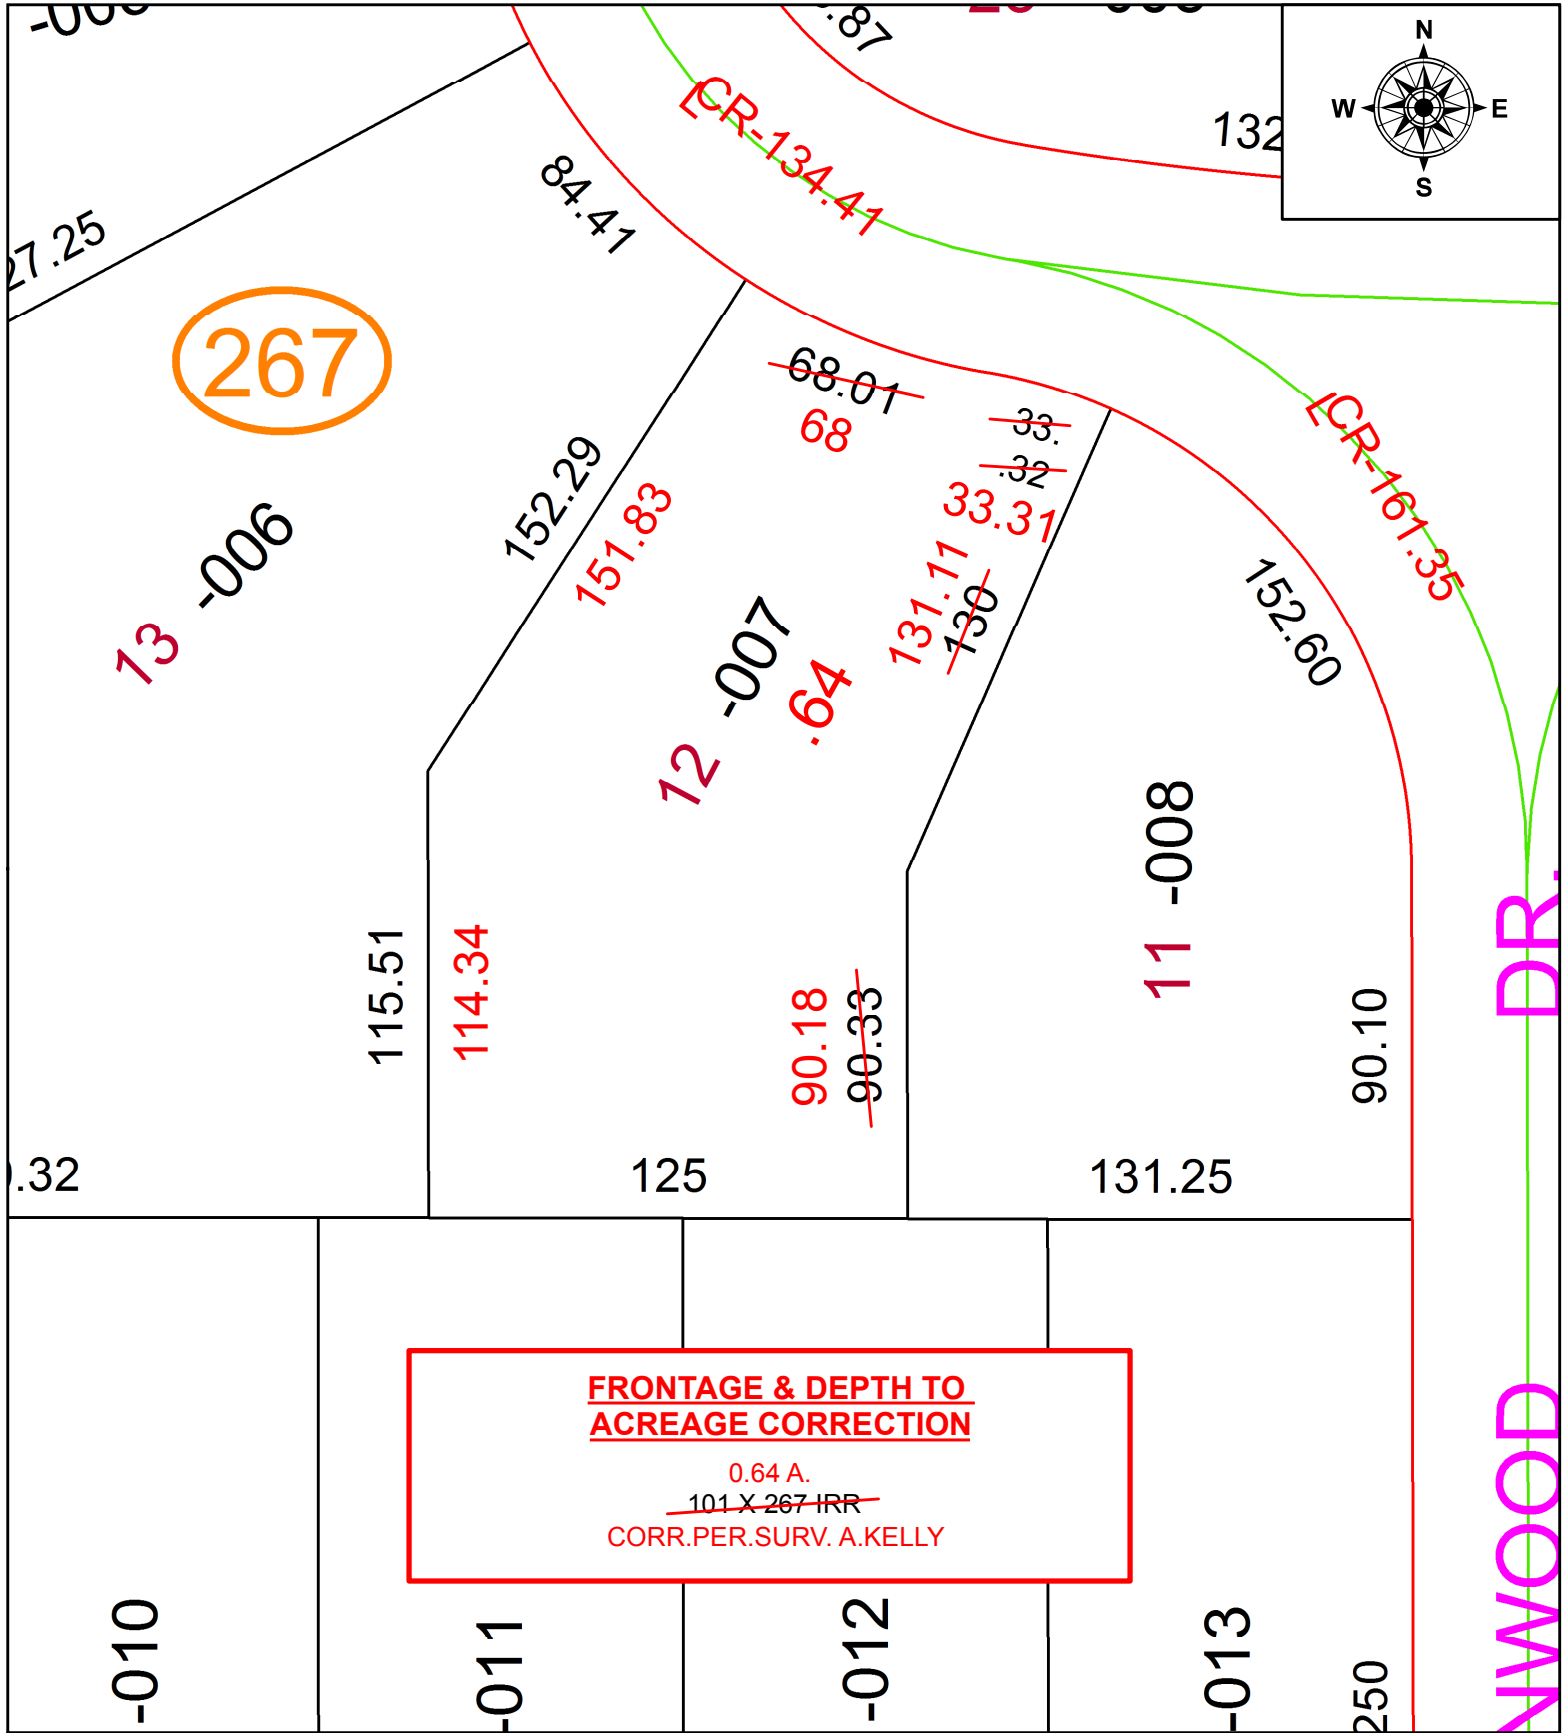

SPLITS/DEEDS PROCESSED
LORAIN COUNTY TAX MAP DEPARTMENT
226 MIDDLE AVE. ELYRIA, OH

SURVEYED BY: AMY M. KELLY
CLOSURE: 1: 738,068
MAP PAGE(S): 2-01-003
APPROVED BY: RRM DATE: 4-16-21
SCALE: 1" = 50 PRIOR INSTRUMENT: 20120438532