
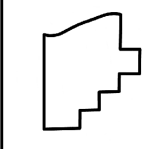
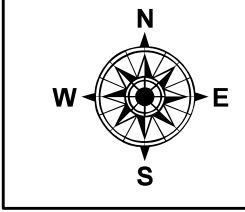


PARENT PARCEL: 04-00-008-104-047, -050, -077 & -110

CHILD PARCEL: 04-00-008-104-198 THRU -201

STARTING POINT: CL OF PIN OAK PKWY & MOORE RD.

22-04527

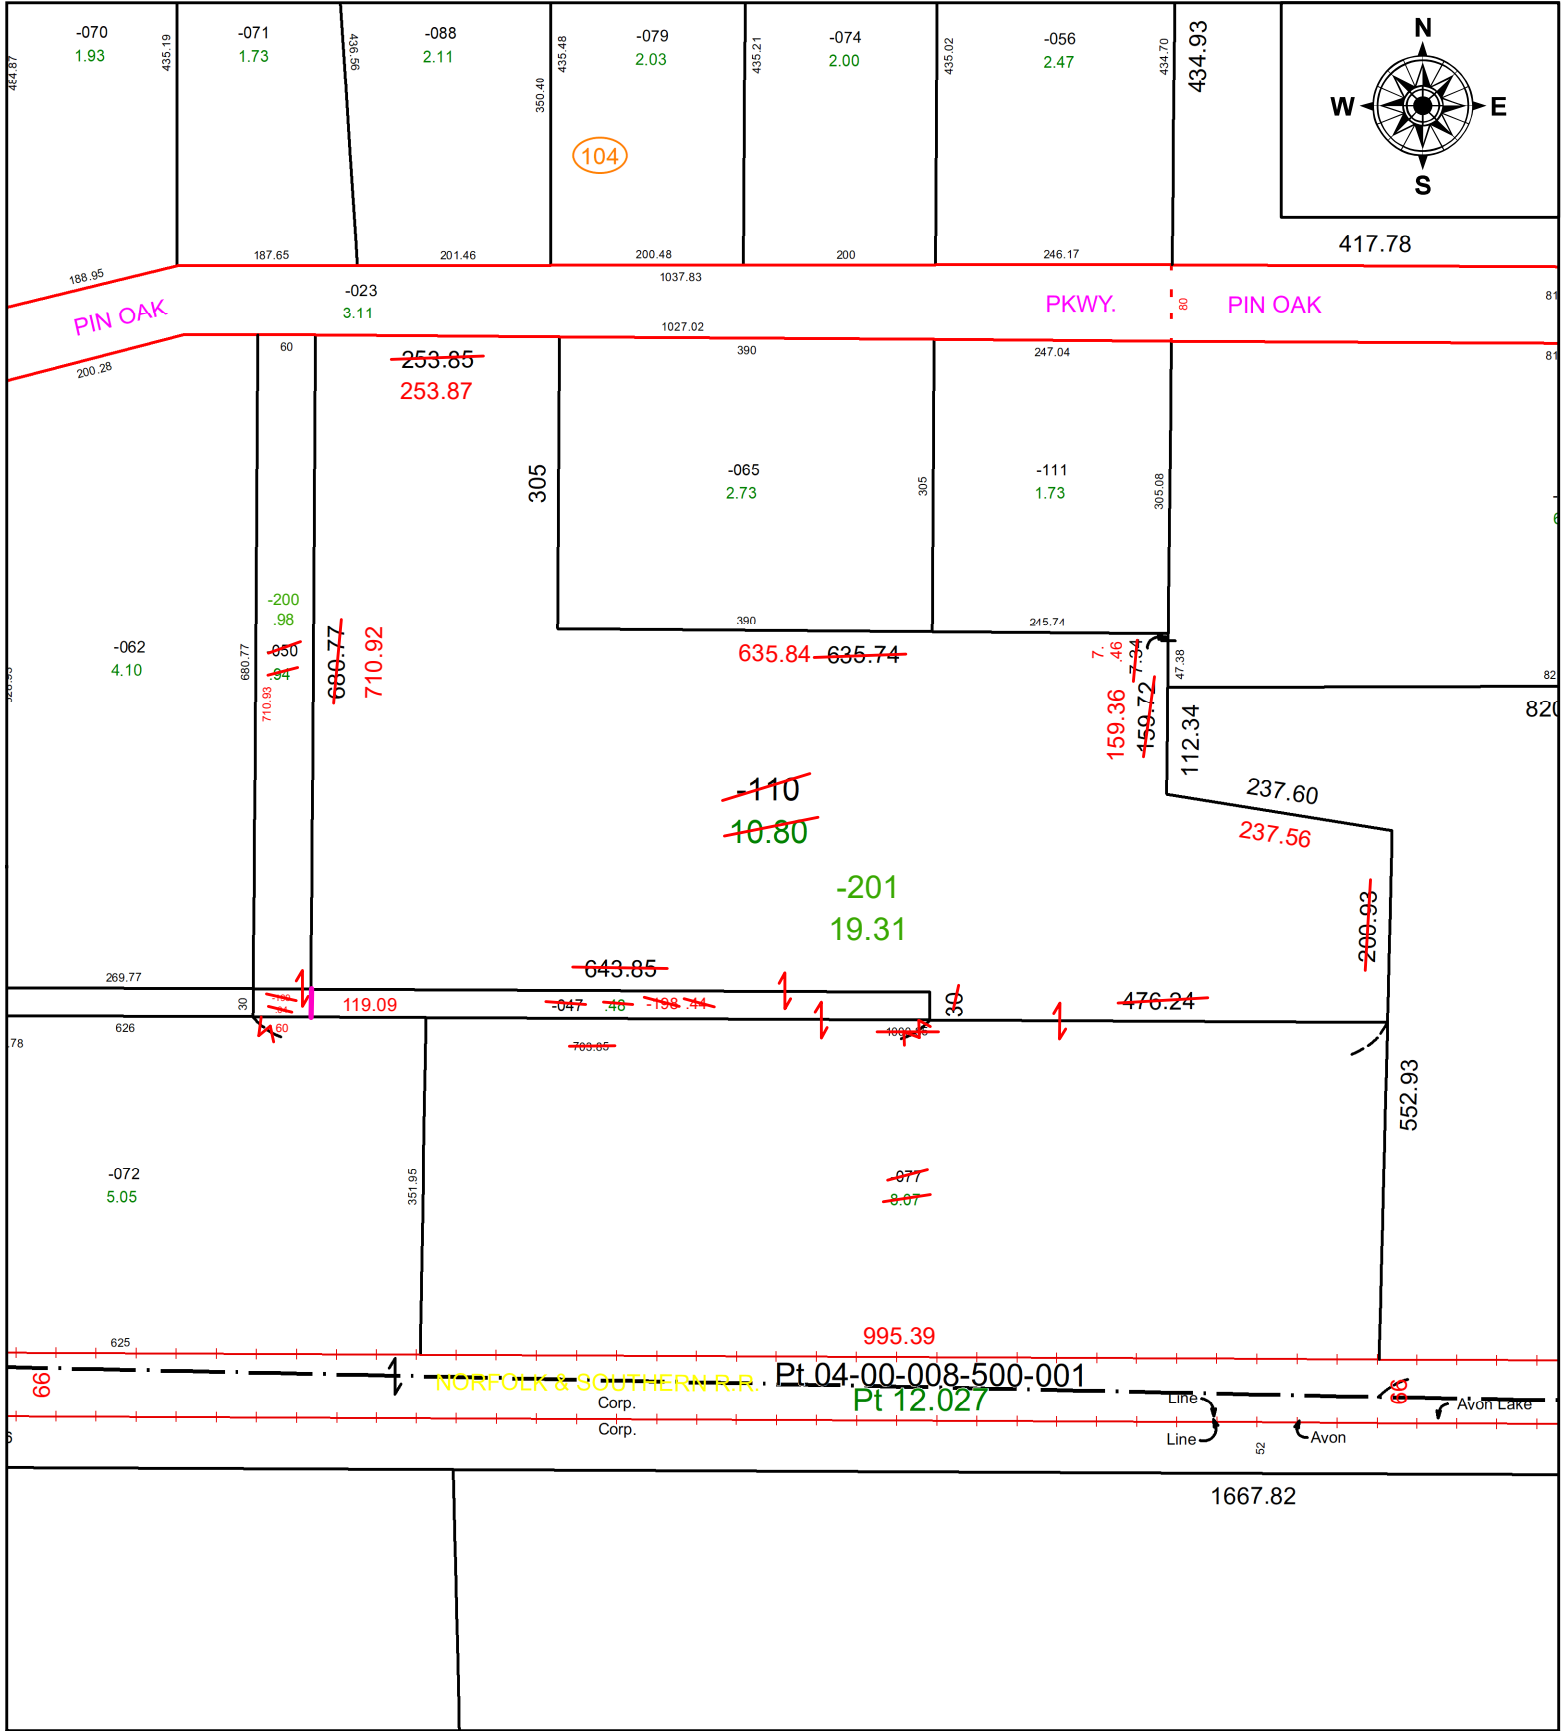

SPLITS/DEEDS PROCESSED
 LORAIN COUNTY TAX MAP DEPARTMENT
 226 MIDDLE AVE. ELYRIA, OH

SURVEYED BY: AMY KELLY SURVEY #: 50643
 CLOSURE: 1:382256
 MAP PAGE(S): 04-00-008
 APPROVED BY: DMA DATE: 7/19/2022
 SCALE: 1" = 200' PRIOR INSTRUMENT: D.V. 1191 PG. 273