


PARENT PARCEL: 07-00-035-101-025

CHILD PARCEL: 07-00-035-101-079, -080

STARTING POINT: SOUTHEAST CORNER OF LAND CONVEYED TO MOUSA & DOROTHY KALEEL (DV 335/187)

21-04528-U

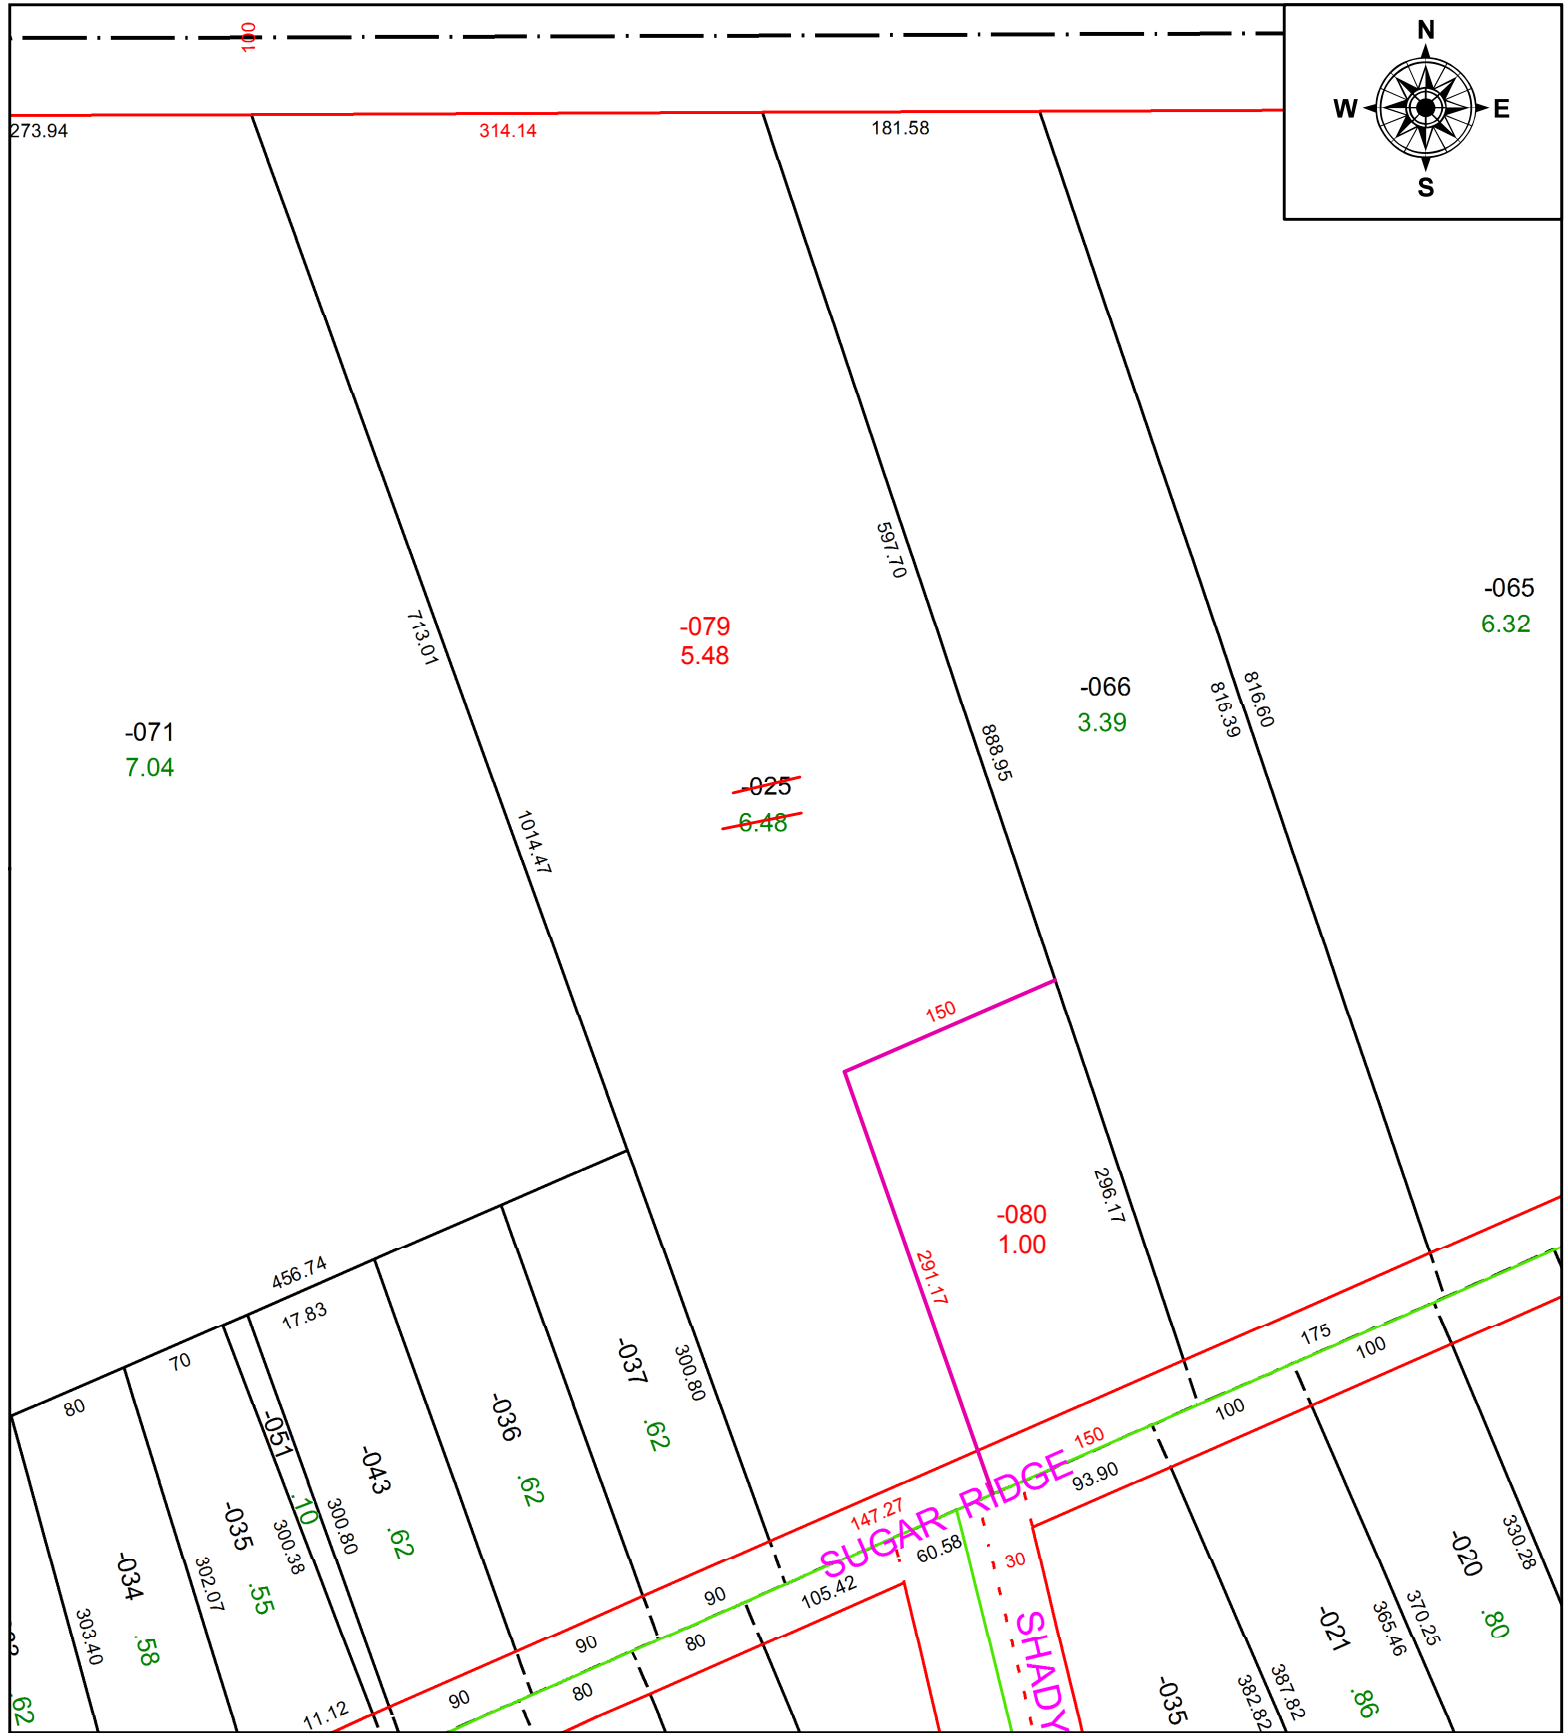

**SPLITS/DEEDS PROCESSED**  
LORAIN COUNTY TAX MAP DEPARTMENT  
226 MIDDLE AVE. ELYRIA, OH

SURVEYED BY: C.T. BIGGS  
CLOSURE: 1: 179,967  
MAP PAGE(S): 7-00-035  
APPROVED BY: RRM DATE: 4-22-21  
SCALE: 1" = 125 PRIOR INSTRUMENT: 20070223471