
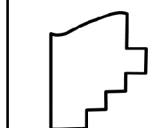
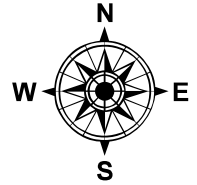


PARENT PARCEL: 12-00-048-000-032, -033, 12-00-049-000-007

CHILD PARCEL: 12-00-048-000-042, 12-00-049-000-007

STARTING POINT: ANGLE POINT IN THE CENTERLINE COLUMBIA WEST RIVER ROAD

21-04530-C

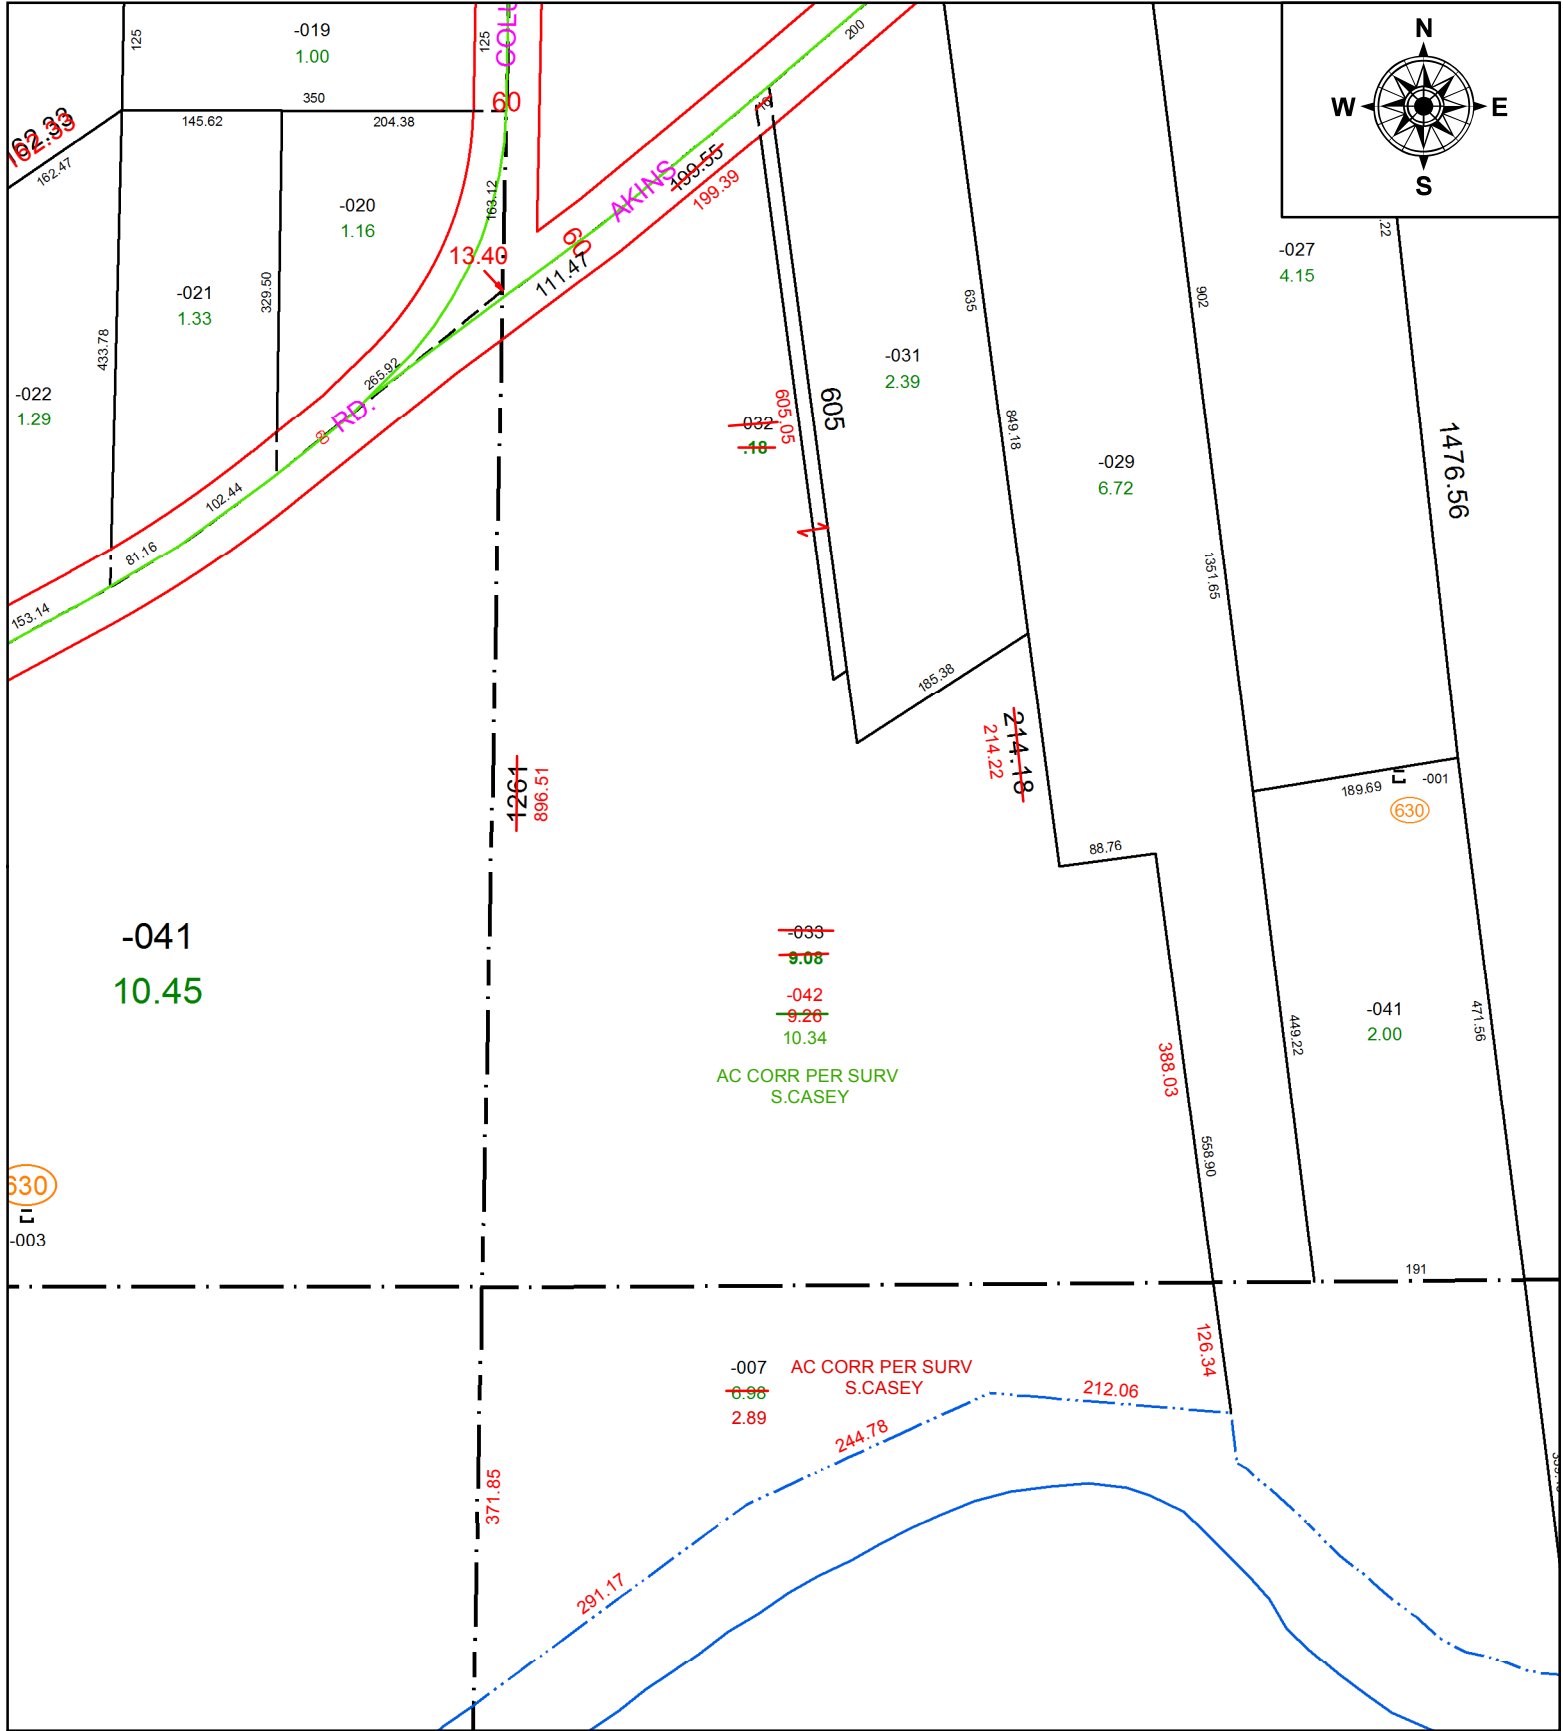

SPLITS/DEEDS PROCESSED
 LORAIN COUNTY TAX MAP DEPARTMENT
 226 MIDDLE AVE. ELYRIA, OH

SURVEYED BY: SCOTT J CASEY
CLOSURE: 1: 35459
MAP PAGE(S): 12-00-048
APPROVED BY: AC **DATE:** 4-26-21
SCALE: 1" = 175 **PRIOR INSTRUMENT:** 2016-0605960