


PARENT PARCEL: 20-20-010-000-014

CHILD PARCEL: 20-20-010-000-017 & -018

STARTING POINT: **AC CORR PER SURV BY TIMOTHY D. HOZALSKI**

22-04533

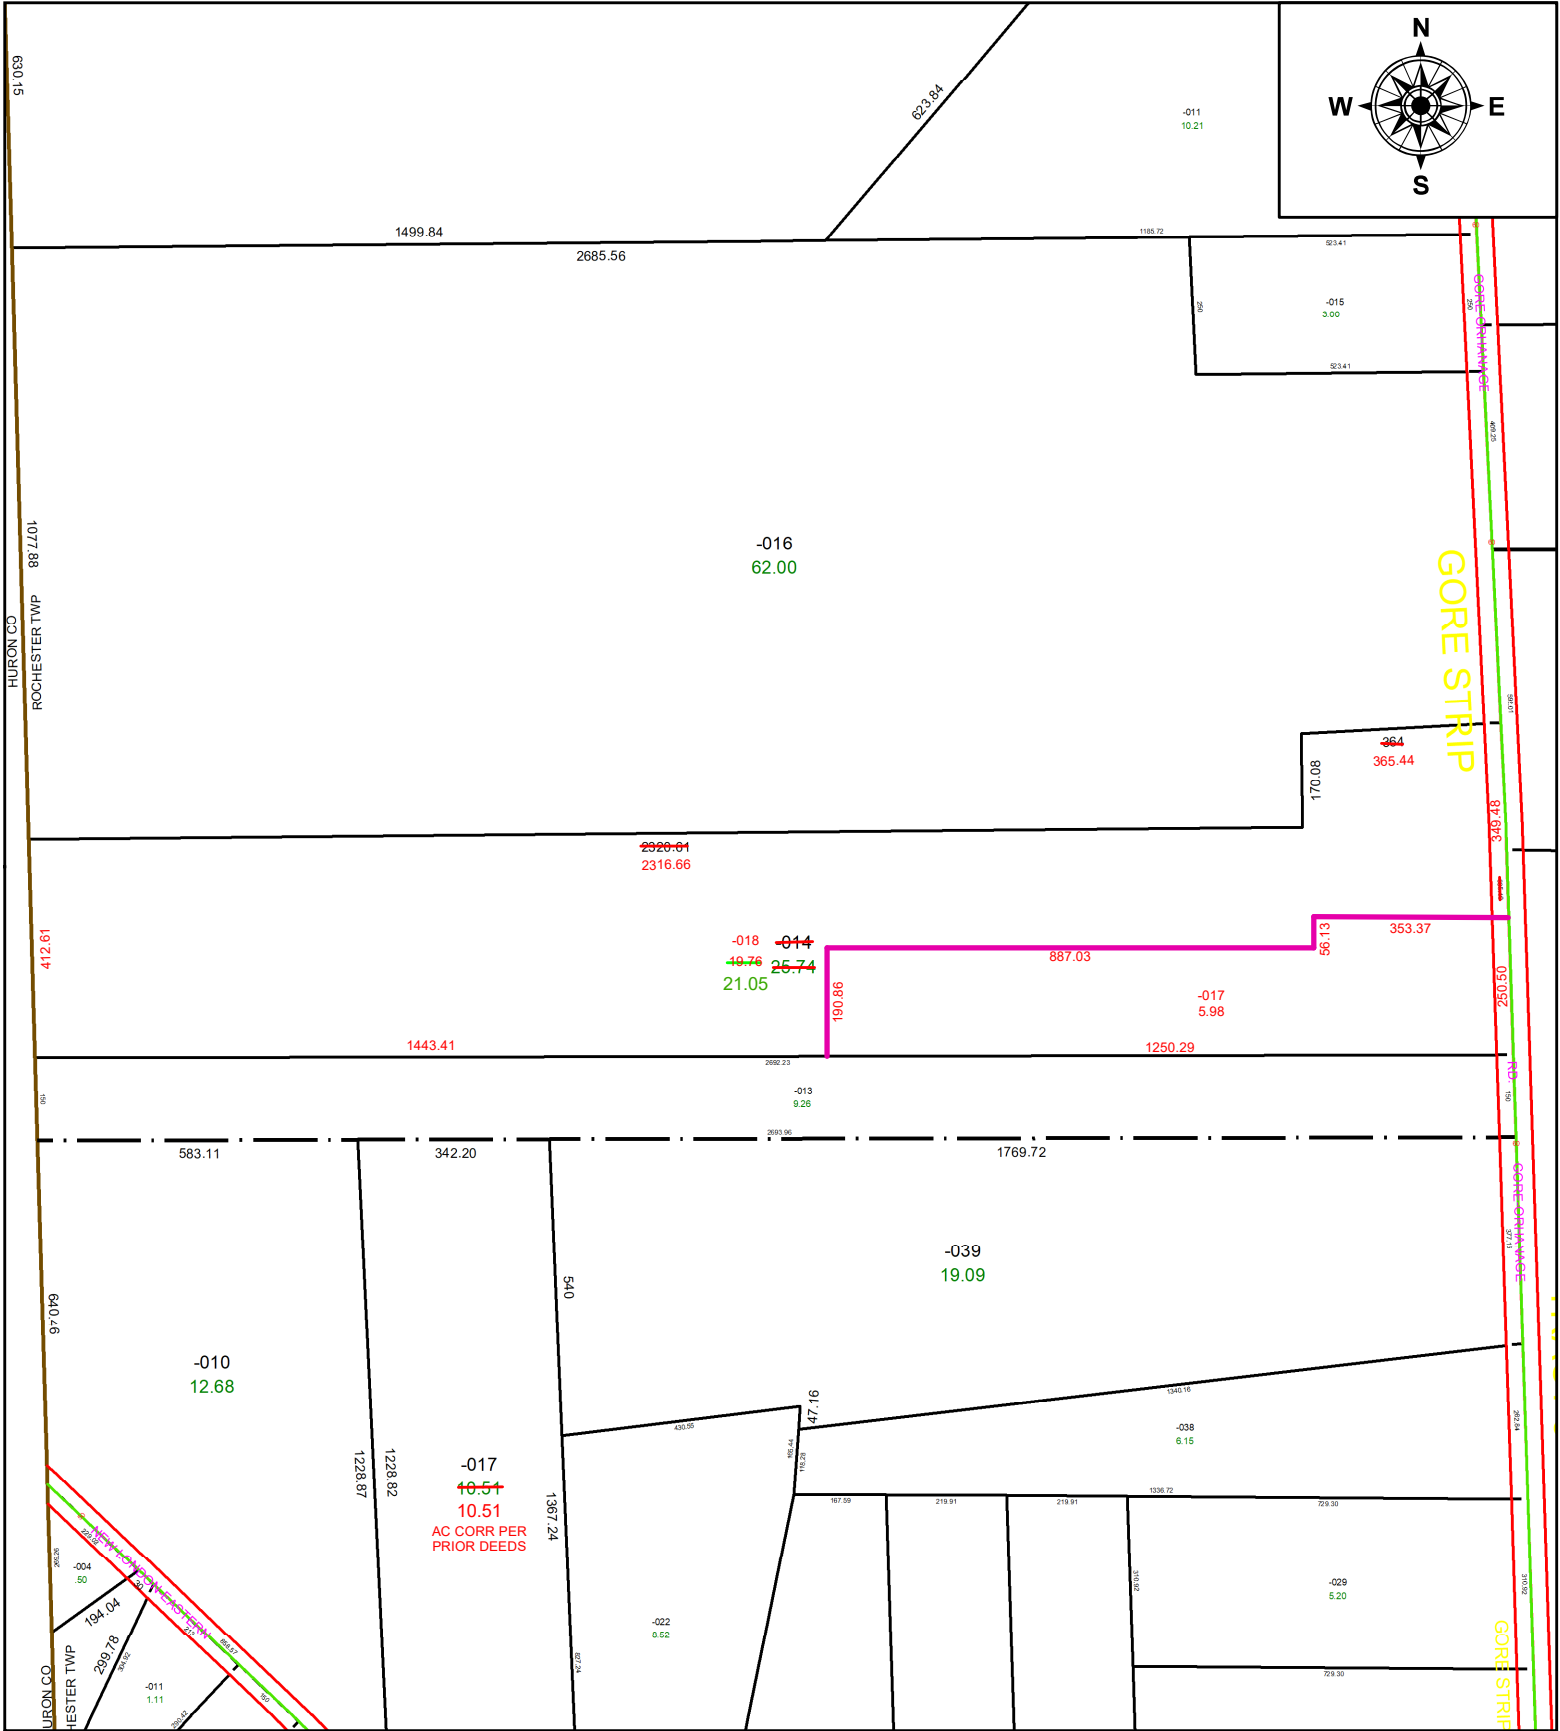

**SPLITS/DEEDS PROCESSED**  
 LORAIN COUNTY TAX MAP DEPARTMENT  
 226 MIDDLE AVE. ELYRIA, OH

**SURVEYED BY:** TIMOTHY D. HOZALSKI

**CLOSURE:** 1: 824290

**MAP PAGE(S):** 20-20-010-C

**APPROVED BY:** AC **DATE:** August 01, 2022

**SCALE:** 1" = 350 **PRIOR INSTRUMENT:** 1997- 0452928