


PARENT PARCEL: 12-00-045-000-023

CHILD PARCEL: _____

STARTING POINT: Southeasterly corner of Original Lot 45 and Southwesterly corner of Original Lot 36

21-04534-A

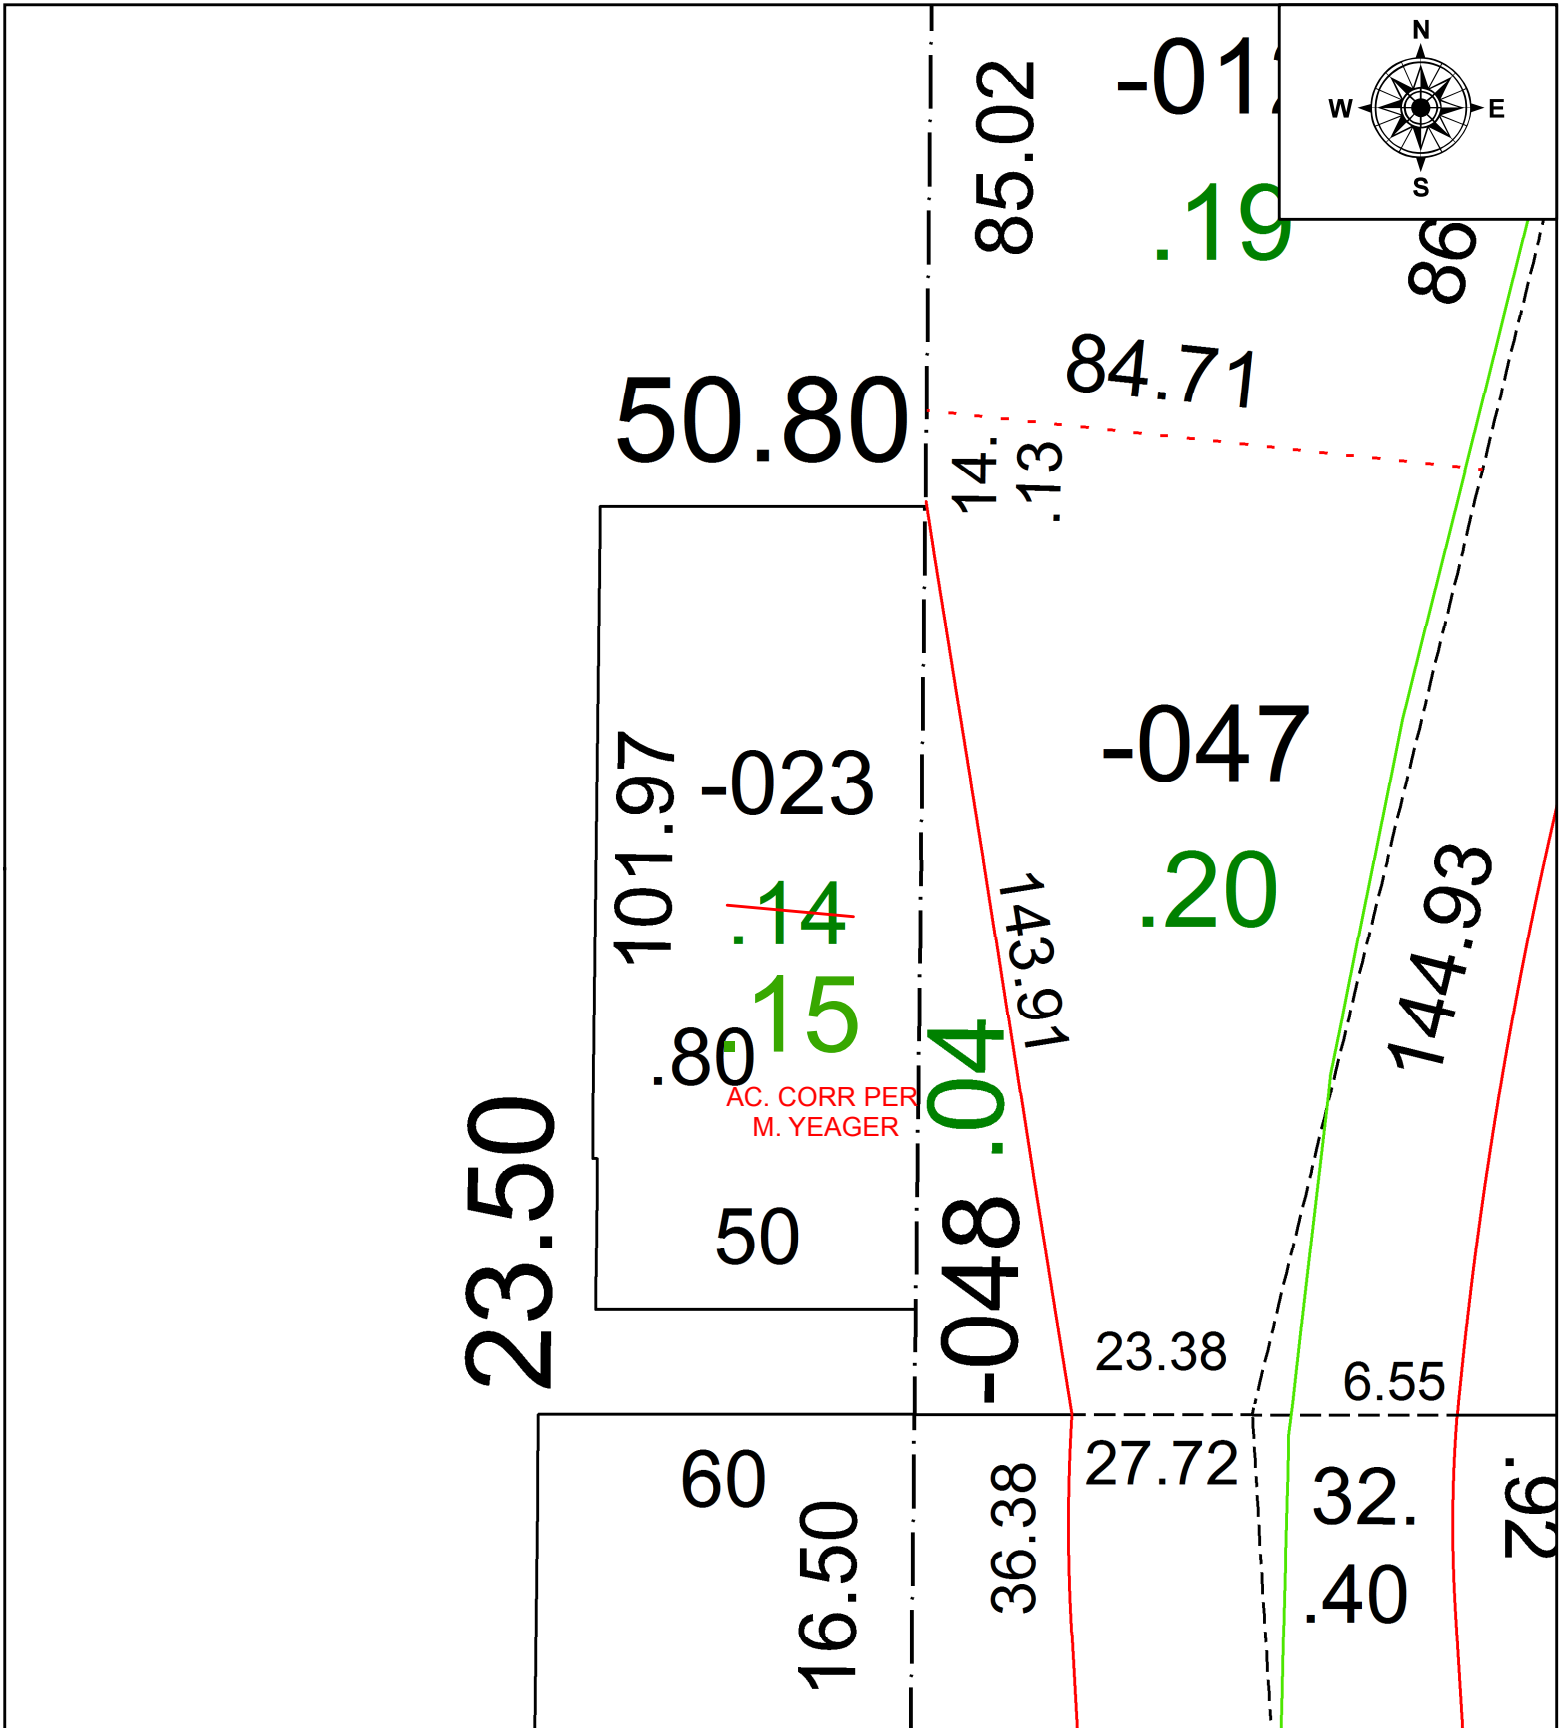

SPLITS/DEEDS PROCESSED
 LORAIN COUNTY TAX MAP DEPARTMENT
 226 MIDDLE AVE. ELYRIA, OH

SURVEYED BY: MARKA A. YEAGER
 CLOSURE: 1: 35459
 MAP PAGE(S): 12-00-045-B
 APPROVED BY: AC DATE: 4-28-21
 SCALE: 1" = 30' PRIOR INSTRUMENT: 2007-0209996