
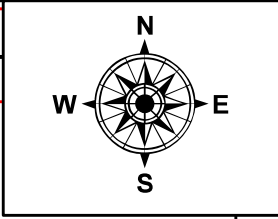


PARENT PARCEL: 11-00-065-000-005 & -006

CHILD PARCEL: 11-00-065-000-034 THRU -036

STARTING POINT: CL OF TWINSBURG-ELYRIA RD. & N.W. CORNER O.L.65

22-04534

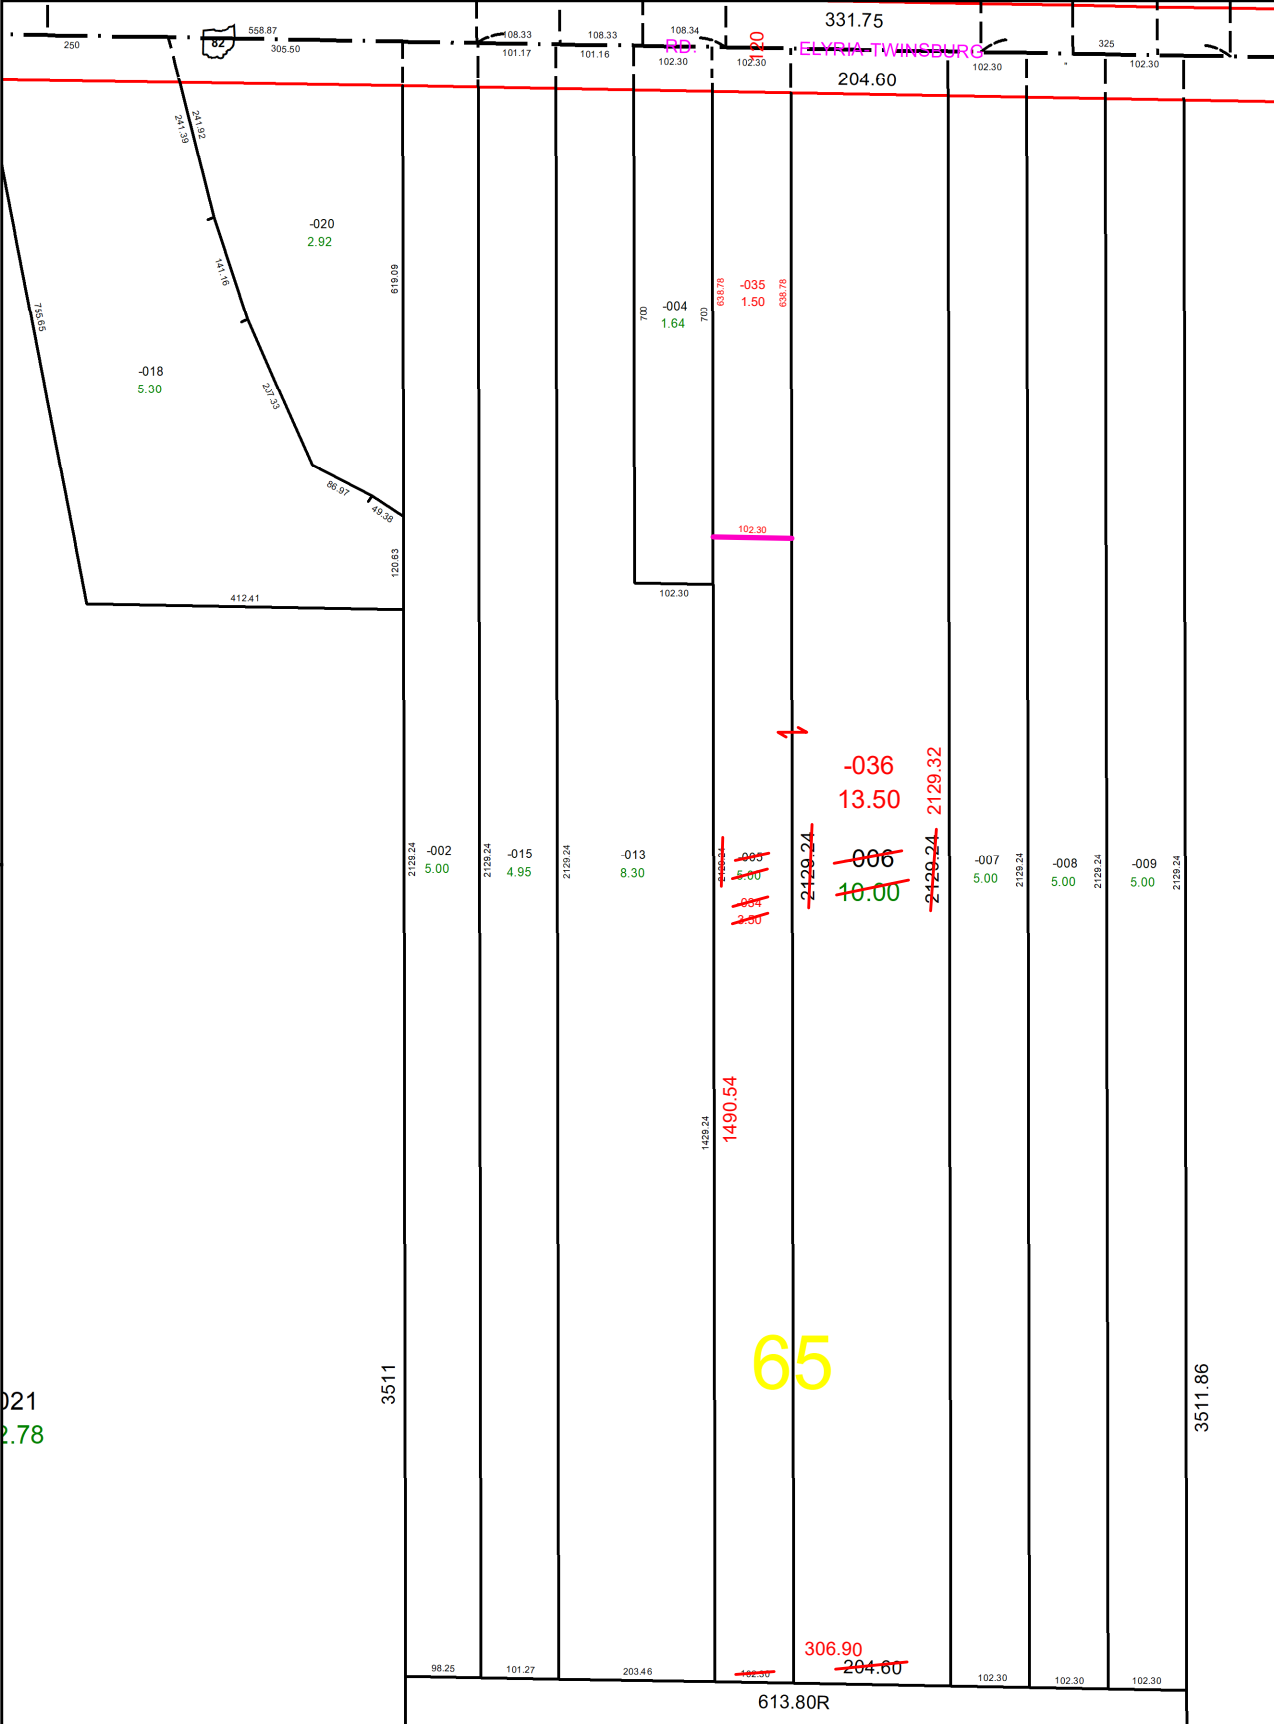

SPLITS/DEEDS PROCESSED
 LORAIN COUNTY TAX MAP DEPARTMENT
 226 MIDDLE AVE. ELYRIA, OH

SURVEYED BY: RICHARD METZKER **SURVEY #:** 50658
CLOSURE: 1:-2147483648
MAP PAGE(S): 11-00-065
APPROVED BY: DMA **DATE:** 8/2/2022
SCALE: 1" = 250' **PRIOR INSTRUMENT:** 2017-0620249