


PARENT PARCEL: 07-00-004-110-037

CHILD PARCEL: \_\_\_\_\_

STARTING POINT: CENTERLINE OF COOK AT THE SE CORNER OF LAND CONVEYED IN VOL 1092, PG 702


21-04535-A

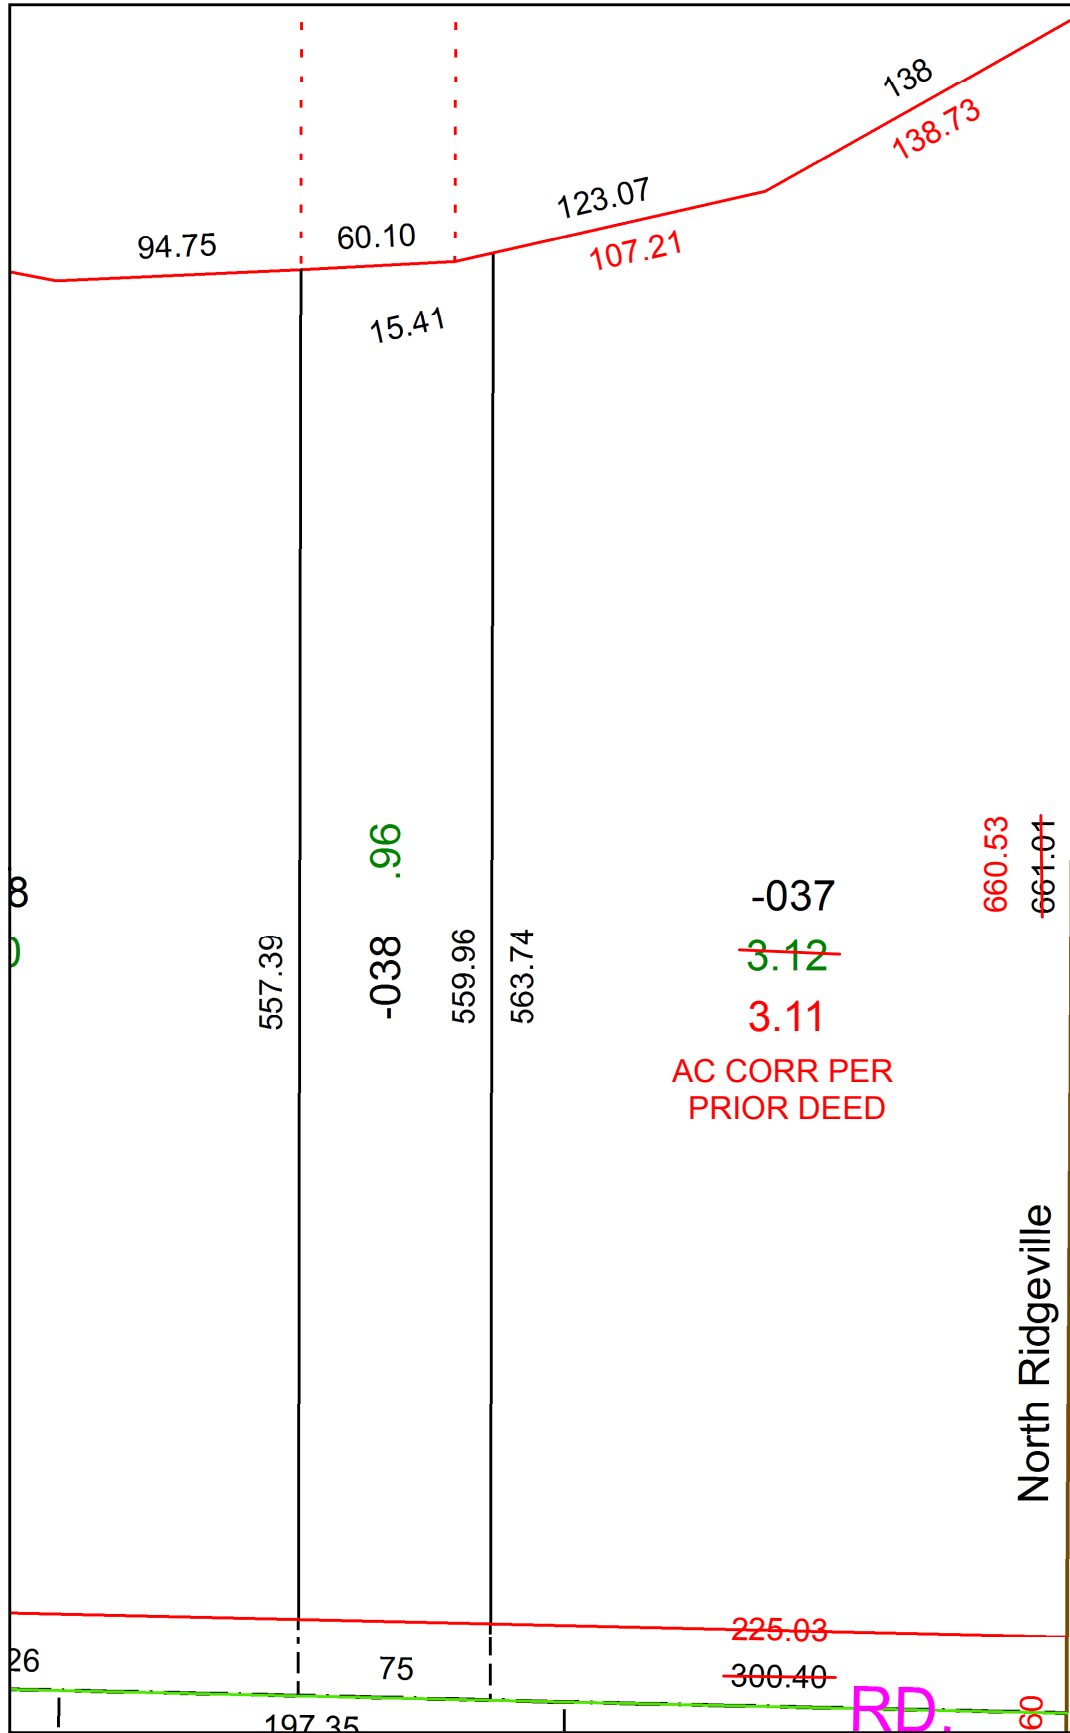

AC CORR PER  
PRIOR DEED

North Ridgeville

RD.

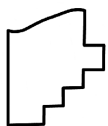

**SPLITS/DEEDS PROCESSED**  
LORAIN COUNTY TAX MAP DEPARTMENT  
226 MIDDLE AVE. ELYRIA, OH

|              |  |
|--------------|--|
| SURVEYED BY: | N/A                                    |
| CLOSURE:     | 1: 35459                               |
| MAP PAGE(S): | 07-00-004                              |
| APPROVED BY: | AC DATE: 4-28-21                       |
| SCALE:       | 1" = 75 PRIOR INSTRUMENT: 2019-0703215 |