
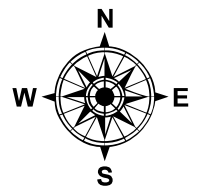


PARENT PARCEL: 03-00-004-000-087

CHILD PARCEL: 03-00-004-000-096 & -097 **AC CORR PER SURV BY BRENT D. ANDERSON**

22-04536

STARTING POINT: C/L OF FRENCH CREEK RD AND E LINE OF O/L 4

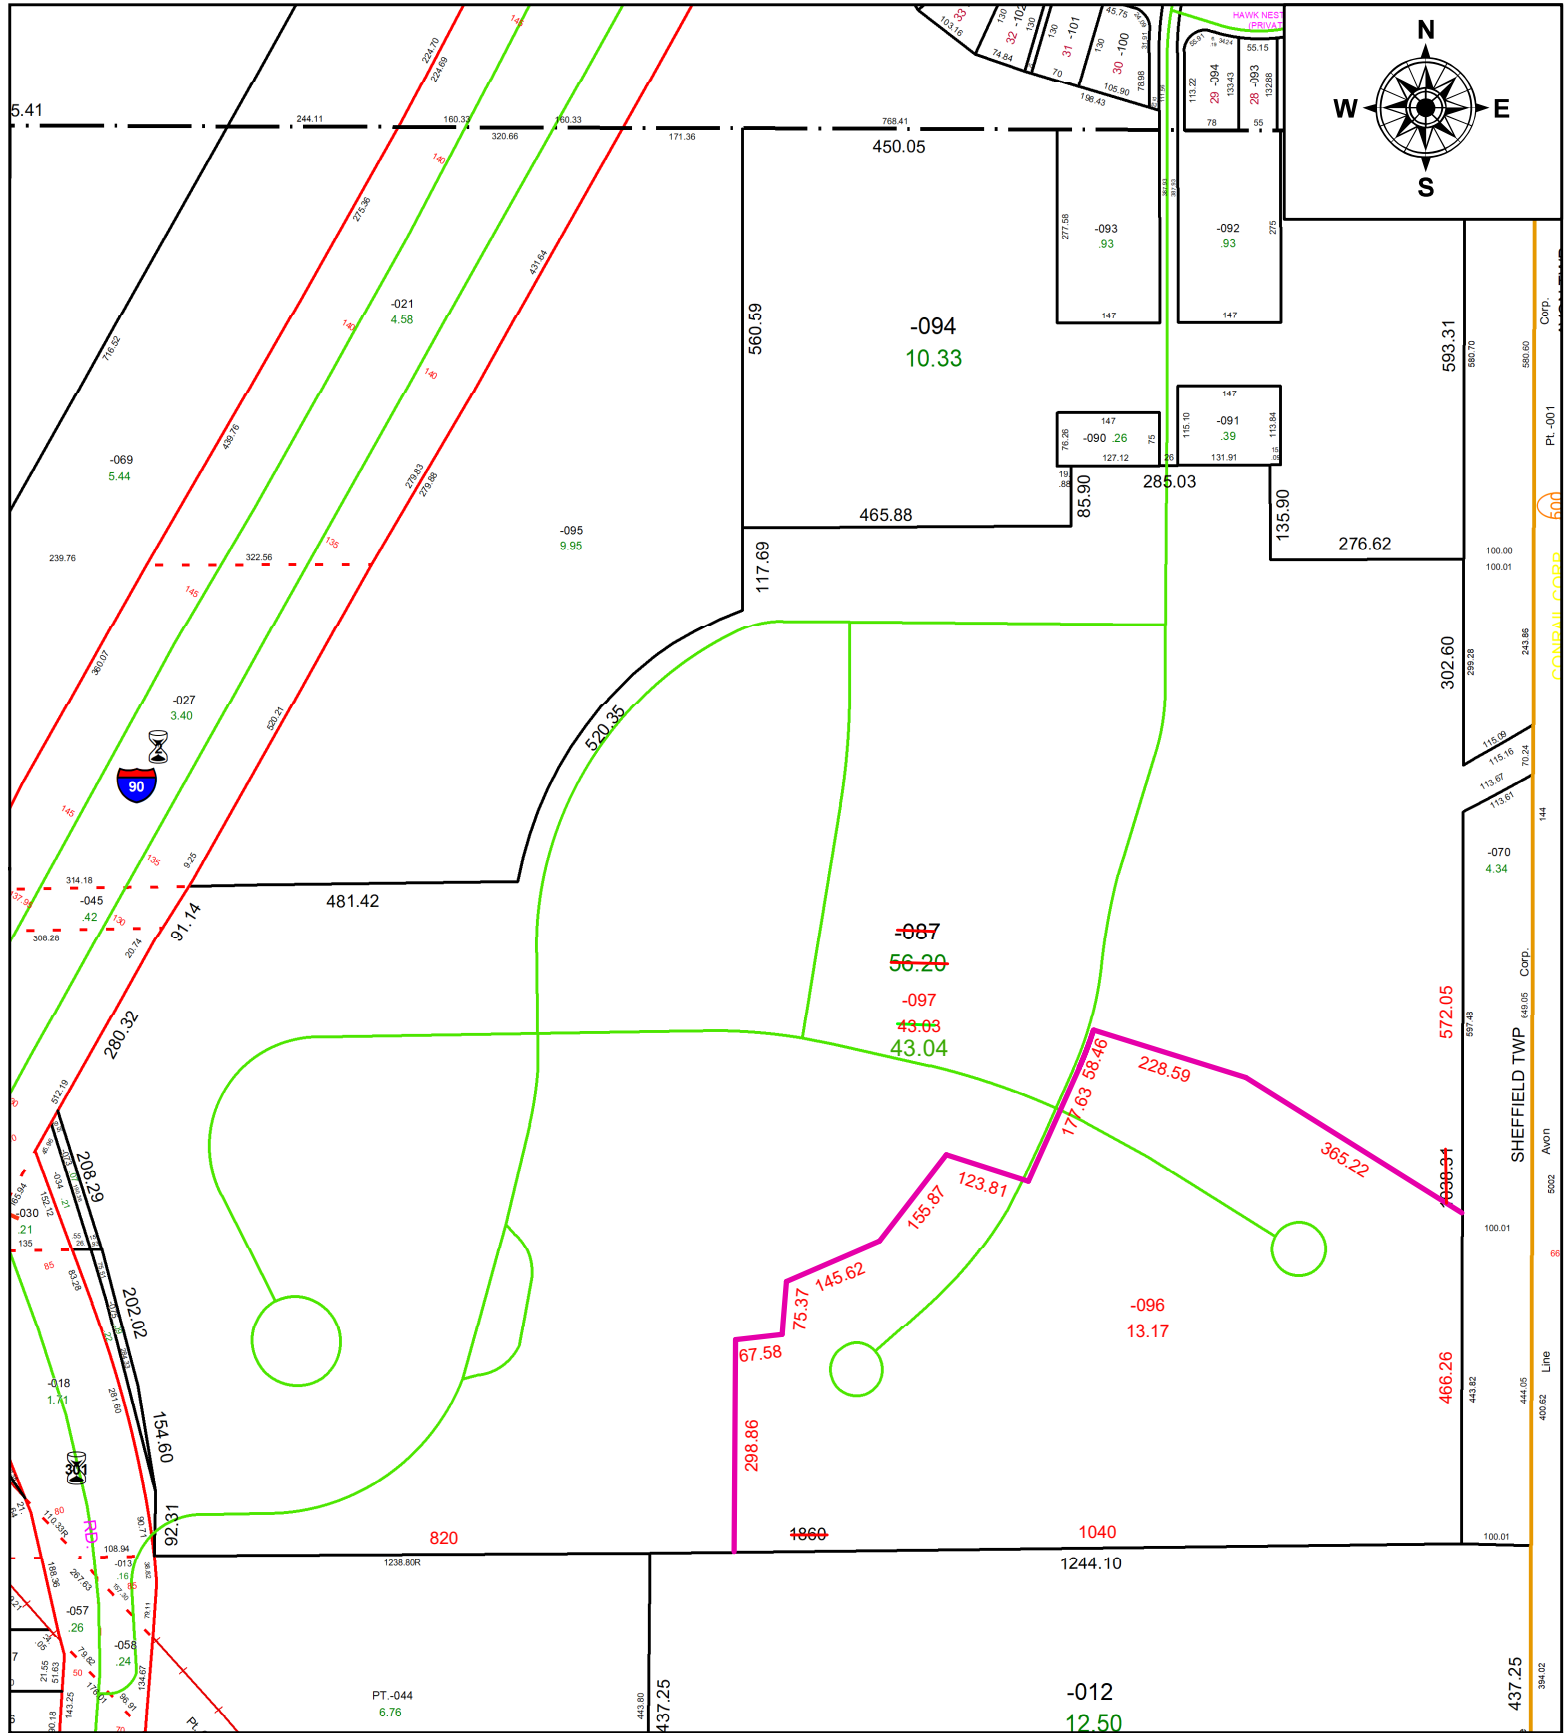

SPLITS/DEEDS PROCESSED
 LORAIN COUNTY TAX MAP DEPARTMENT
 226 MIDDLE AVE. ELYRIA, OH

SURVEYED BY: BRENT D. ANDERSON
CLOSURE: 1: 317860
MAP PAGE(S): 03-00-004
APPROVED BY: AC **DATE:** August 04, 2022
SCALE: 1" = 275 **PRIOR INSTRUMENT:** 2019- 0702416