



PARENT PARCEL: ADD TO DUP  
CHILD PARCEL: 15-00-055-104-103  
STARTING POINT:

21-04539-C

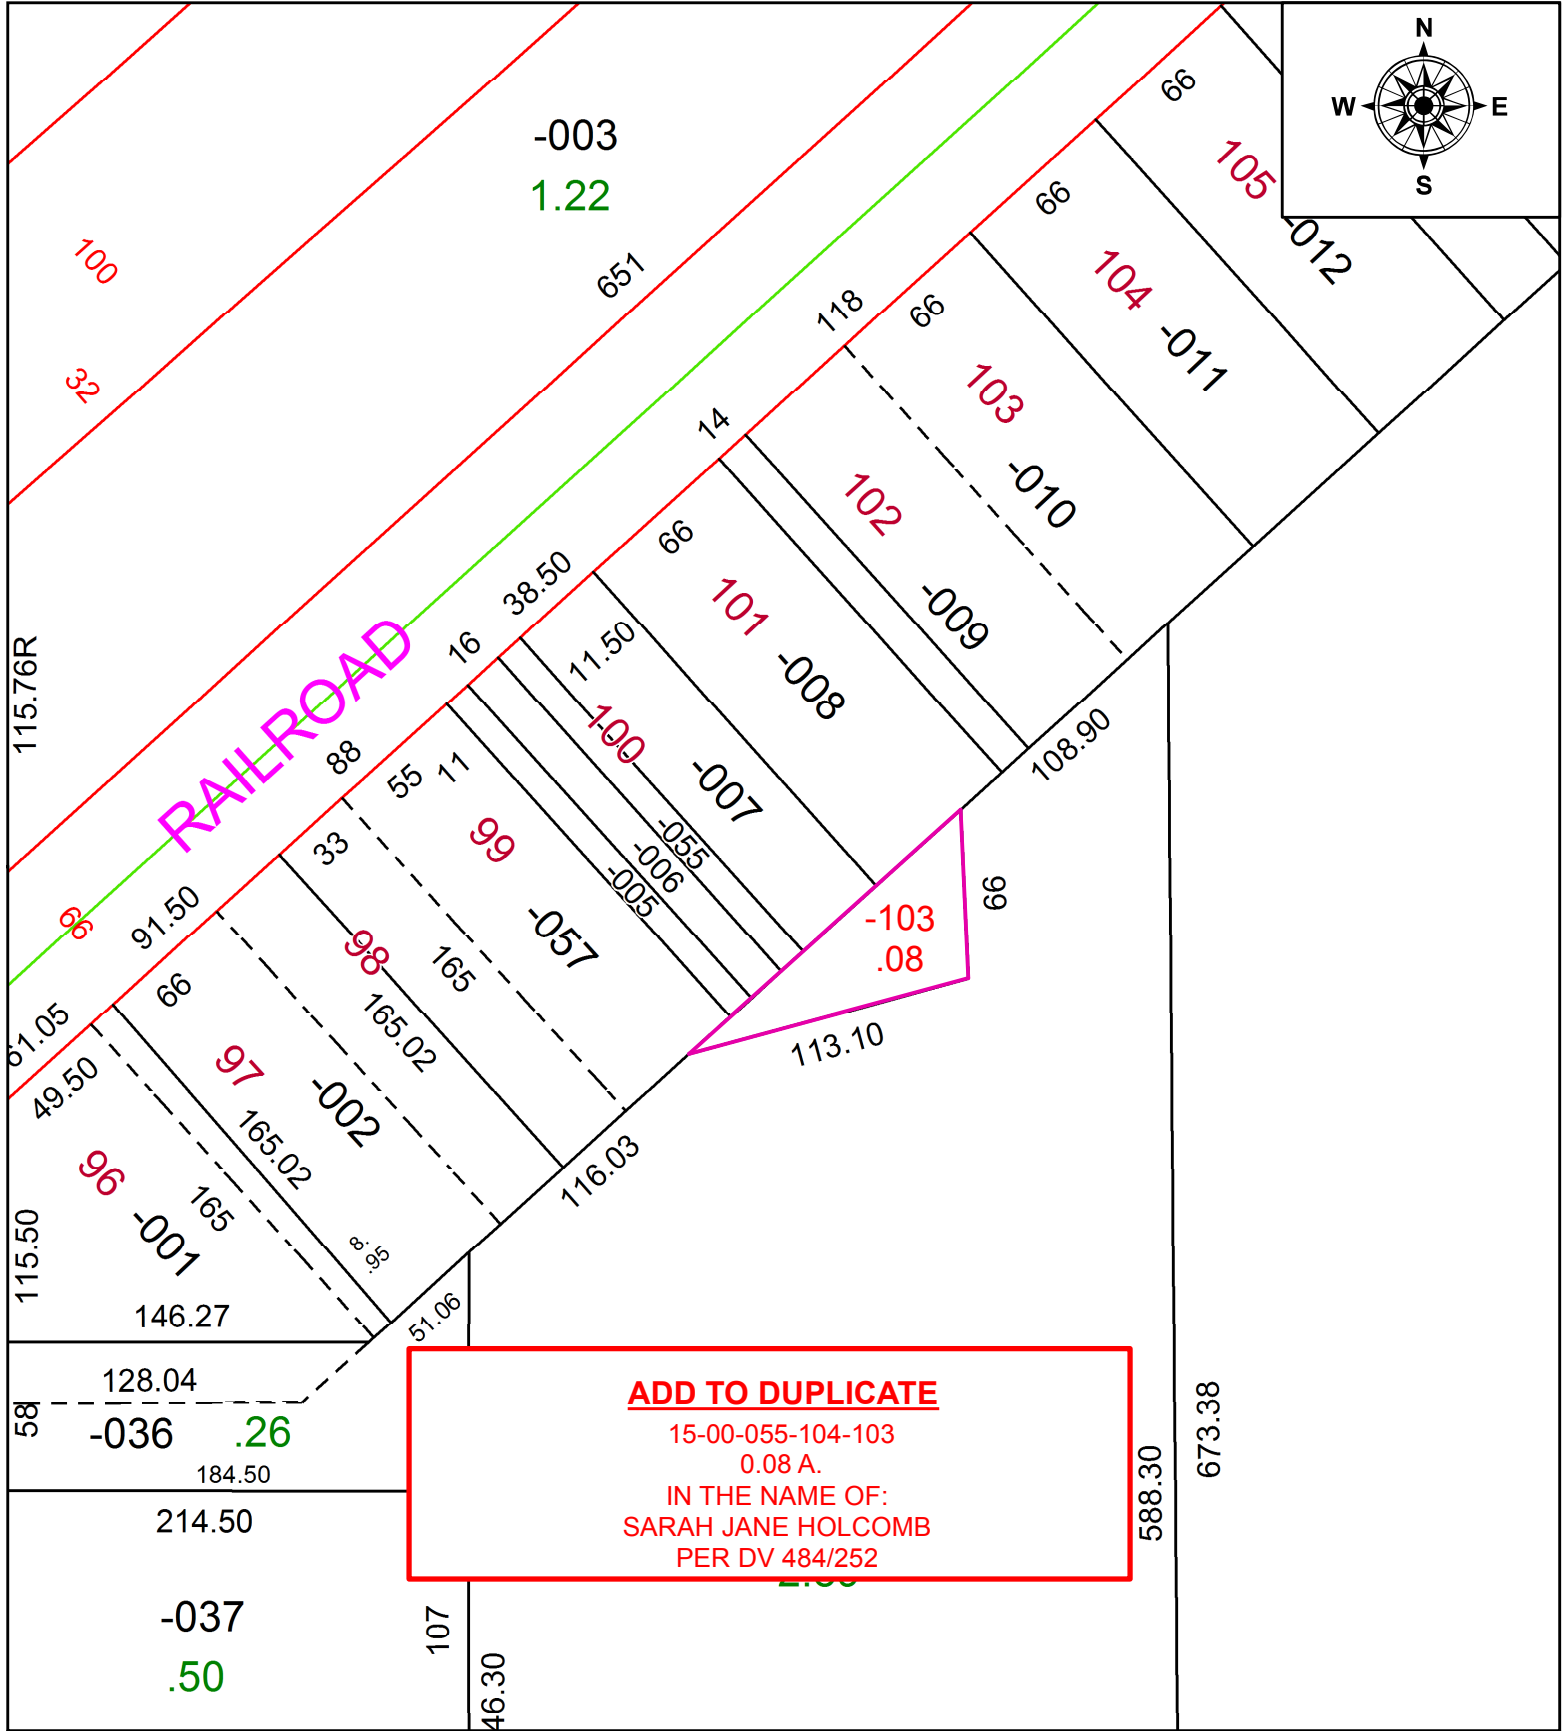

**ADD TO DUPLICATE**  
15-00-055-104-103  
0.08 A.  
IN THE NAME OF:  
SARAH JANE HOLCOMB  
PER DV 484/252

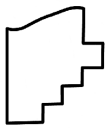

**SPLITS/DEEDS PROCESSED**  
LORAIN COUNTY TAX MAP DEPARTMENT  
226 MIDDLE AVE. ELYRIA, OH

SURVEYED BY: N/A  
CLOSURE: N/A  
MAP PAGE(S): 15-00-055  
APPROVED BY: RRM DATE: 5-3-21  
SCALE: 1" = 75' PRIOR INSTRUMENT: DV 484/252