
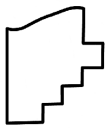


PARENT PARCEL: 11-00-013-000-035

CHILD PARCEL: 11-00-013-000-046 & -047

STARTING POINT: C/L OF COOLEY RD AND SE CORNER OF O/L 13

22-04544

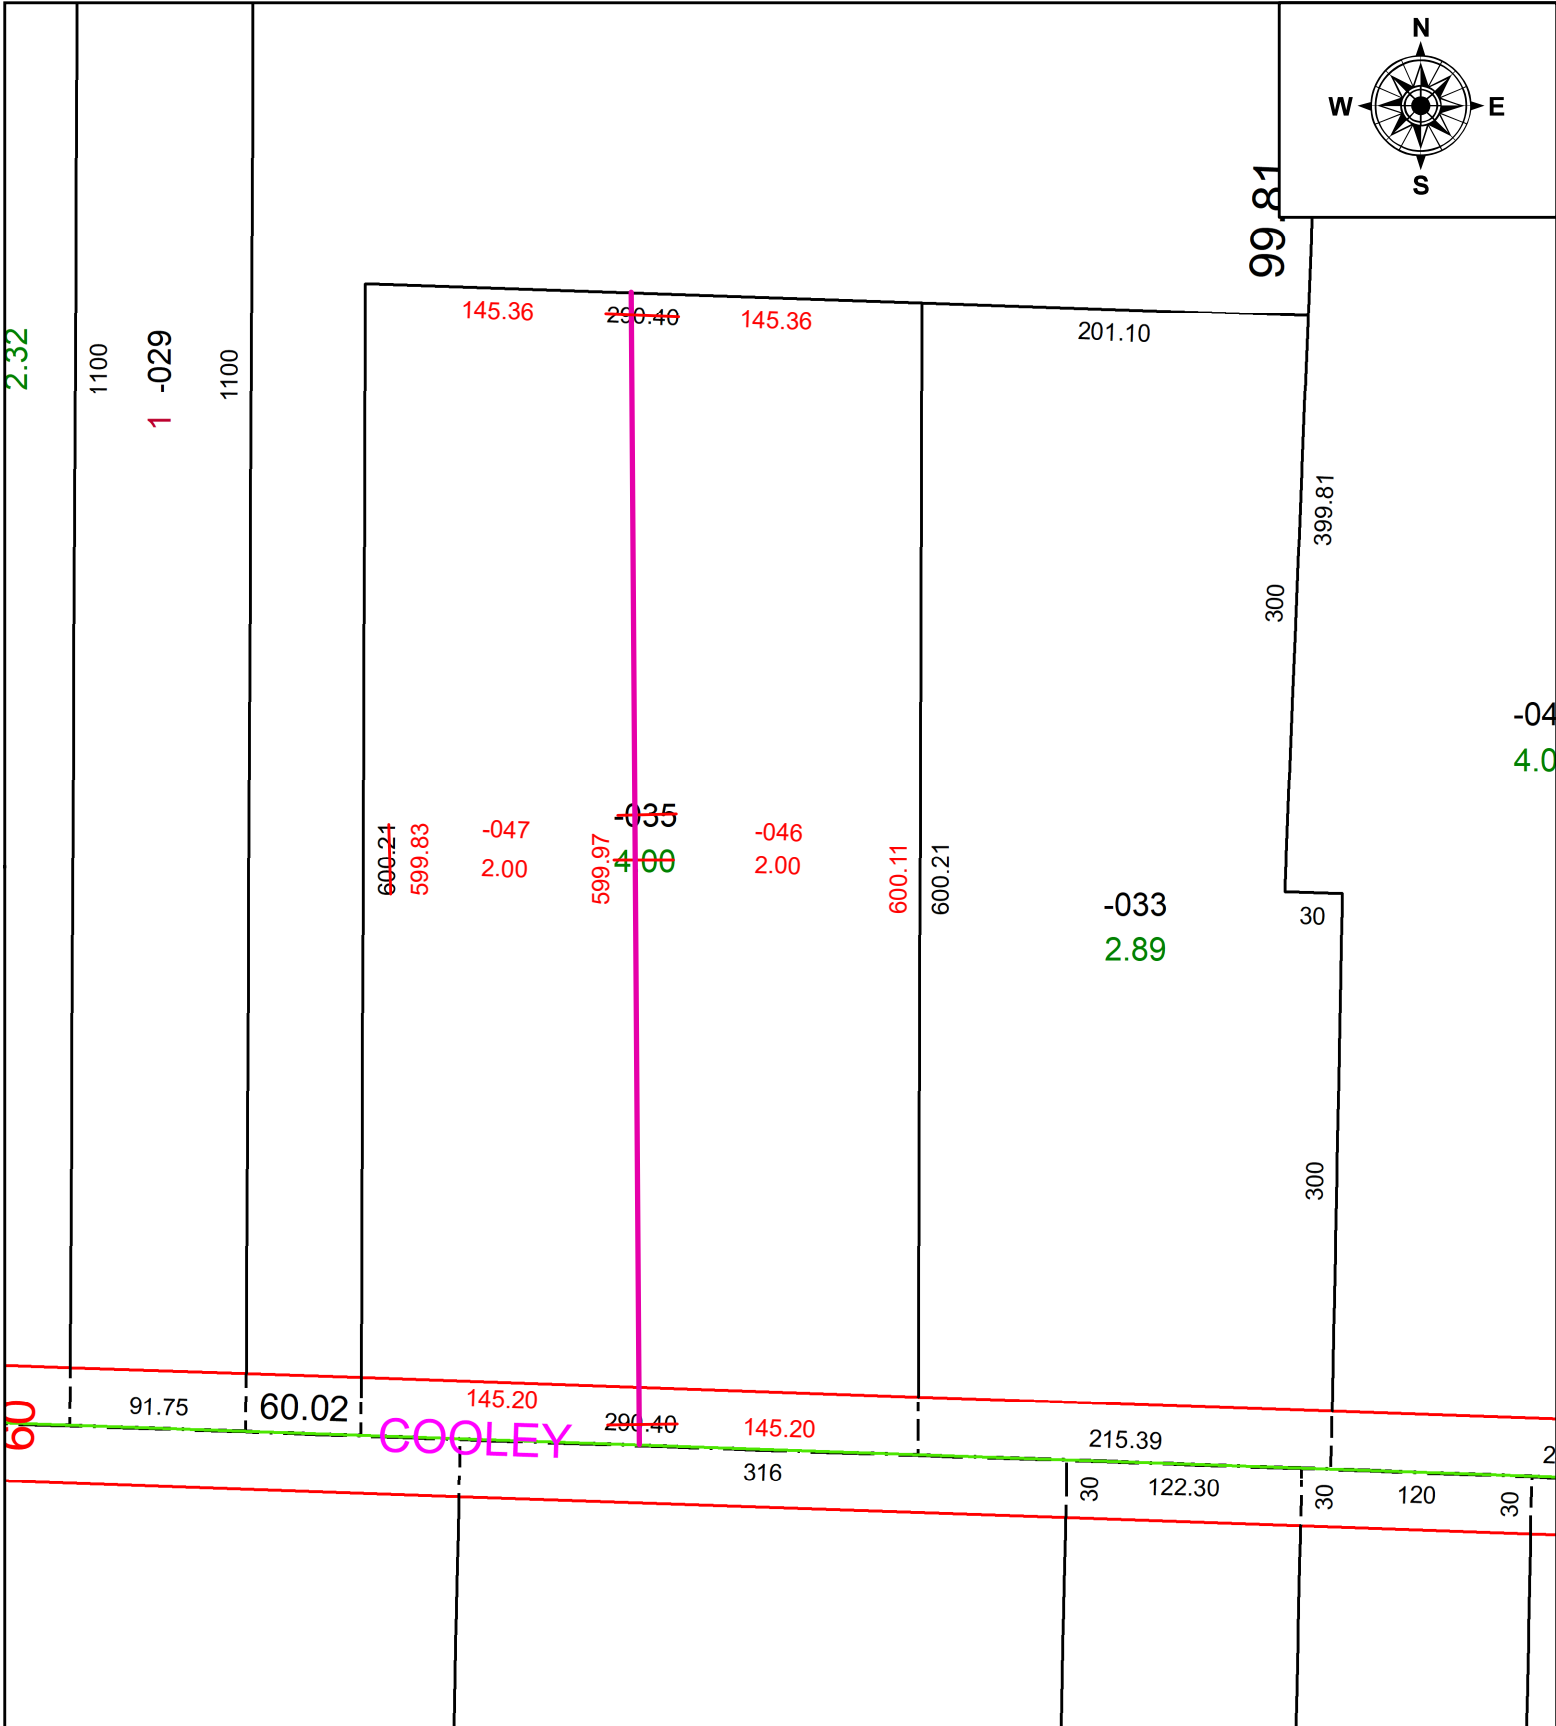

SPLITS/DEEDS PROCESSED
 LORAIN COUNTY TAX MAP DEPARTMENT
 226 MIDDLE AVE. ELYRIA, OH

SURVEYED BY: JOHN G. HOY
 CLOSURE: 1: 1216644
 MAP PAGE(S): 11-00-013-B
 APPROVED BY: AC DATE: August 23, 2022
 SCALE: 1" = 100 PRIOR INSTRUMENT: 2017- 0632027