


PARENT PARCEL: 07-00-028-101-025

CHILD PARCEL: _____

21-04545-C

STARTING POINT: C/L OF SHAEFER DRIVE AT THE NW CORNER OF LAND CONVEYED TO DONALD AND MARJORIE HOBSON, VOL 572 PG 120

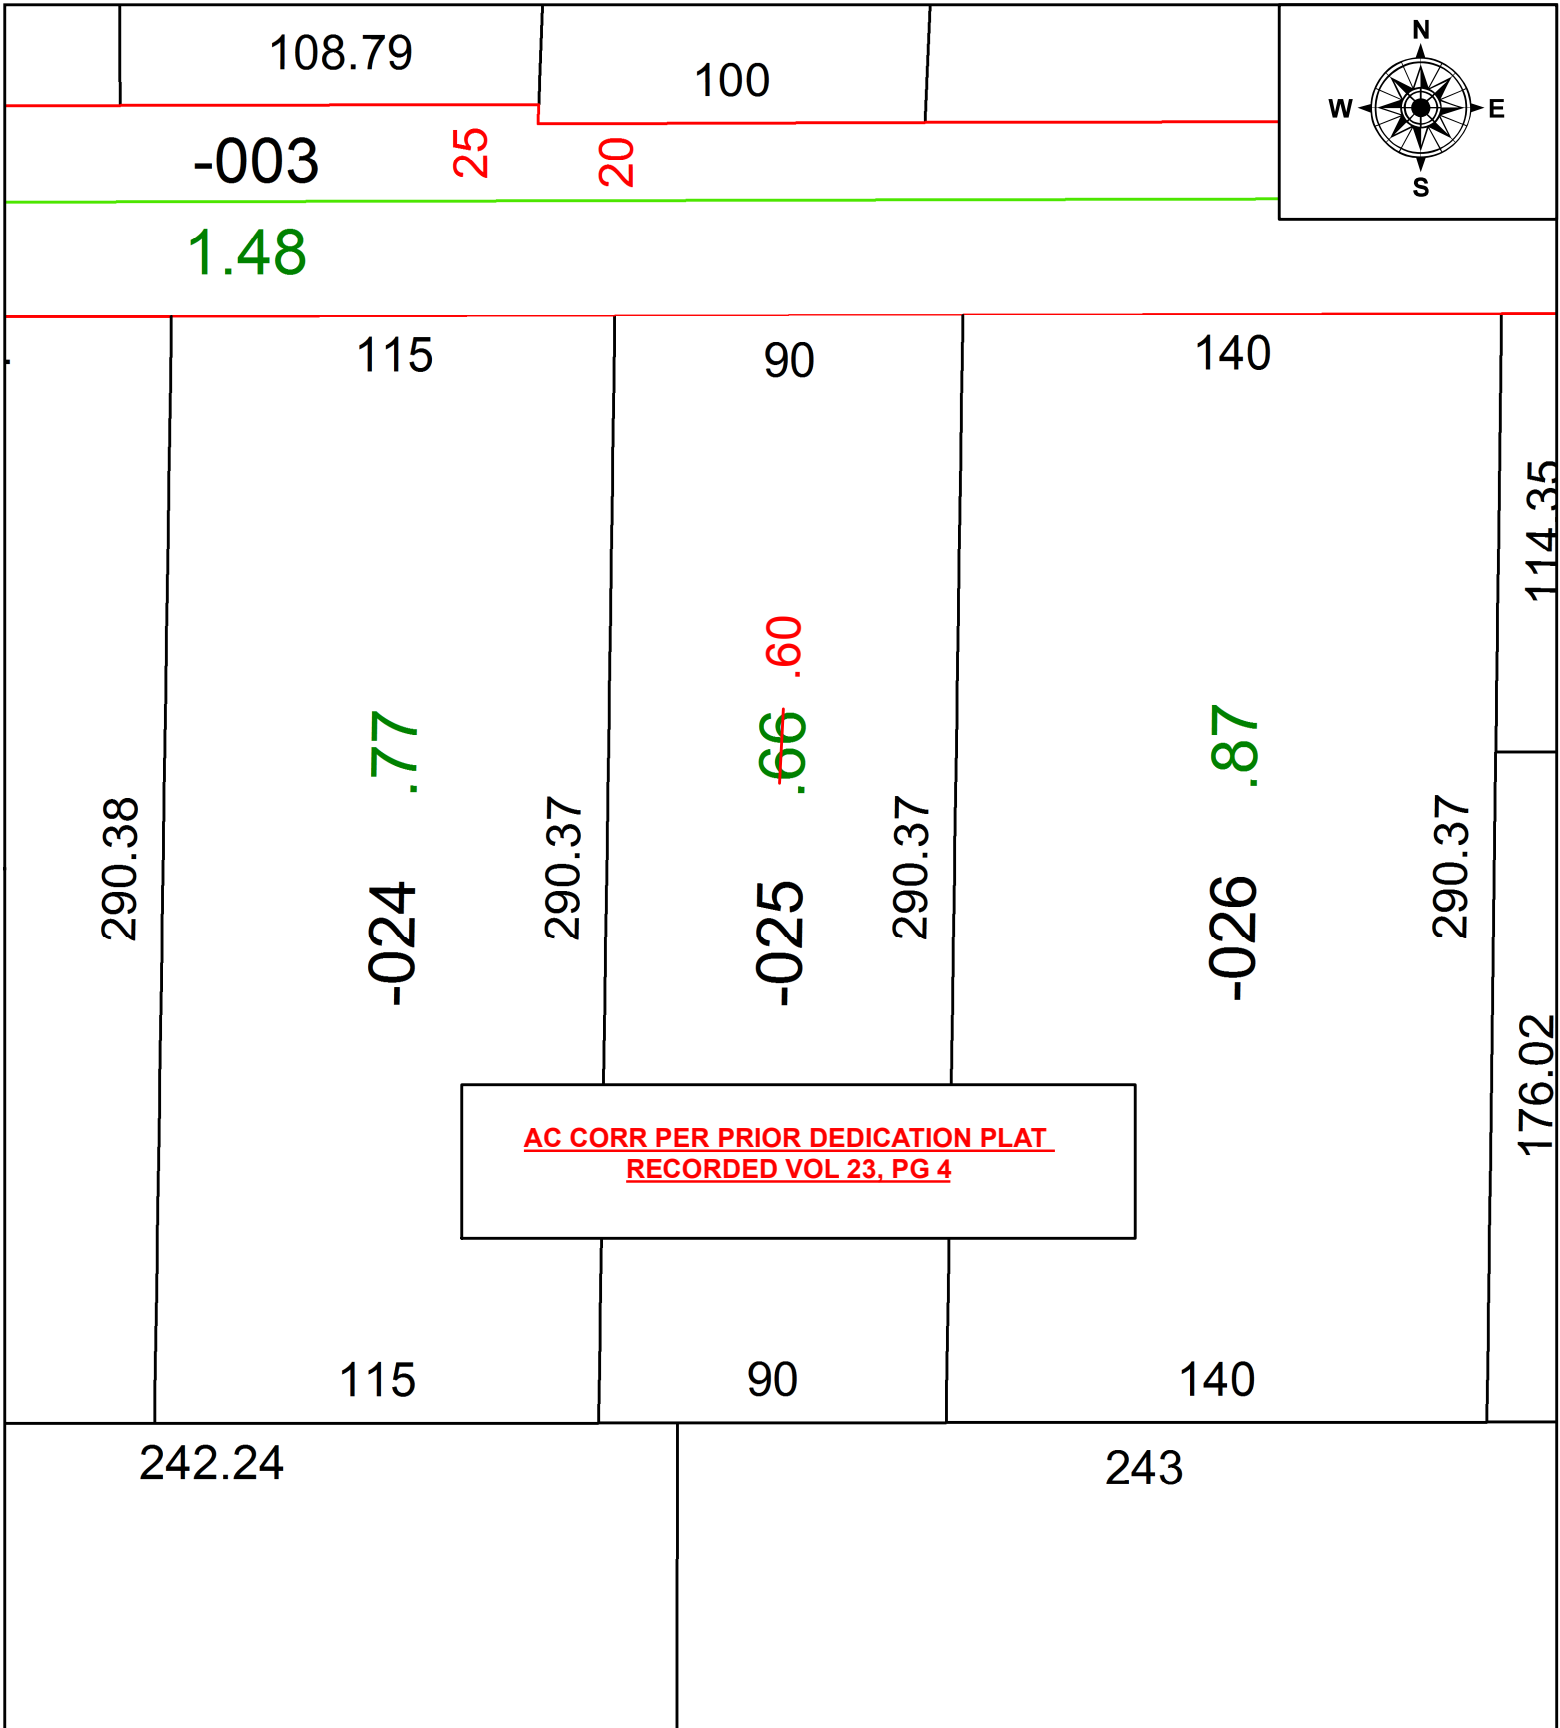

**AC CORR PER PRIOR DEDICATION PLAT
RECORDED VOL 23, PG 4**



SPLITS/DEEDS PROCESSED
LORAIN COUNTY TAX MAP DEPARTMENT
226 MIDDLE AVE. ELYRIA, OH

SURVEYED BY:	N/A
CLOSURE:	1: 35459
MAP PAGE(S):	07-00-028
APPROVED BY:	AC DATE: 5/10/2021
SCALE:	1" = 50 PRIOR INSTRUMENT: 2003-0911708