
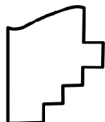


PARENT PARCEL: SEE SHEET ATTACHED

CHILD PARCEL: 06-25-167-000-006, 06-25-170-000-033, 06-25-171-101-029

STARTING POINT: CL OF CRESTVIEW DR. & CL OF GULF RD.

22-04545

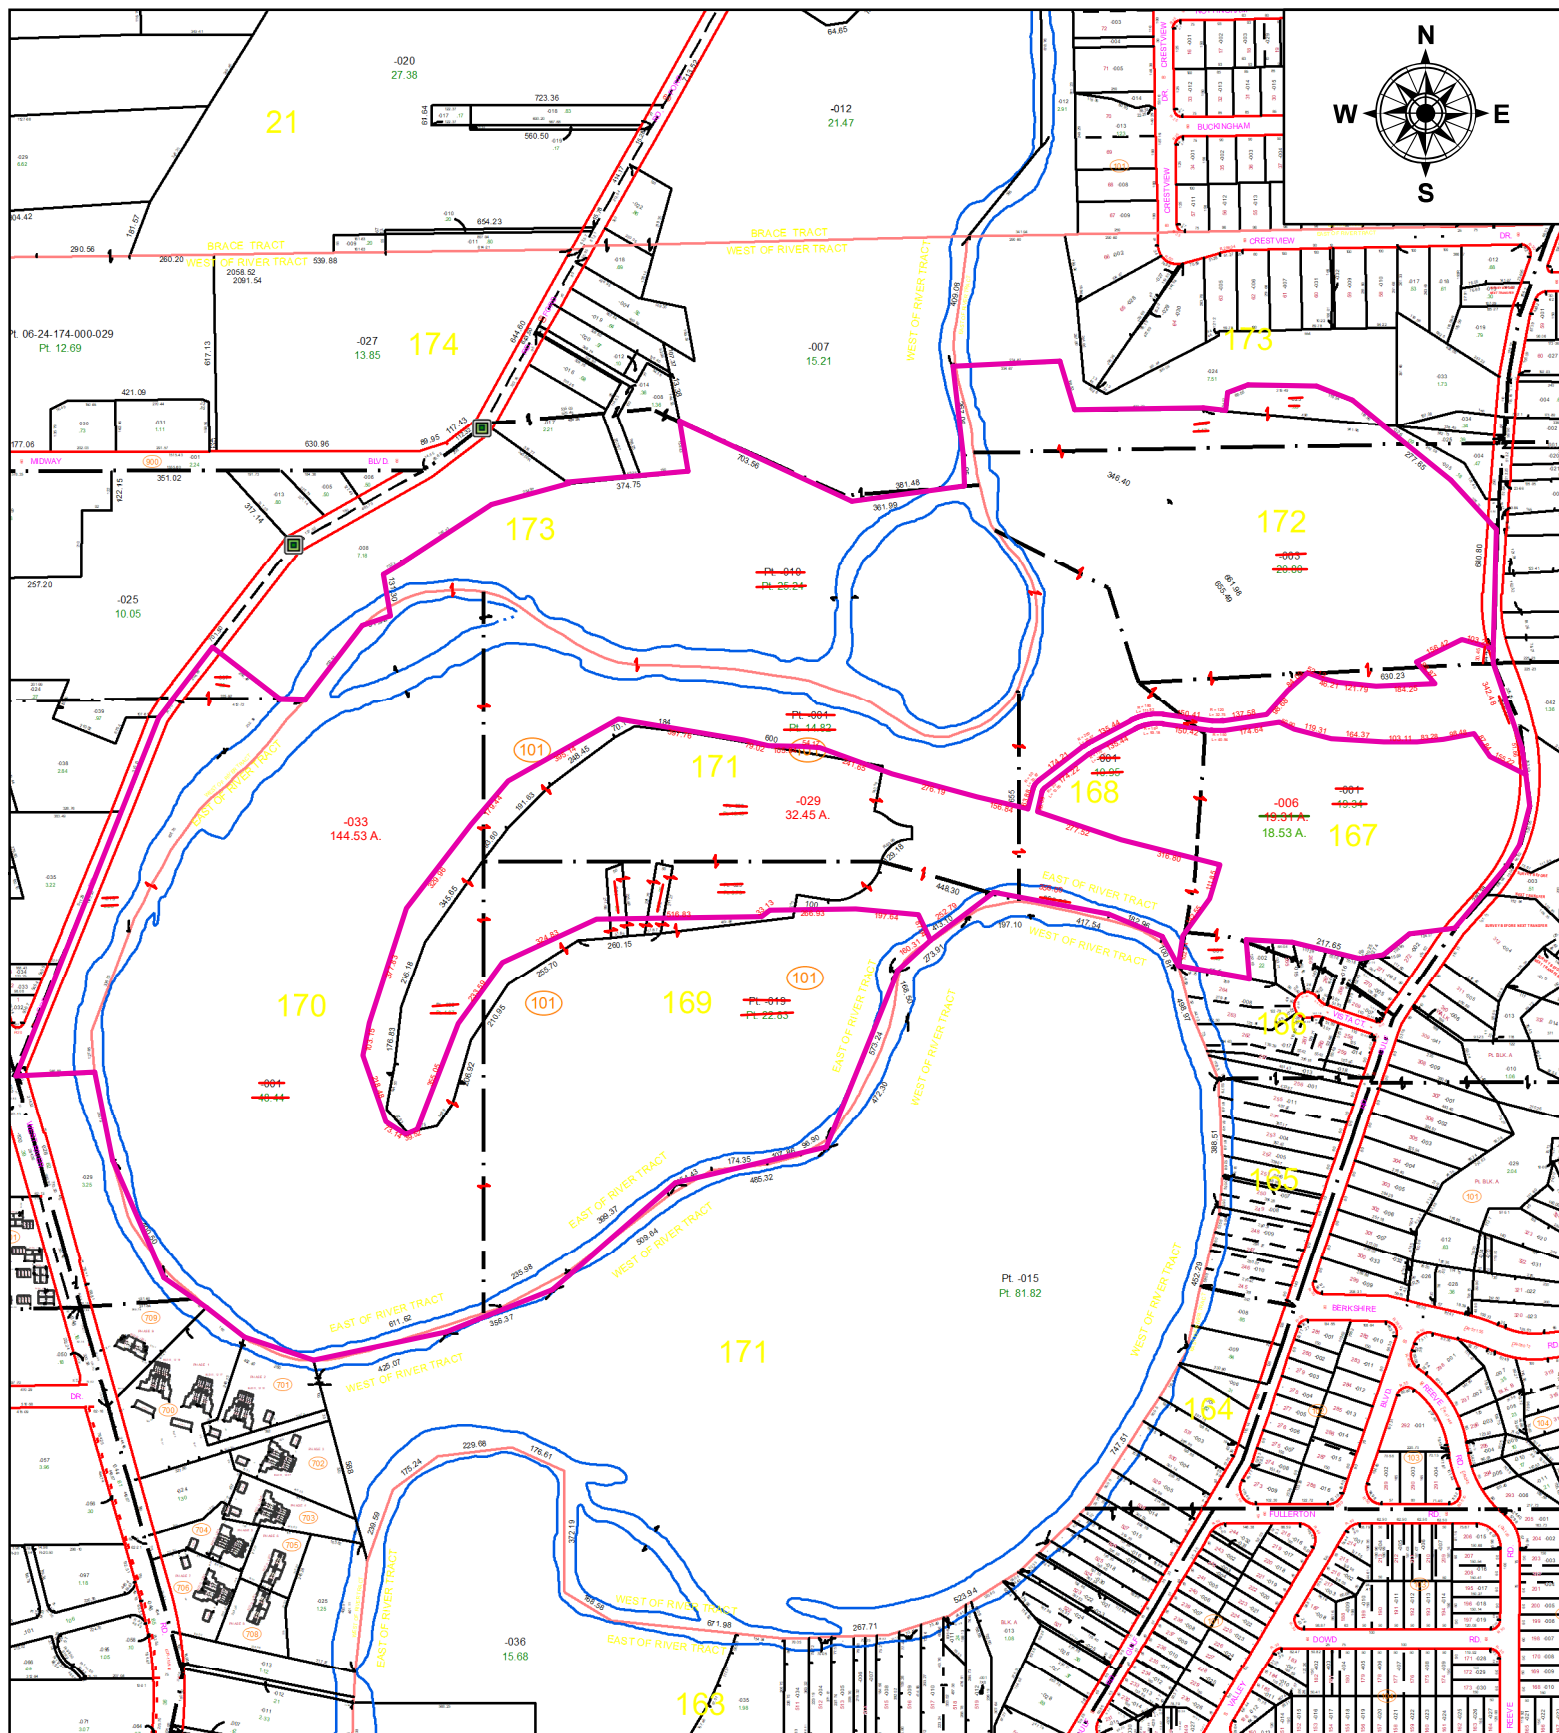

SPLITS/DEEDS PROCESSED
 LORAIN COUNTY TAX MAP DEPARTMENT
 226 MIDDLE AVE. ELYRIA, OH

SURVEYED BY: AMY KELLY
CLOSURE: 1: INF
MAP PAGE(S): MANY
APPROVED BY: TJS **DATE:** 10/4/2022
SCALE: 1" = 600' **PRIOR INSTRUMENT:** 2021-085276