
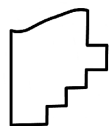


PARENT PARCEL: 17-07-004-000-007

CHILD PARCEL: _____

STARTING POINT: C/L OF VERMILION AND PECK-WADSWORTH ROAD

21-04547-A

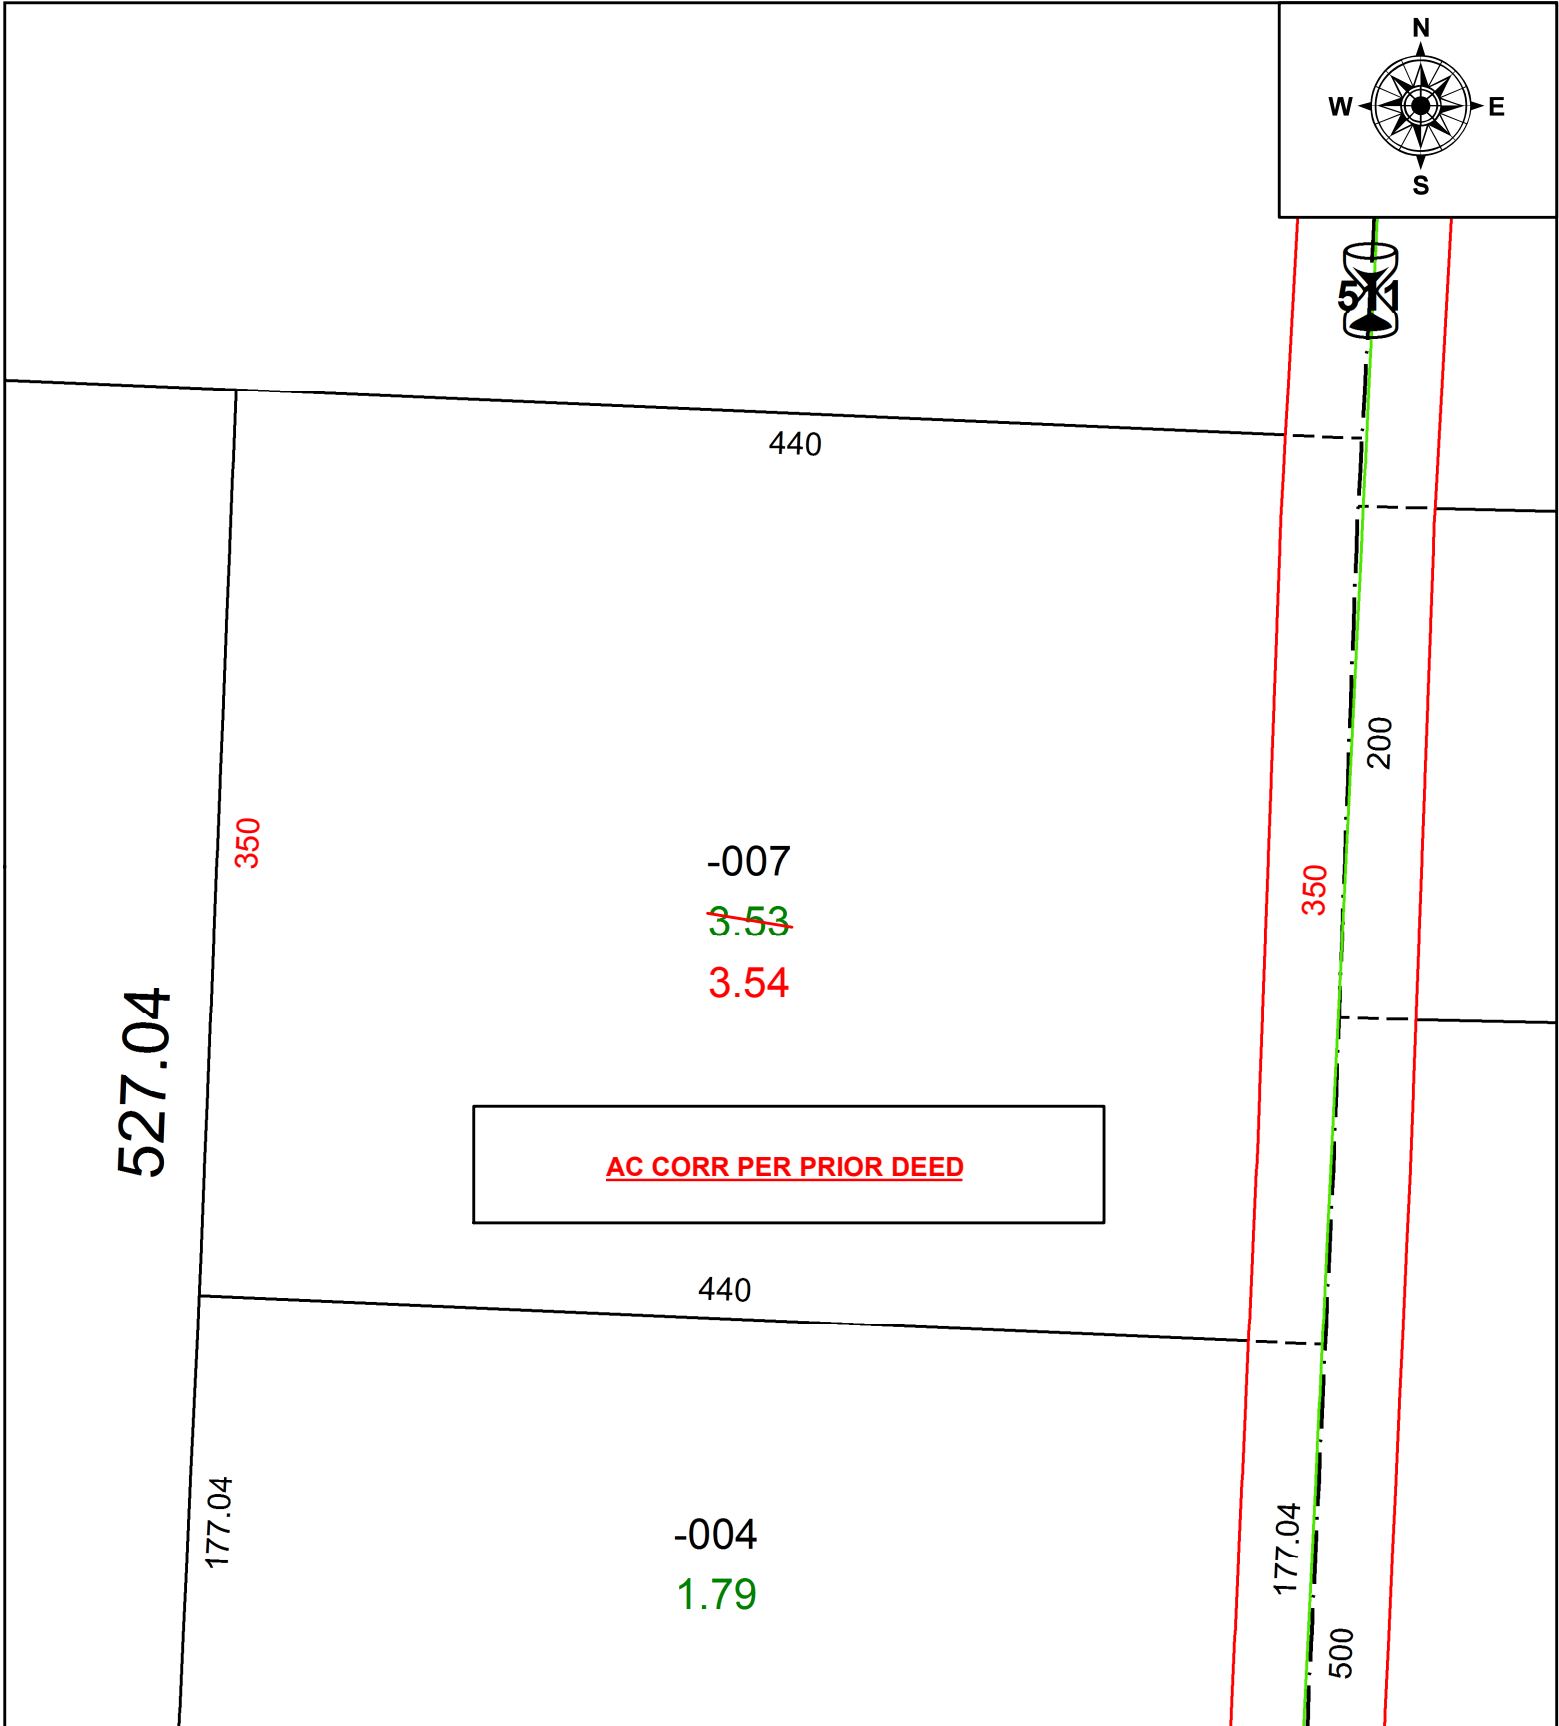

SPLITS/DEEDS PROCESSED
 LORAIN COUNTY TAX MAP DEPARTMENT
 226 MIDDLE AVE. ELYRIA, OH

SURVEYED BY: _____ N/A
 CLOSURE: _____ 1:2147483648
 MAP PAGE(S): _____ 17-07-004
 APPROVED BY: _____ AC DATE: _____ 5/10/2021
 SCALE: _____ 1" = 75 PRIORITY INSTRUMENT: _____ 2017-0639911