


PARENT PARCEL: 19-04-011-000-003

CHILD PARCEL: _____

STARTING POINT: C/L OF SR 18 AND INDIAN HOLLOW ROAD

21-04552-A

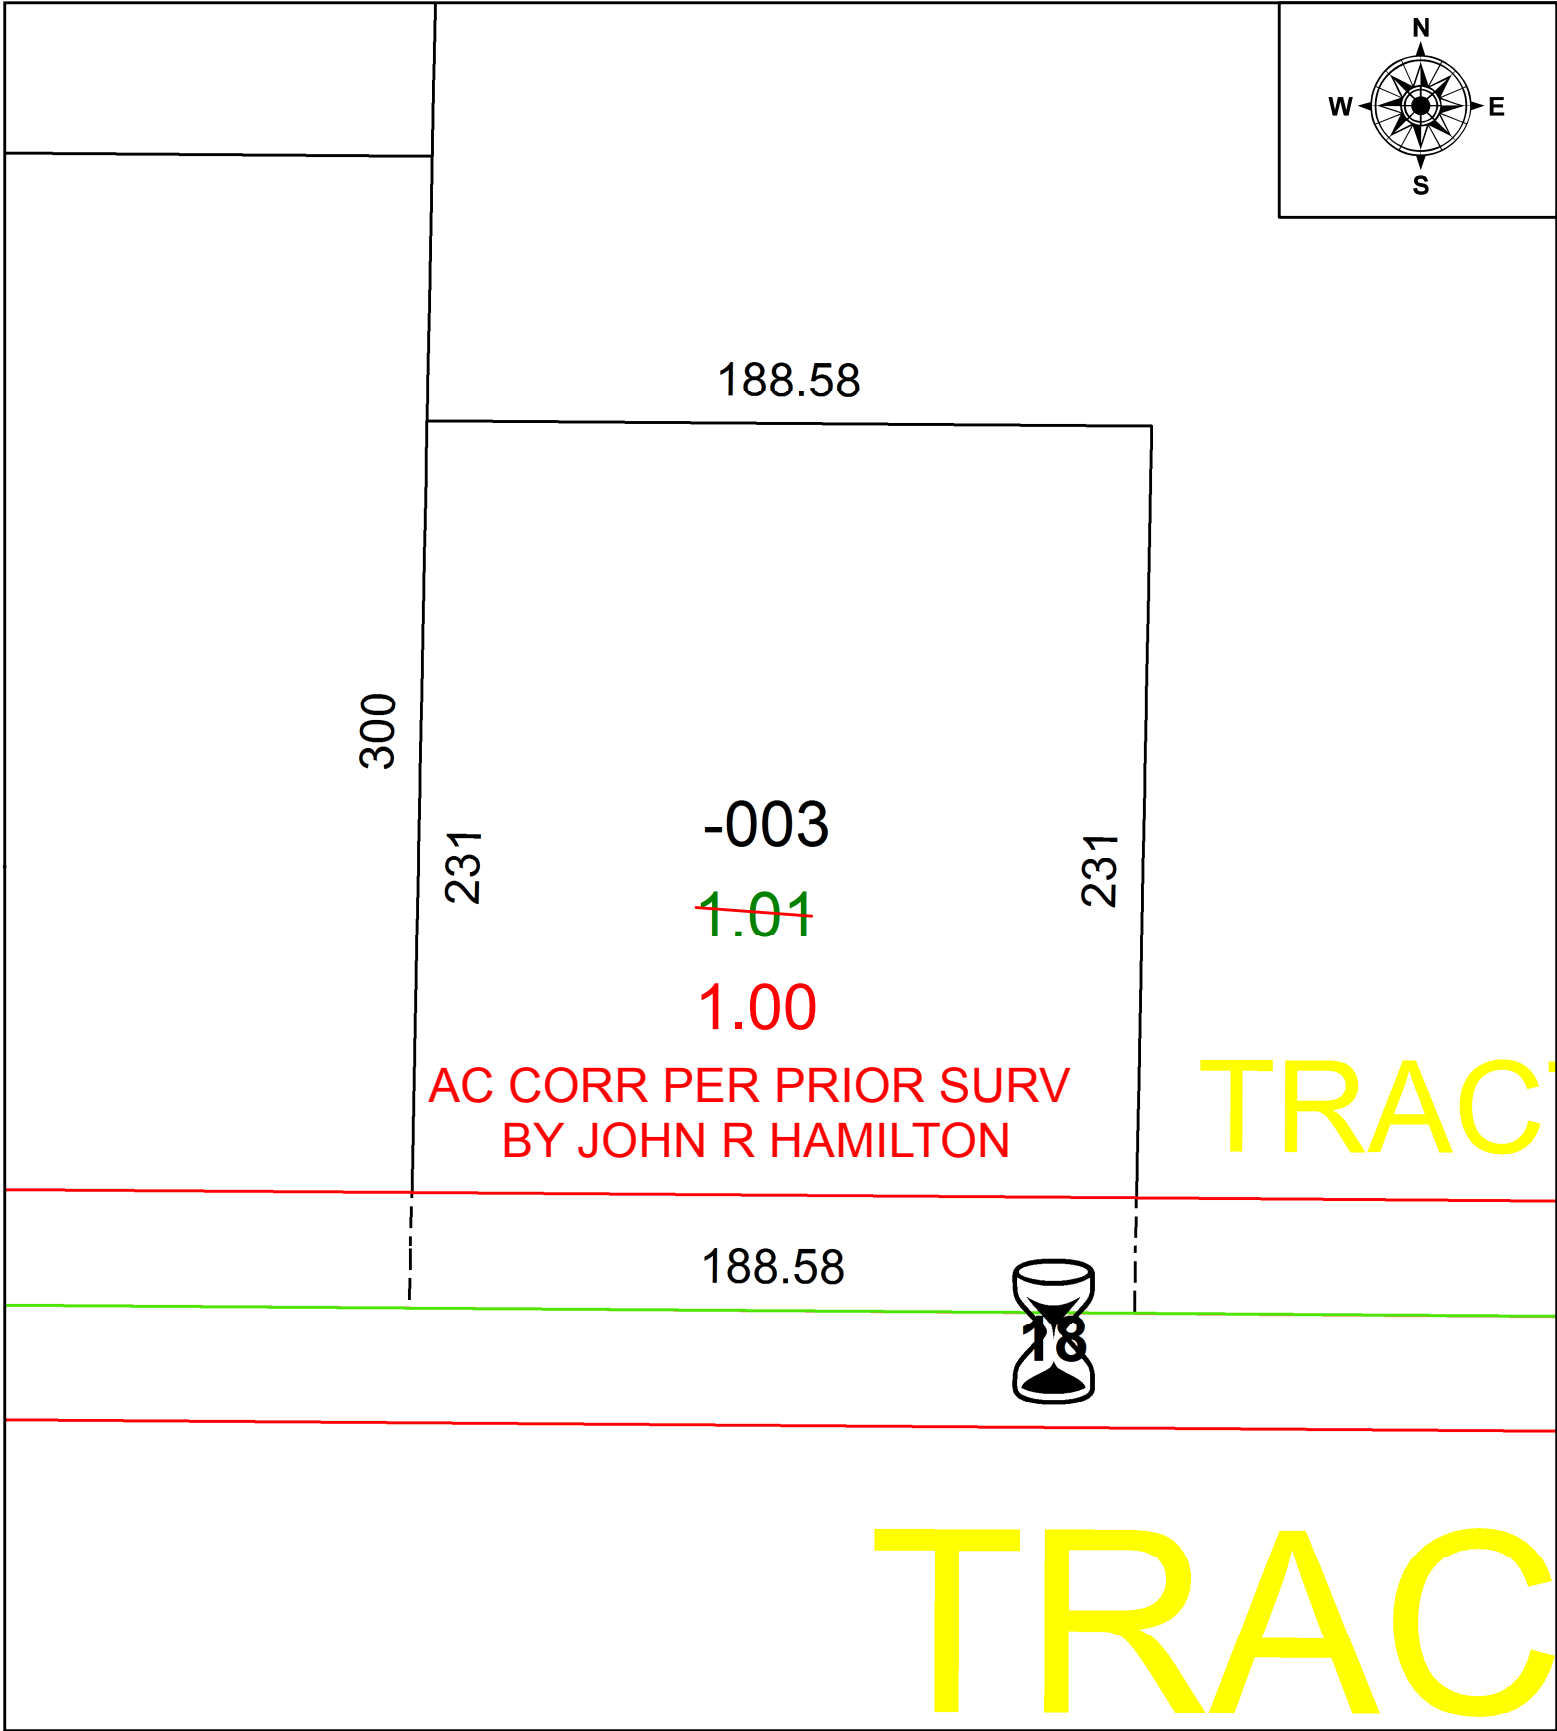

300

188.58

231

-003

~~1.01~~

1.00

231


AC CORR PER PRIOR SURV
BY JOHN R HAMILTON

TRAC

188.58



TRAC

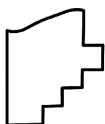

SPLITS/DEEDS PROCESSED
LORAIN COUNTY TAX MAP DEPARTMENT
226 MIDDLE AVE. ELYRIA, OH

SURVEYED BY: JOHN R. HAMILTON

CLOSURE: 1: 832956

MAP PAGE(S): 19-04-011-A

APPROVED BY: AC DATE: 5/13/2021

SCALE: 1" = 50 PRIOR INSTRUMENT: 2020-0775385