


PARENT PARCEL: 01-00-004-105-007, -015, & -016

CHILD PARCEL: 01-00-004-105-021

N/A

22-04554

STARTING POINT: N/A

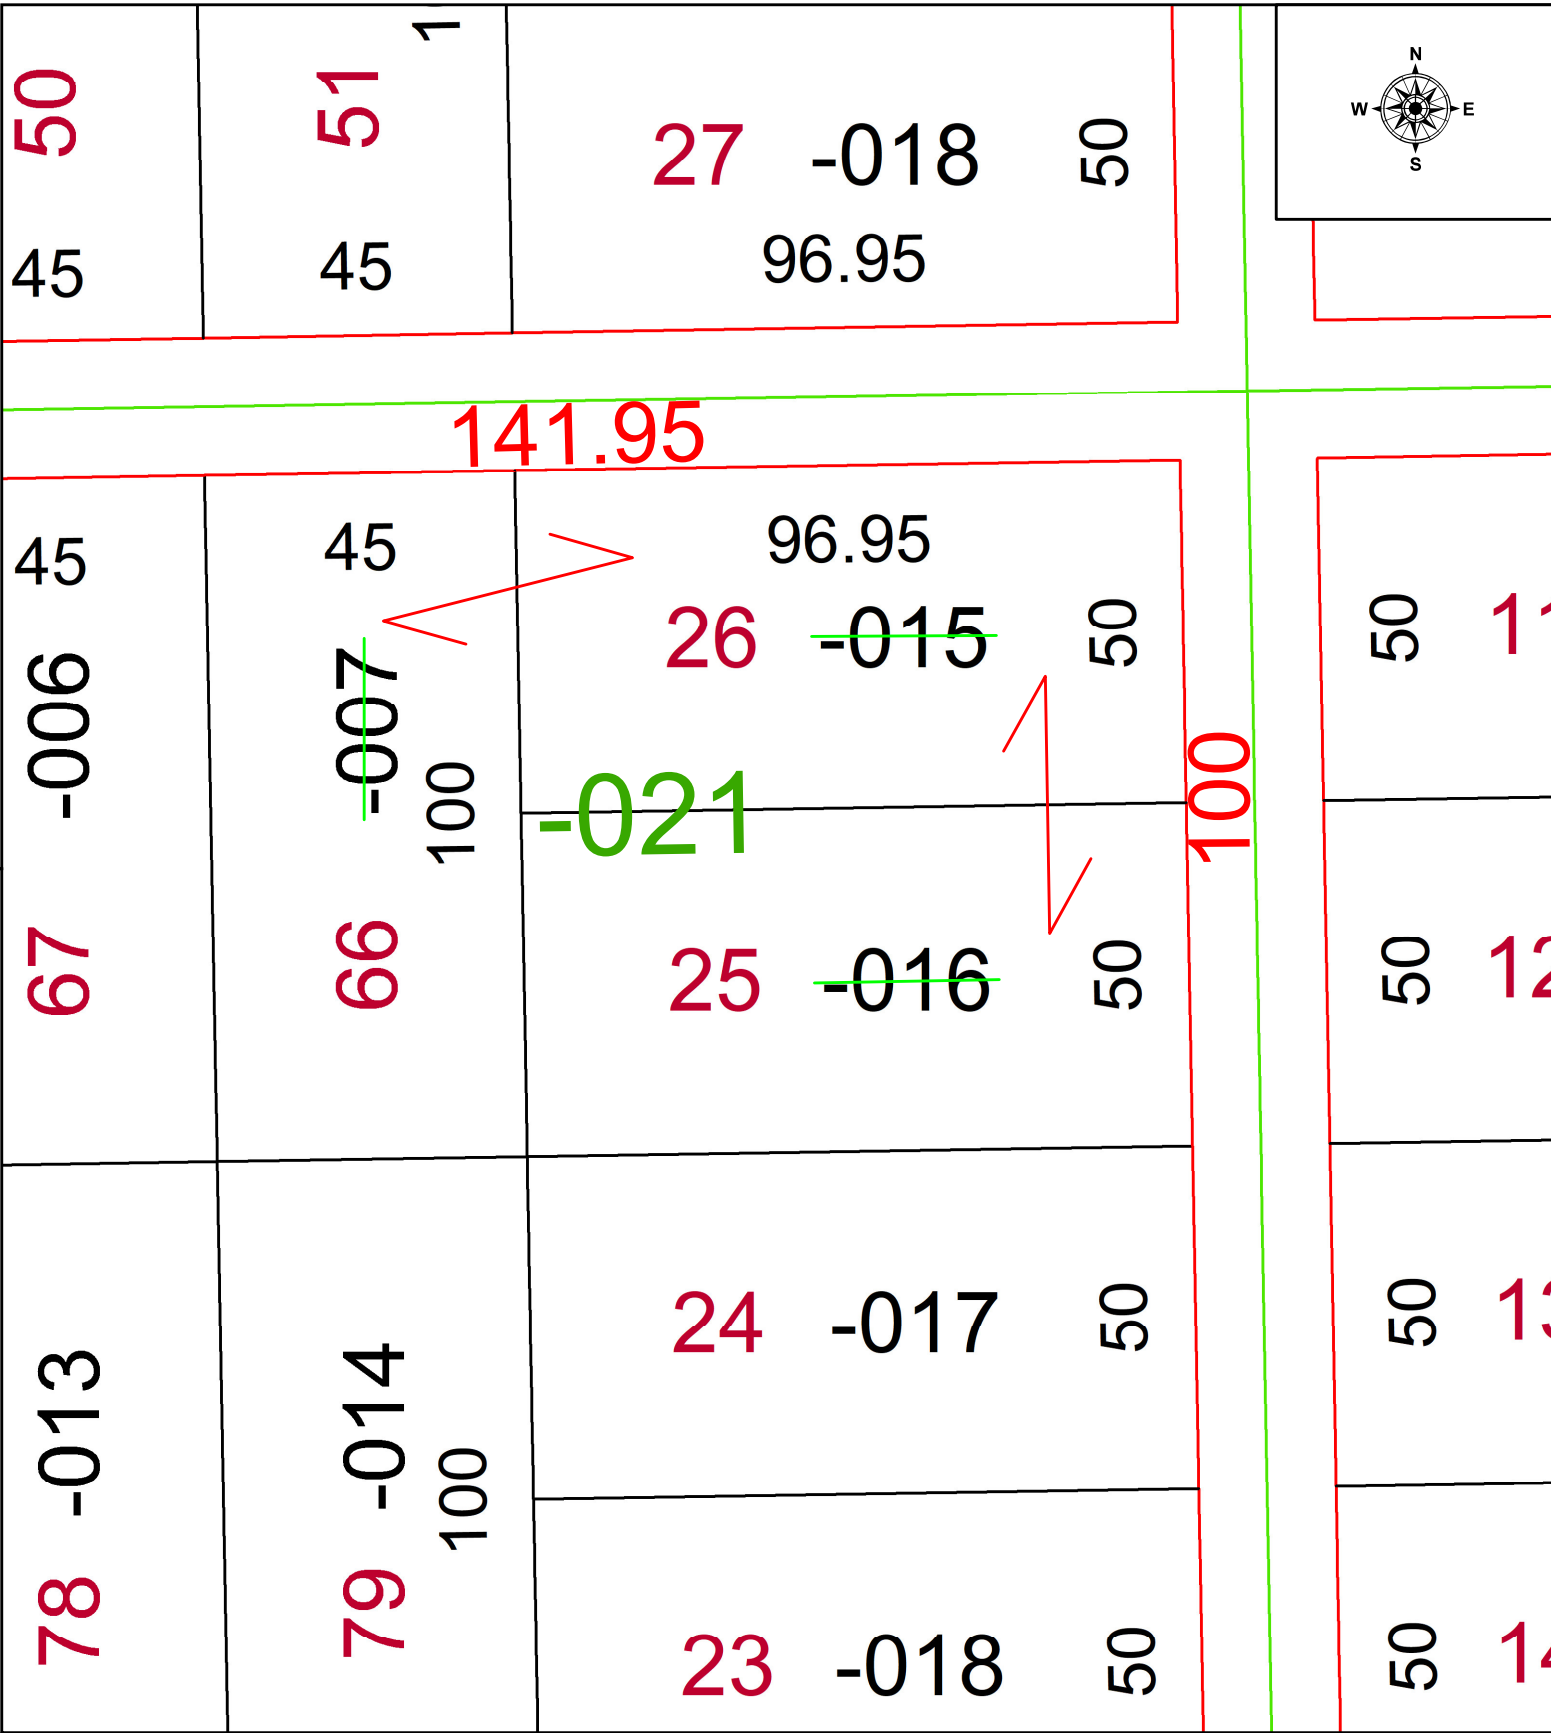

**SPLITS/DEEDS PROCESSED**  
 LORAIN COUNTY TAX MAP DEPARTMENT  
 226 MIDDLE AVE. ELYRIA, OH

SURVEYED BY: PATRICK MCGANNON

SURVEY # N/A

CLOSURE: N/A

MAP PAGE(S): 01-00-004

APPROVED BY: WRZ DATE: 9/16/2022

SCALE: 1" = 50 PRIOR INSTRUMENT: #2018-0657493