


PARENT PARCEL: 07-00-007-108-024 & 07-00-007-109-006 THRU -010

CHILD PARCEL: 07-00-007-108-029

N/A

22-04556

STARTING POINT: NORTHWEST CORNER OF S/L 17

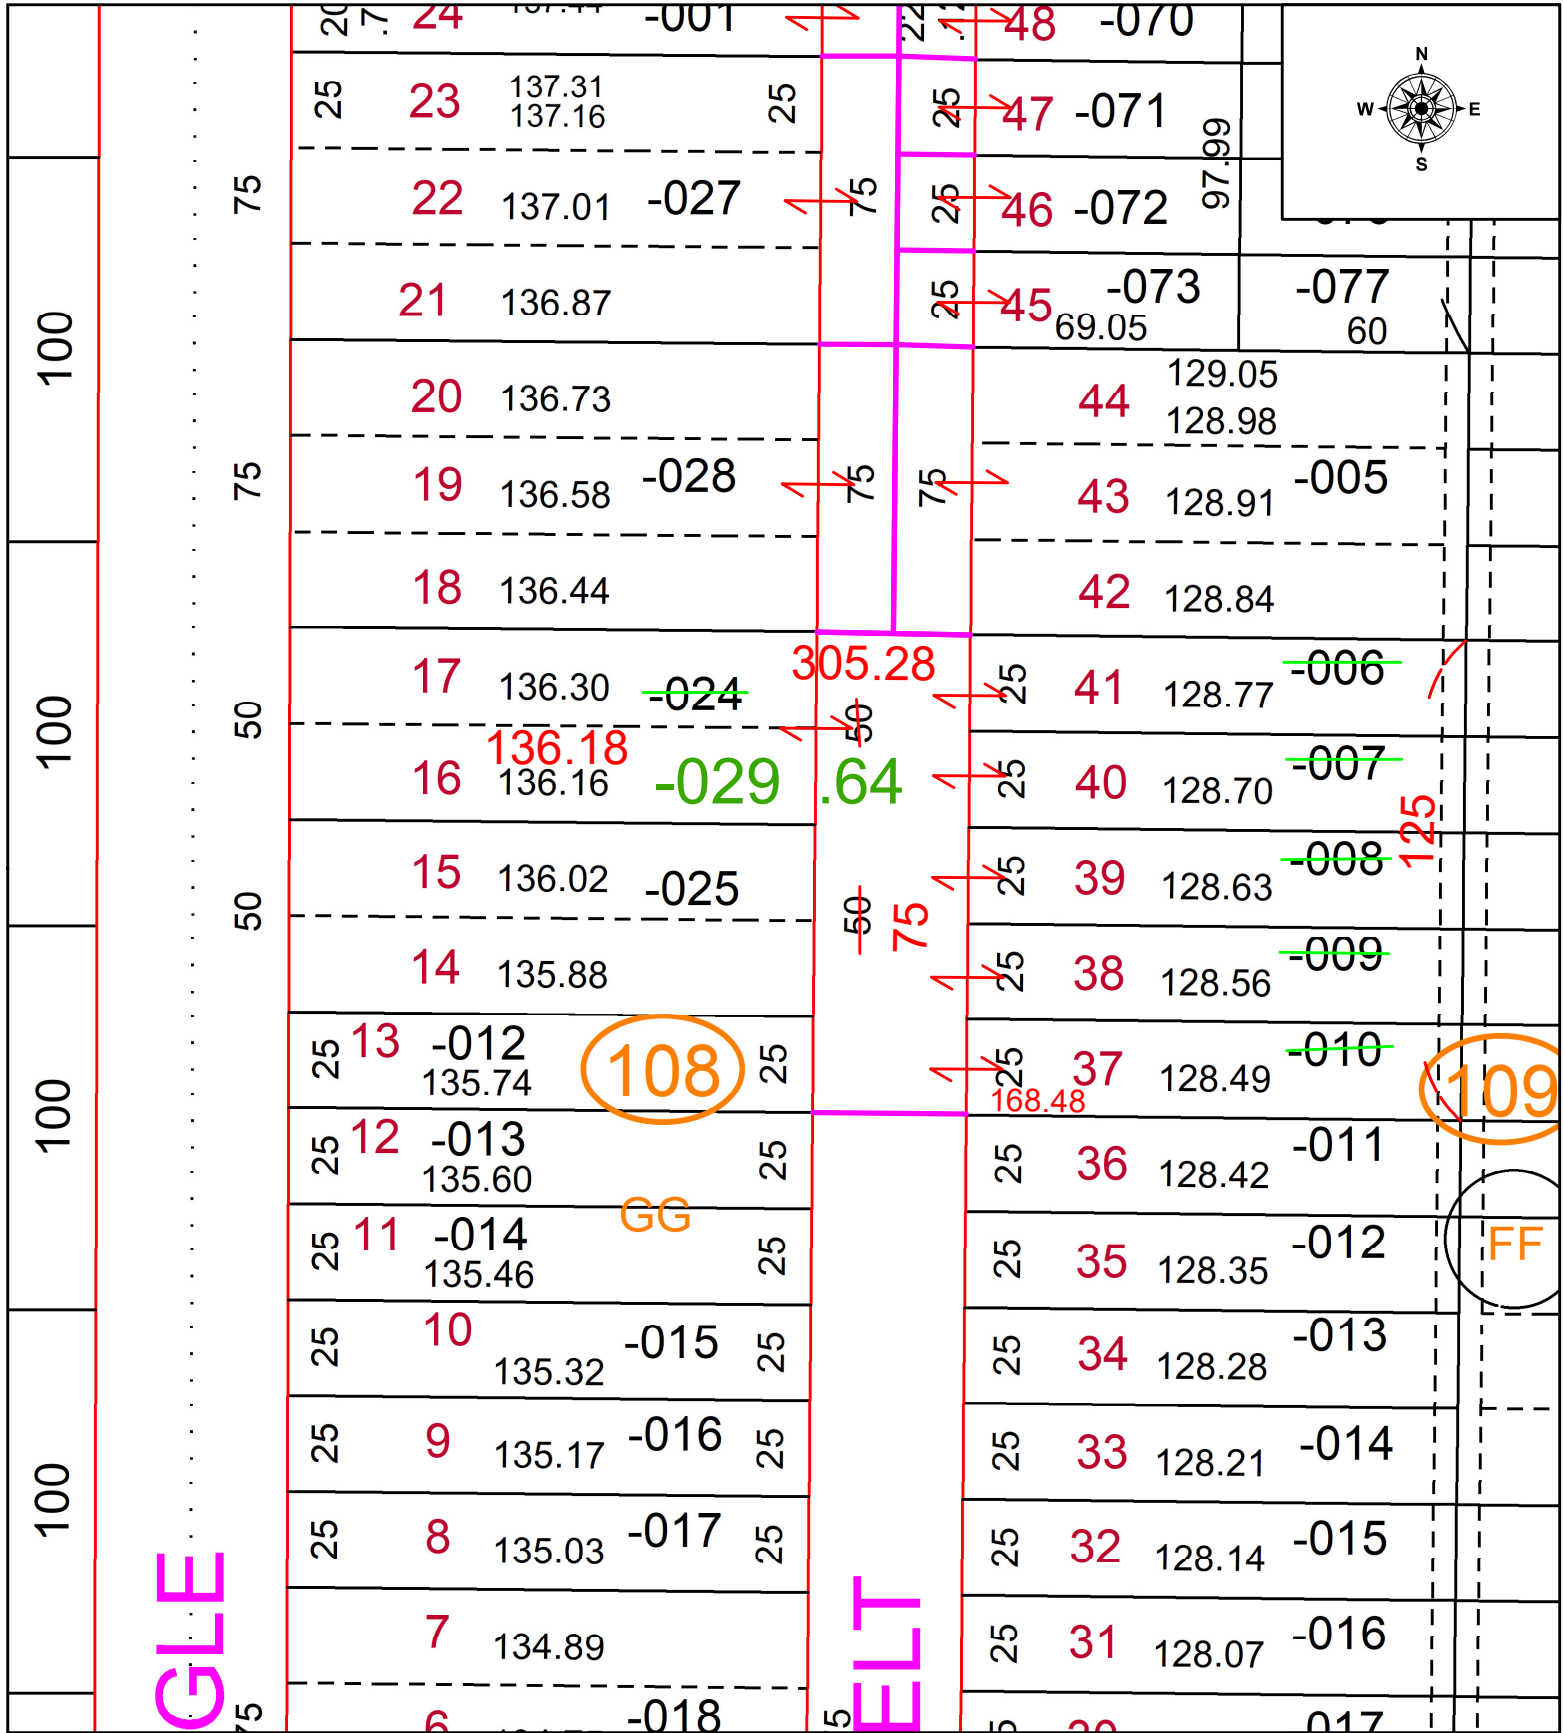

**SPLITS/DEEDS PROCESSED**  
LORAIN COUNTY TAX MAP DEPARTMENT  
226 MIDDLE AVE. ELYRIA, OH

SURVEYED BY:	WILFREDO BARBOSA	SURVEY #	50788
CLOSURE:	1: 91564		
MAP PAGE(S):	07-00-007		
APPROVED BY:	WRZ	DATE:	1/20/2023
SCALE:	1" = 50	PRIOR INSTRUMENT:	N/A