
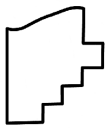


PARENT PARCEL: 01-00-066-000-037

CHILD PARCEL: 01-00-066-000-039 THRU -041

STARTING POINT: CL OF GORE ORPHANAGE RD. & NORTHERLY LINE O.L. 66

22-04557

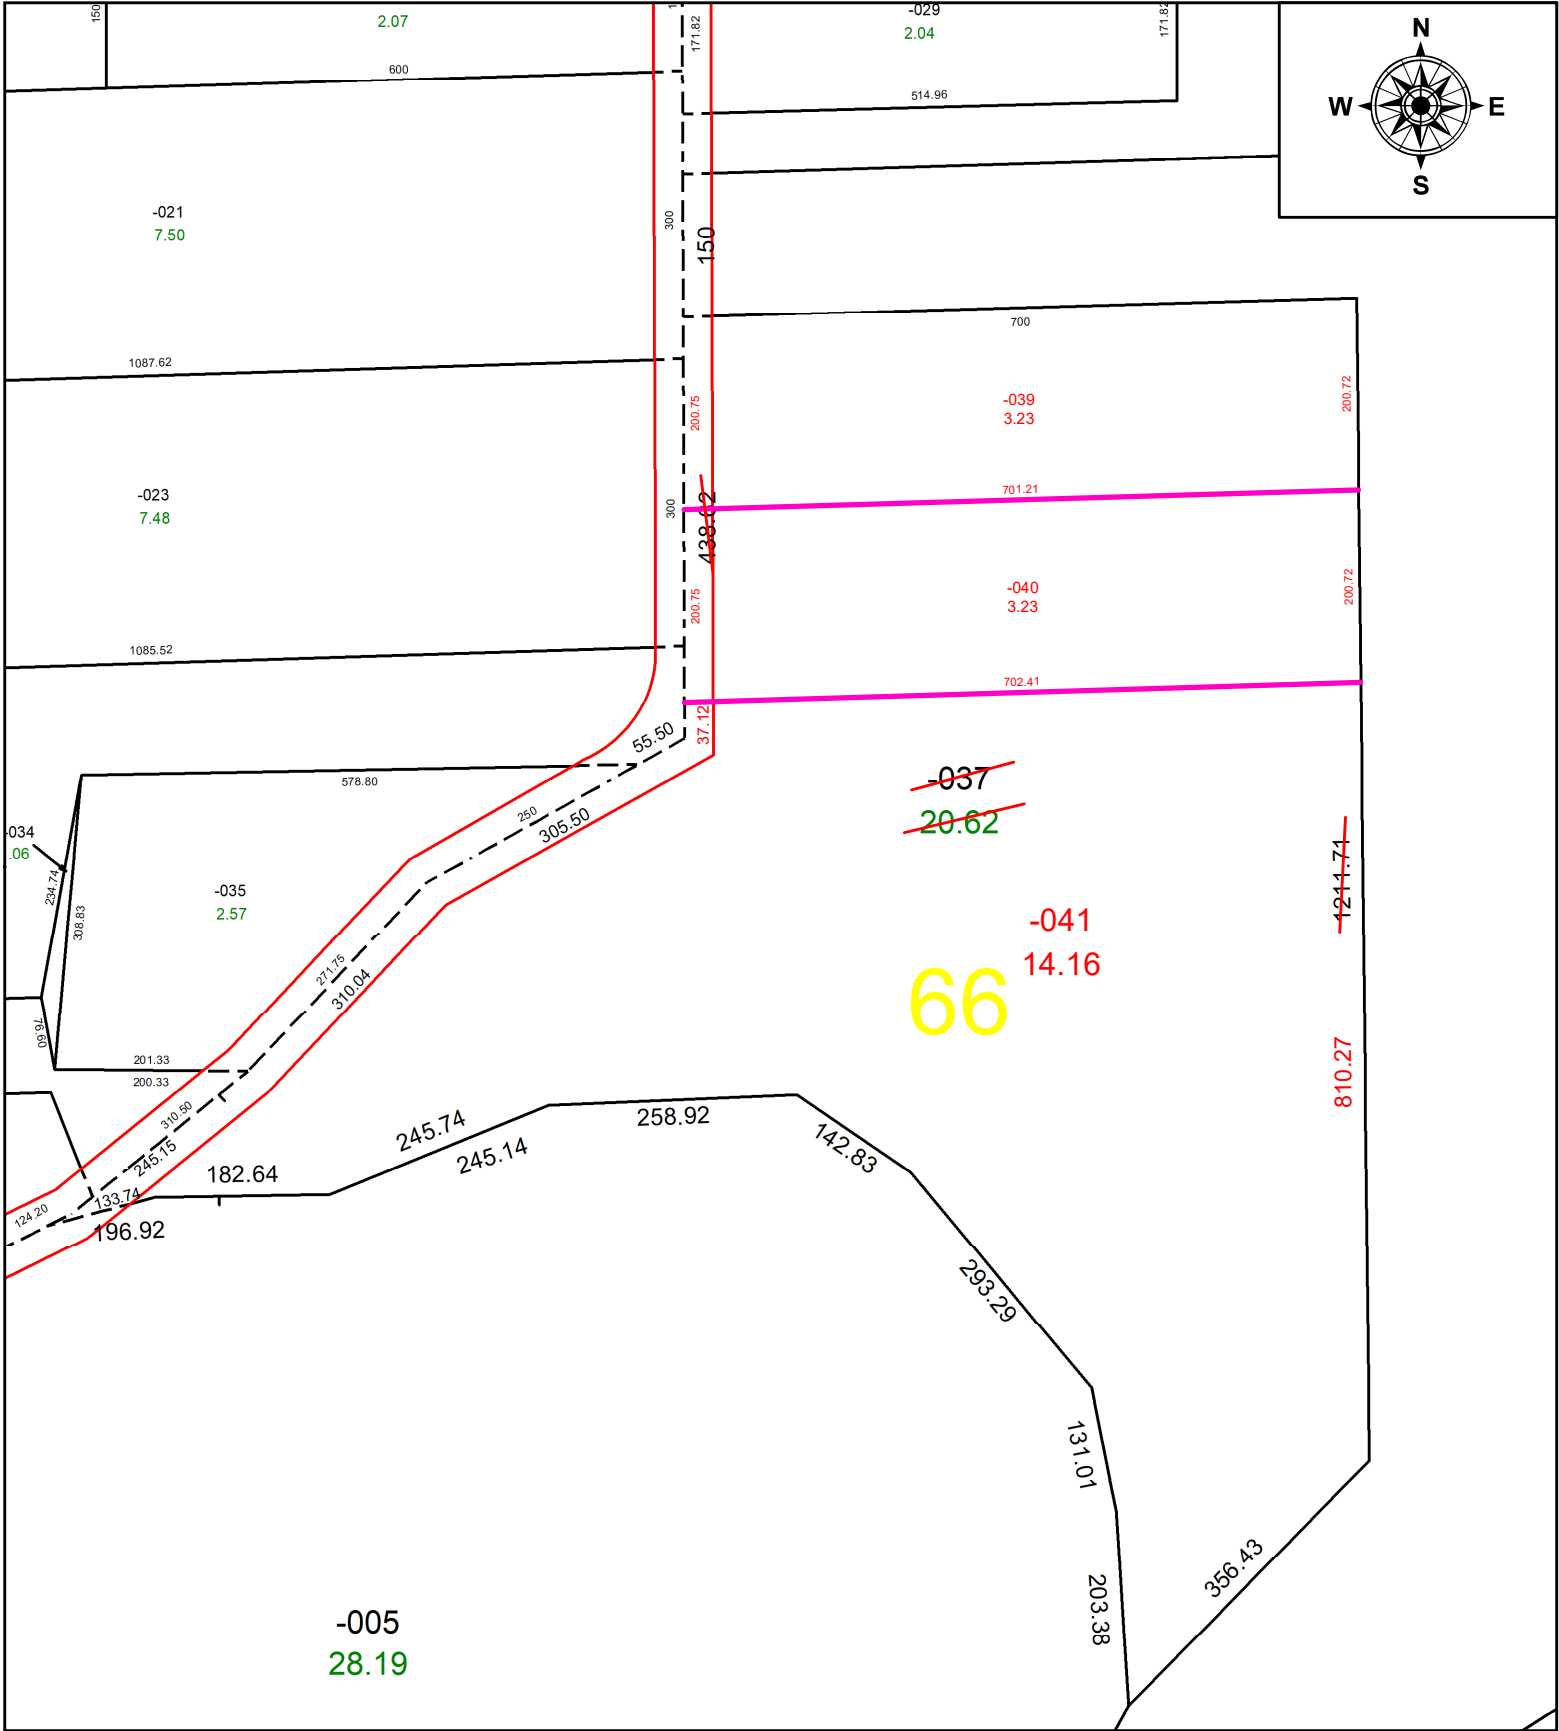

SPLITS/DEEDS PROCESSED
 LORAIN COUNTY TAX MAP DEPARTMENT
 226 MIDDLE AVE. ELYRIA, OH

SURVEYED BY: JOHN DECHANT JR. **SURVEY #:** 50694
CLOSURE: 1:324061
MAP PAGE(S): 01-00-066
APPROVED BY: DMA **DATE:** 9/21/2022
SCALE: 1" = 200' **PRIOR INSTRUMENT:** 2022-0860387