




PARENT PARCEL: 15-00-098-107-015 & -039

CHILD PARCEL: 15-00-098-107-040 THRU -042

N/A

22-04560

STARTING POINT: SOUTHEASTERLY CORNER OF S/L 361 PHEASANT RUN VILLAGE PHASE NO. 1

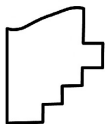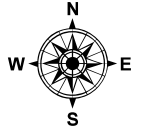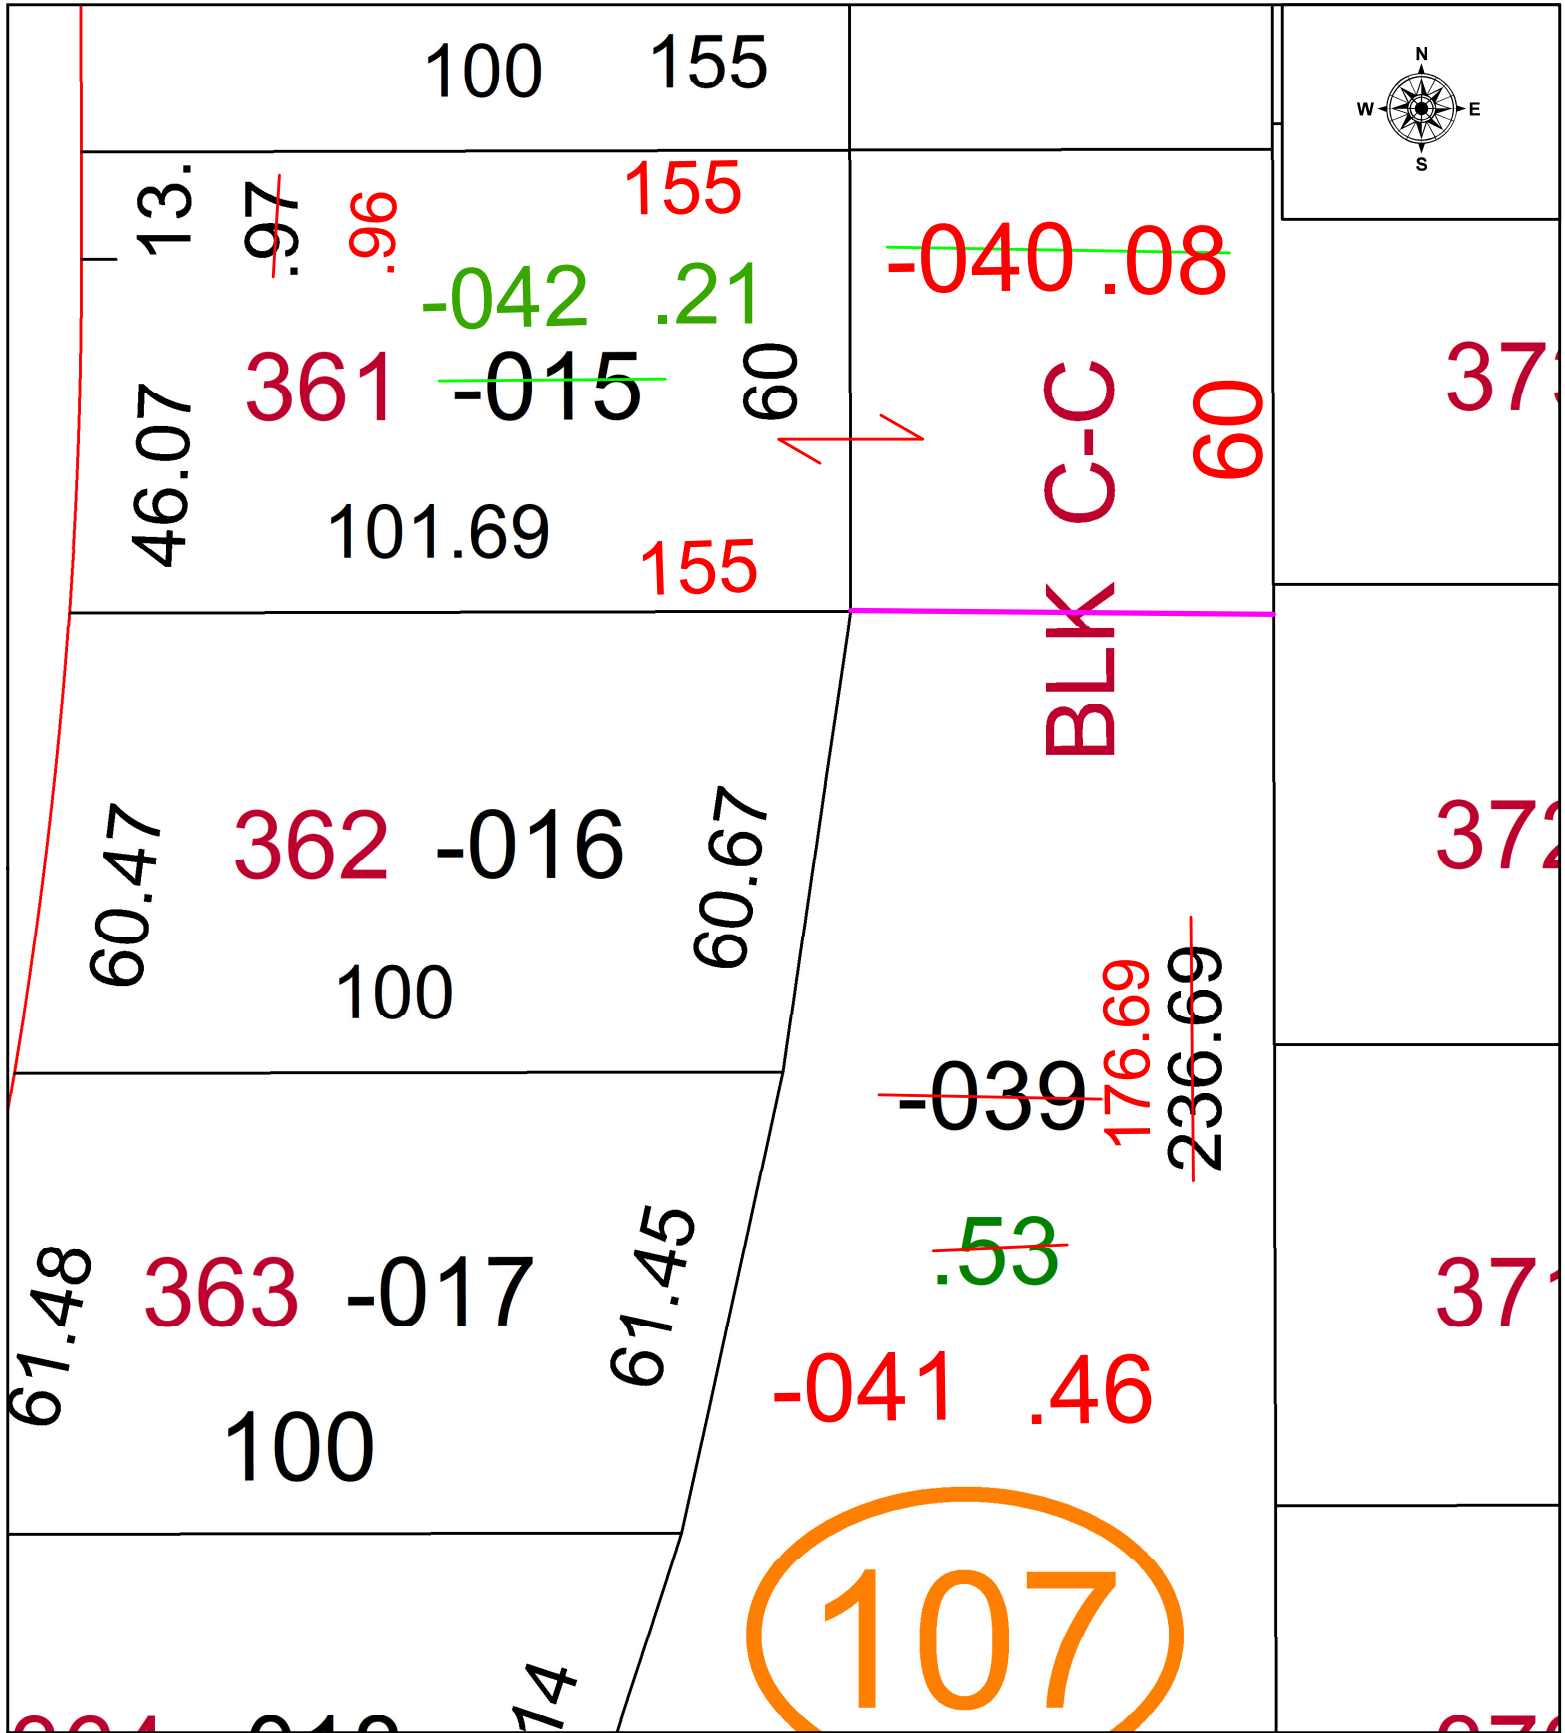

SPLITS/DEEDS PROCESSED
 LORAIN COUNTY TAX MAP DEPARTMENT
 226 MIDDLE AVE. ELYRIA, OH

SURVEYED BY: THOMAS SIMON SURVEY # 50699
 CLOSURE: 1: -2147483648
 MAP PAGE(S): 15-00-098
 APPROVED BY: WRZ DATE: 9/27/2022
 SCALE: 1" = 25 PRIOR INSTRUMENT: #2022-0887337