

PARENT PARCEL: 12-00-080-000-009


CHILD PARCEL: _____

STARTING POINT: C/L OF SPRAGUE ROAD AND NW CORNER OF O/L 80

21-04562-A



COLUMBIA TWP

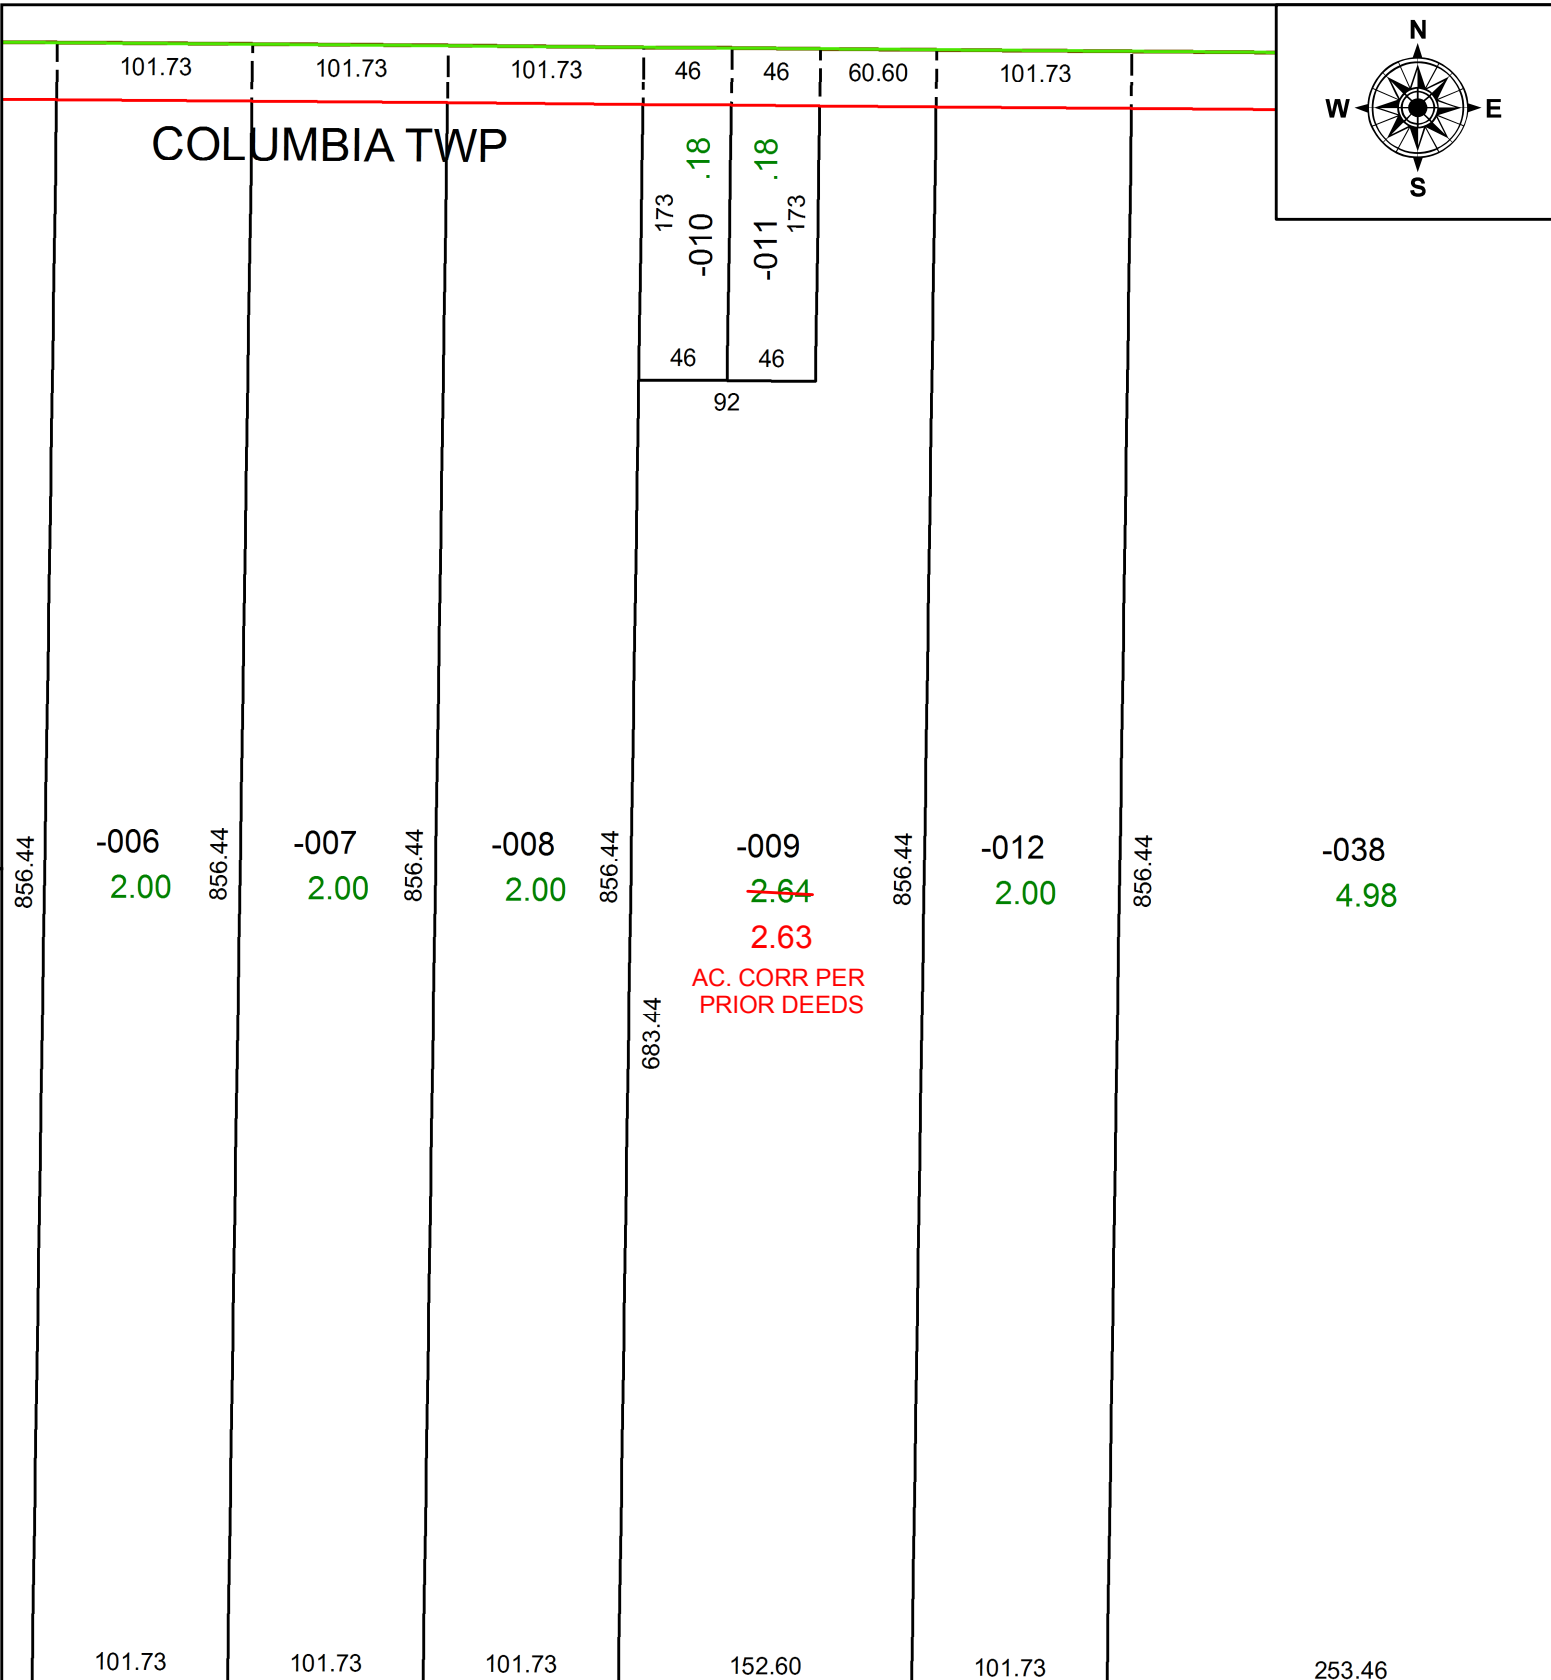

856.44

-006
2.00

856.44

-007
2.00

856.44

-008
2.00

856.44

683.44

-009
~~2.64~~
2.63

AC. CORR PER
PRIOR DEEDS

856.44

-012
2.00

856.44

-038
4.98

101.73

101.73


101.73

152.60

101.73

253.46

2556.51

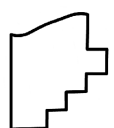

SPLITS/DEEDS PROCESSED
LORAIN COUNTY TAX MAP DEPARTMENT
226 MIDDLE AVE. ELYRIA, OH

SURVEYED BY: _____ N/A

CLOSURE: 1: 2147483648

MAP PAGE(S): 12-00-080-A

APPROVED BY: _____ AC DATE: 5/18/2021

SCALE: 1" = 100 PRIOR INSTRUMENT: 2020-0783701