
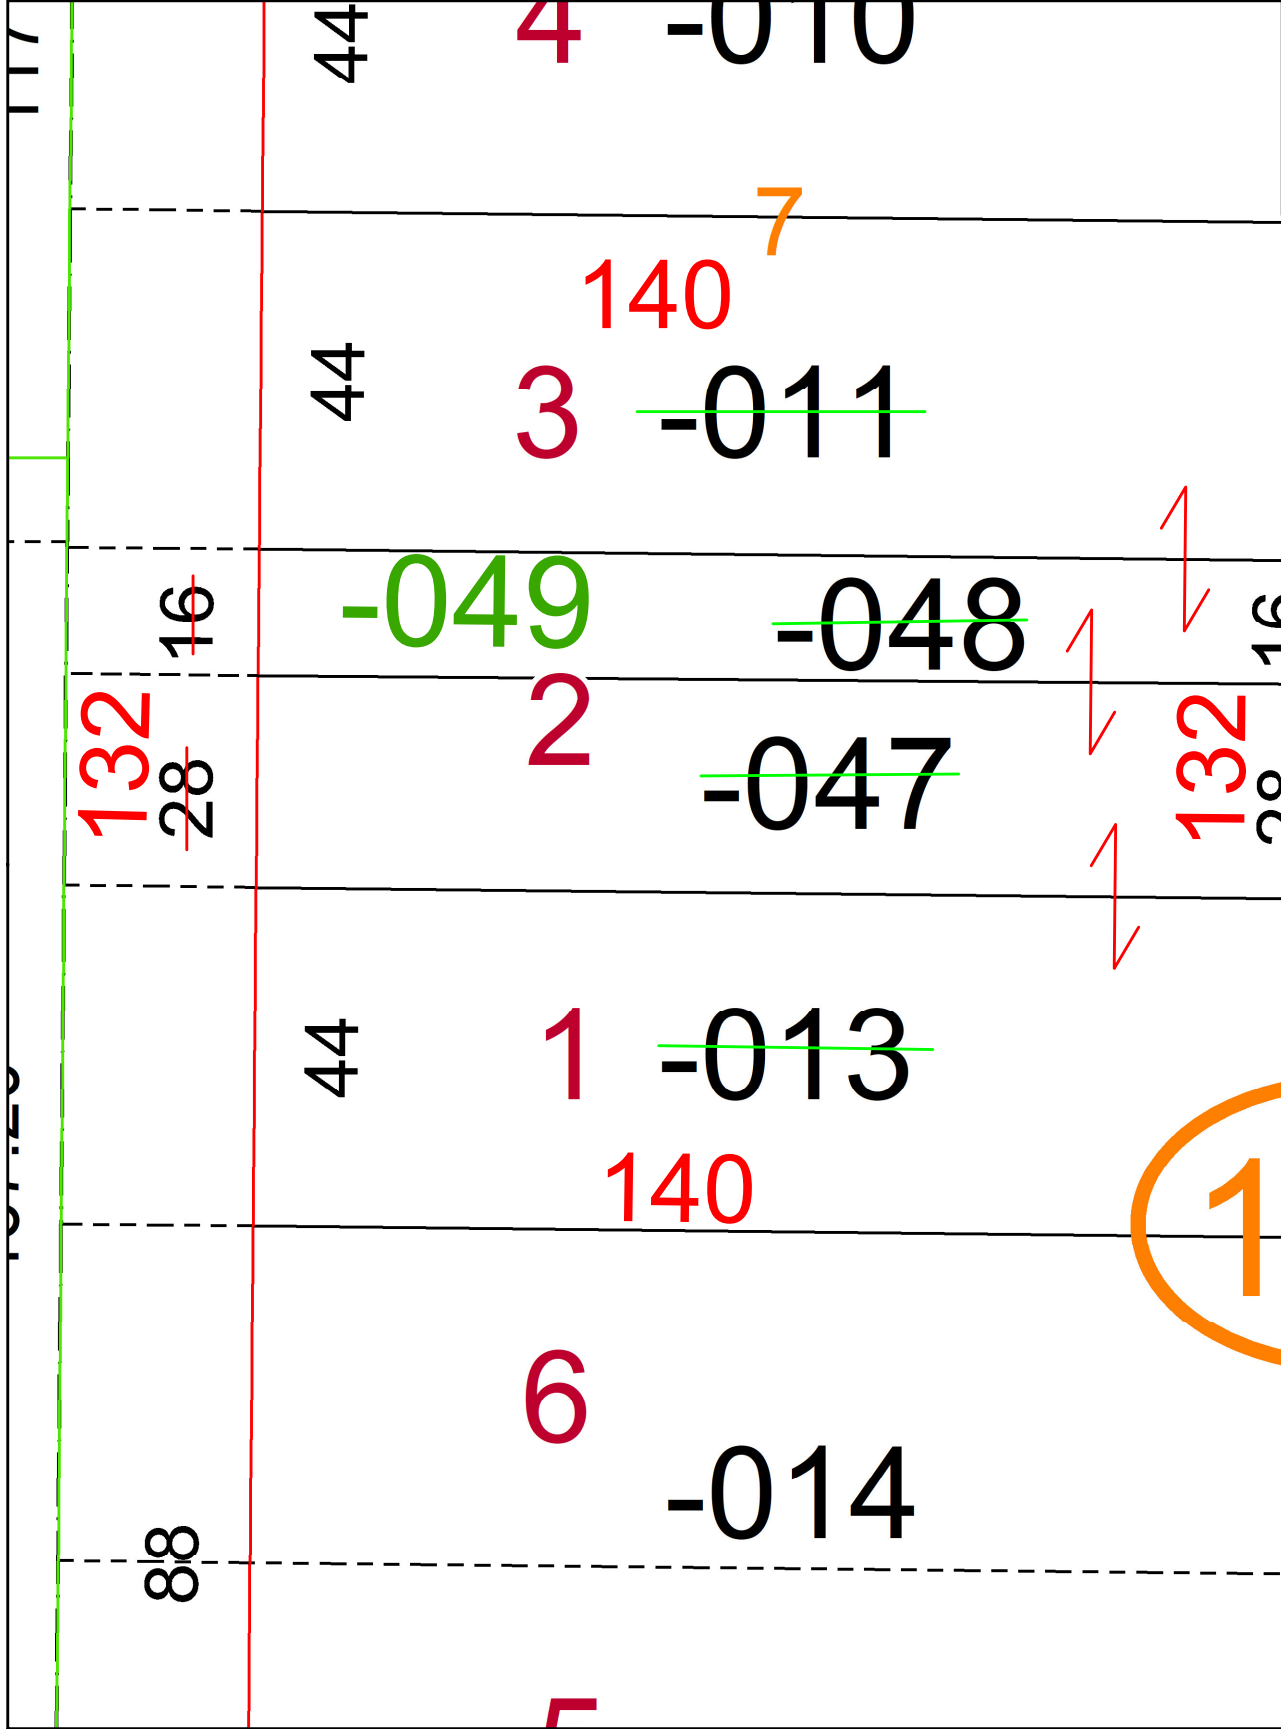


PARENT PARCEL: 06-25-022-105-011, -013, -047, & -048


CHILD PARCEL: 06-25-022-105-049

STARTING POINT: N/A

22-04563

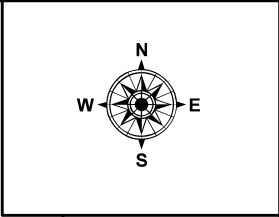

105

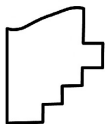

SPLITS/DEEDS PROCESSED
LORAIN COUNTY TAX MAP DEPARTMENT
226 MIDDLE AVE. ELYRIA, OH

SURVEYED BY: N/A SURVEY # N/A
CLOSURE: N/A
MAP PAGE(S): 06-25-022
APPROVED BY: WRZ DATE: 9/29/2022
SCALE: 1" = 25 PRIOR INSTRUMENT: #2001-0727655