

PARENT PARCEL: 11-00-004-000-010



CHILD PARCEL: 11-00-004-000-018, -019, & -020 **AC CORR PER SURV BY JOSHUA S. RIEDY**

22-04564

STARTING POINT: C/L OF CAPEL RD AND SE CORNER OF O/L 4



-004
33.96

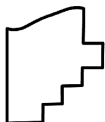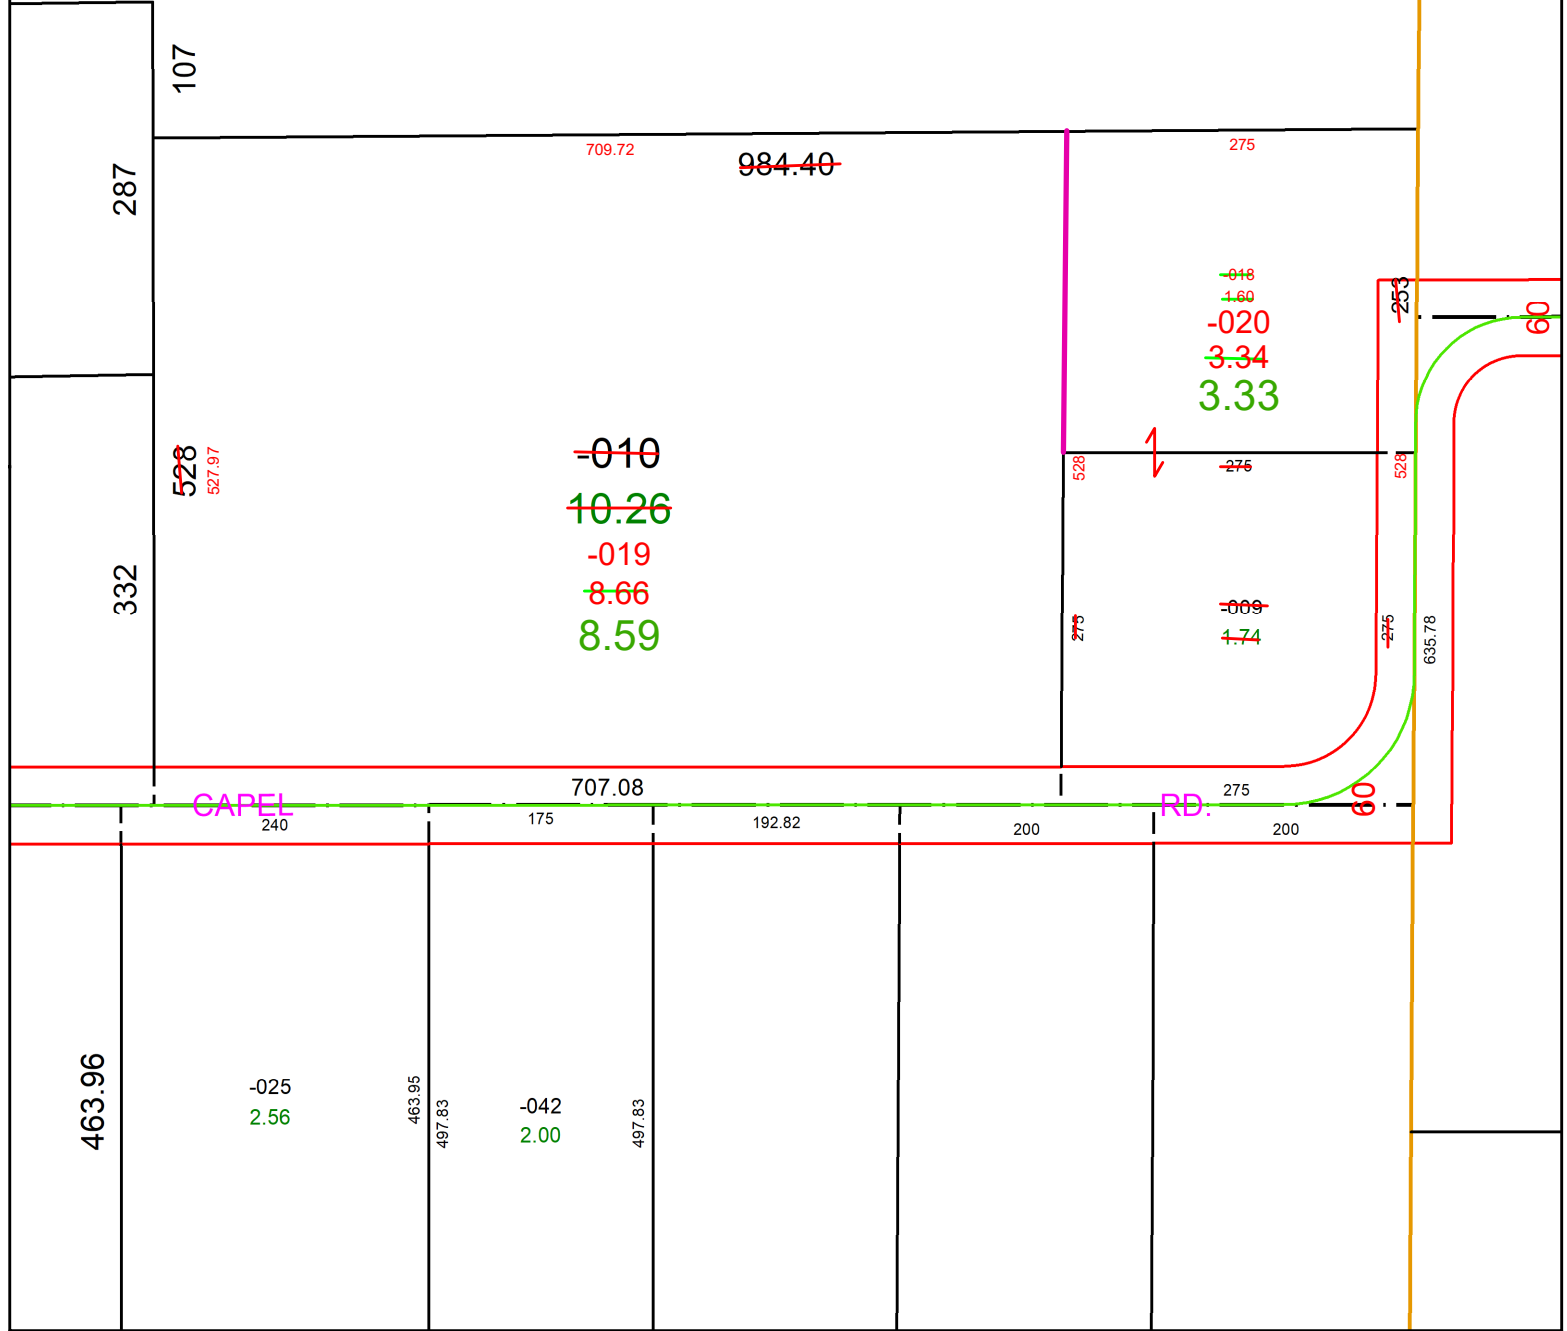

SPLITS/DEEDS PROCESSED
LORAIN COUNTY TAX MAP DEPARTMENT
226 MIDDLE AVE. ELYRIA, OH

SURVEYED BY: JOSHUA S. RIEDY SURV # 50702
CLOSURE: 1: 2147483648
MAP PAGE(S): 11-00-004-B
APPROVED BY: AC DATE: October 04, 2022
SCALE: 1 in = 150 ft PRIOR INSTRUMENT: 2017- 0641319