
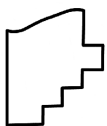


PARENT PARCEL: 17-07-007-000-010

CHILD PARCEL: _____

STARTING POINT: SW CORNER OF LAND RECORDED IN VOL 372, PG 546 AND C/L OF MEDINA-NORWALK RD

21-04565-A

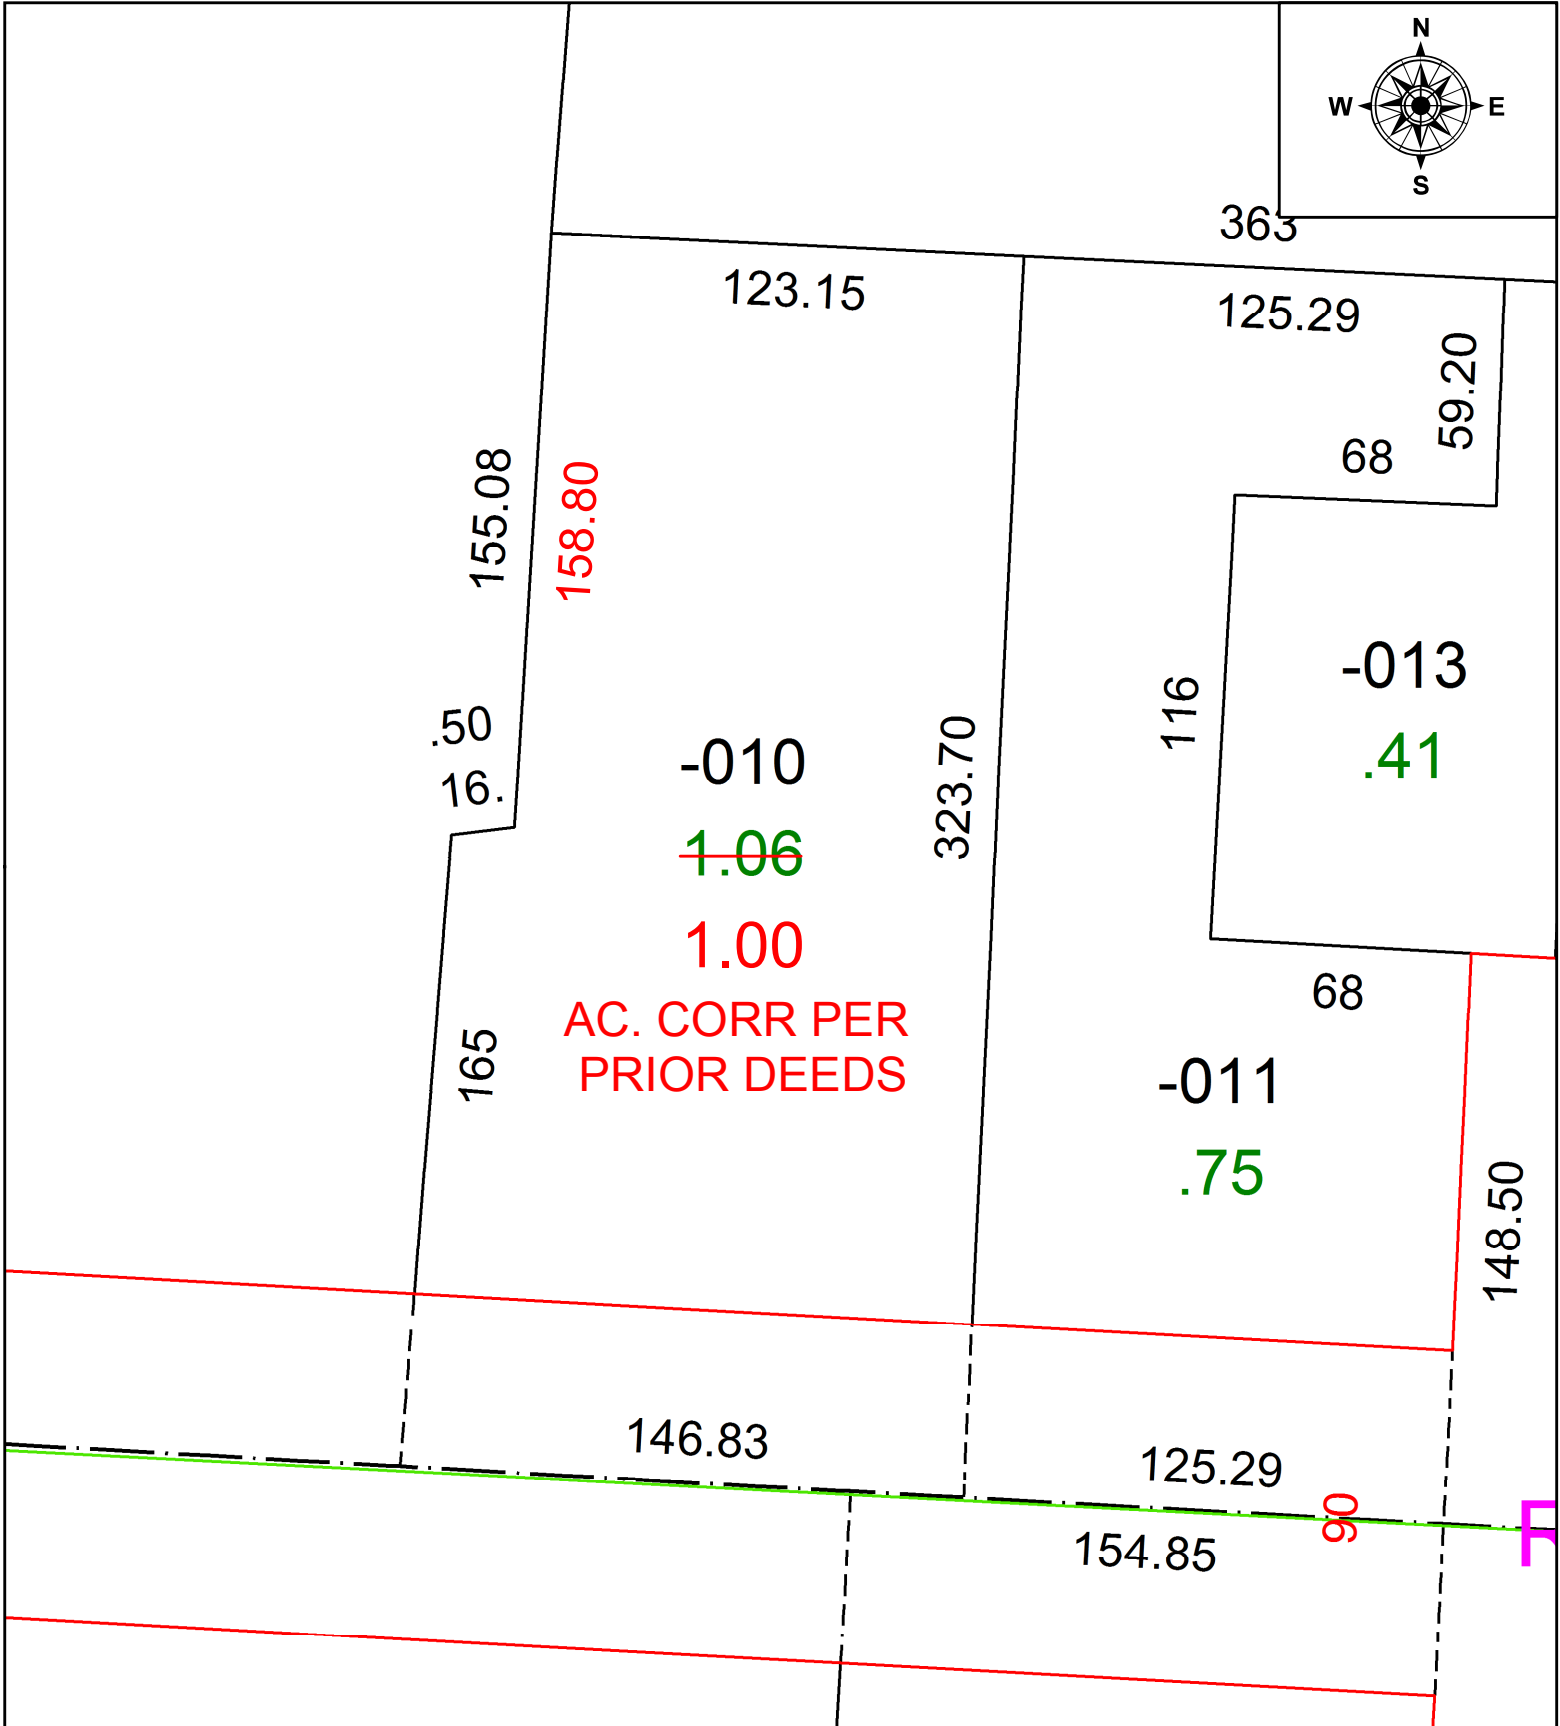

SPLITS/DEEDS PROCESSED
 LORAIN COUNTY TAX MAP DEPARTMENT
 226 MIDDLE AVE. ELYRIA, OH

SURVEYED BY: _____ N/A
 CLOSURE: _____ 1: 35000
 MAP PAGE(S): _____ 17-07-007-B
 APPROVED BY: _____ AC DATE: _____ 5/18/2021
 SCALE: _____ 1" = 50 _____ PRIOR INSTRUMENT: _____ 2018-0689233