


PARENT PARCEL: 14-00-026-000-009


CHILD PARCEL: _____

STARTING POINT: NE CORNER OF PITTSFIELD O/L 26

21-04566-A

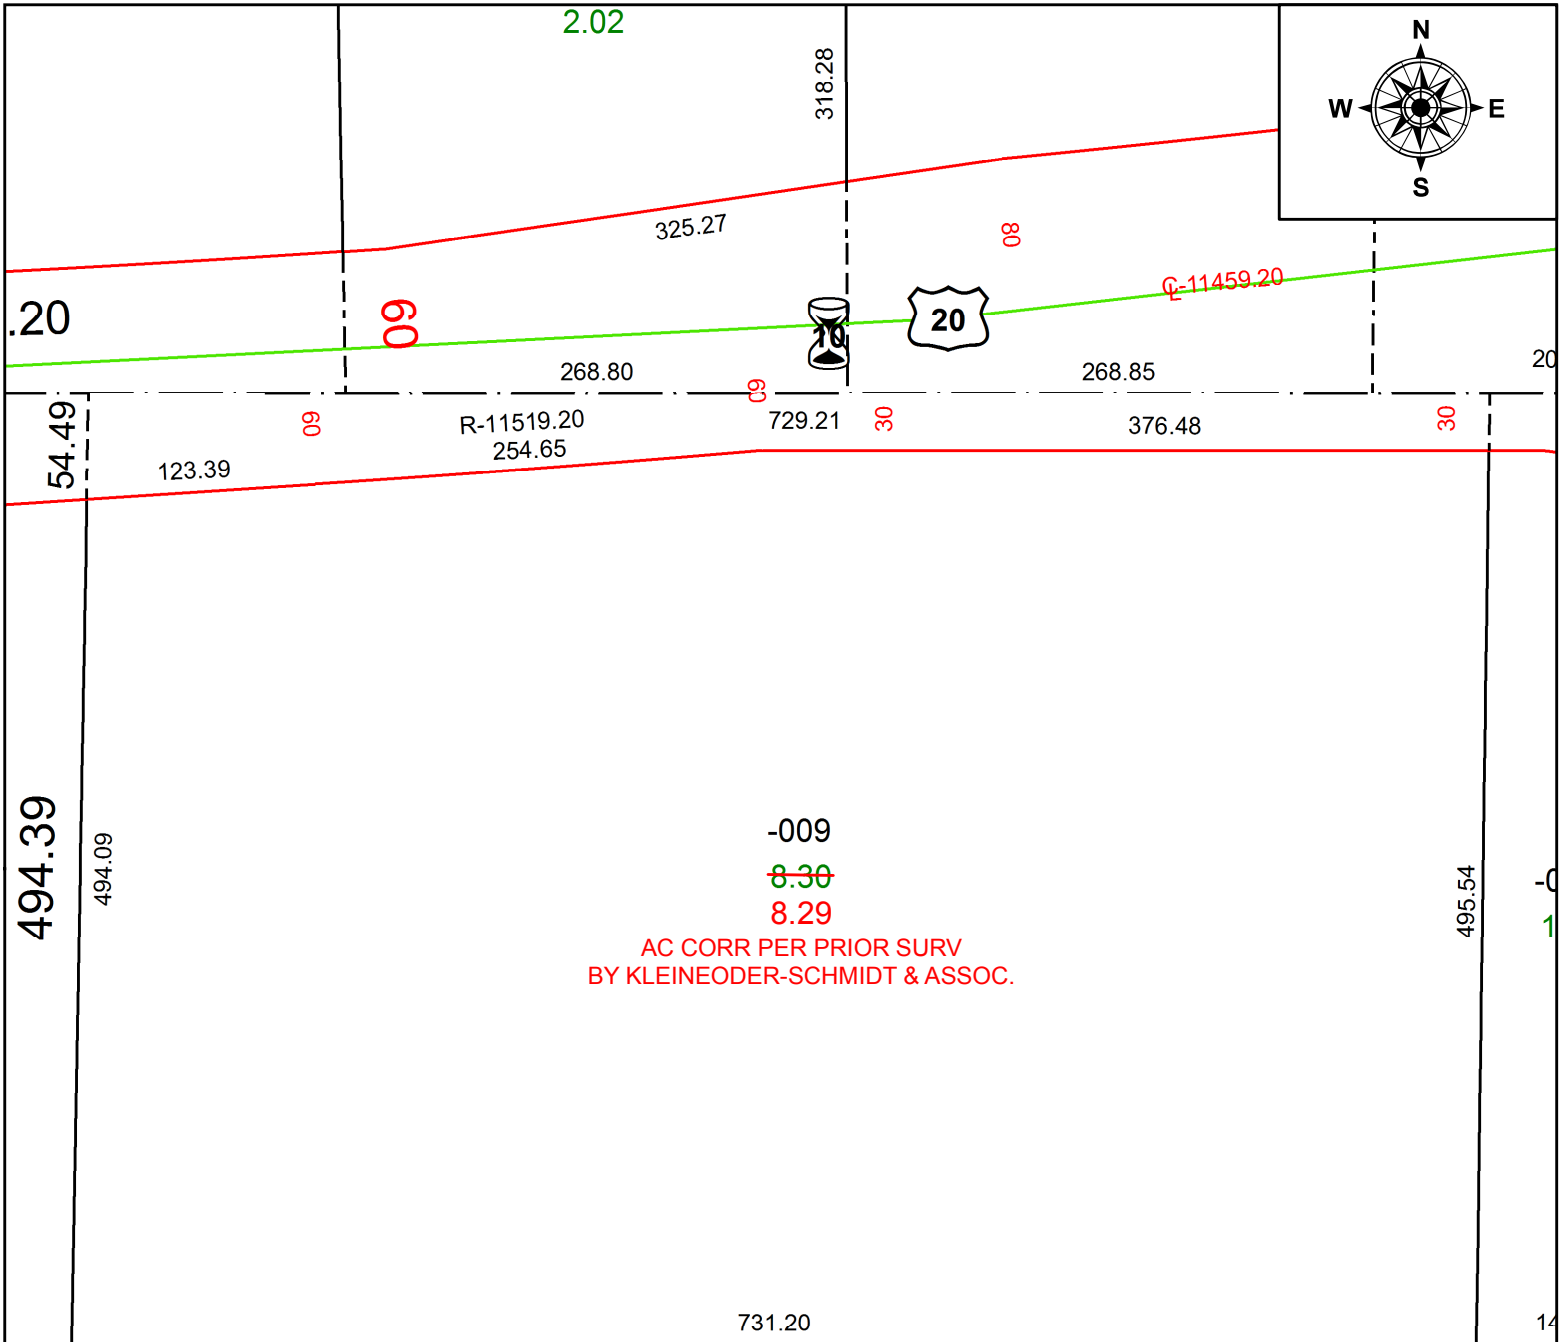

880.63

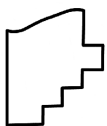

SPLITS/DEEDS PROCESSED
 LORAIN COUNTY TAX MAP DEPARTMENT
 226 MIDDLE AVE. ELYRIA, OH

SURVEYED BY: KLEINEODER-SCHMIDT & ASSOC.

CLOSURE: 1: 880367

MAP PAGE(S): 14-00-026-B

APPROVED BY: AC DATE: 5-19-2021

SCALE: 1" = 100 PRIOR INSTRUMENT: 2018:0675274