


PARENT PARCEL: 01-00-035-000-067

CHILD PARCEL: _____

STARTING POINT: C/L OF COOPER FOSTER PARK AND VERMILION ROAD

21-04567-A

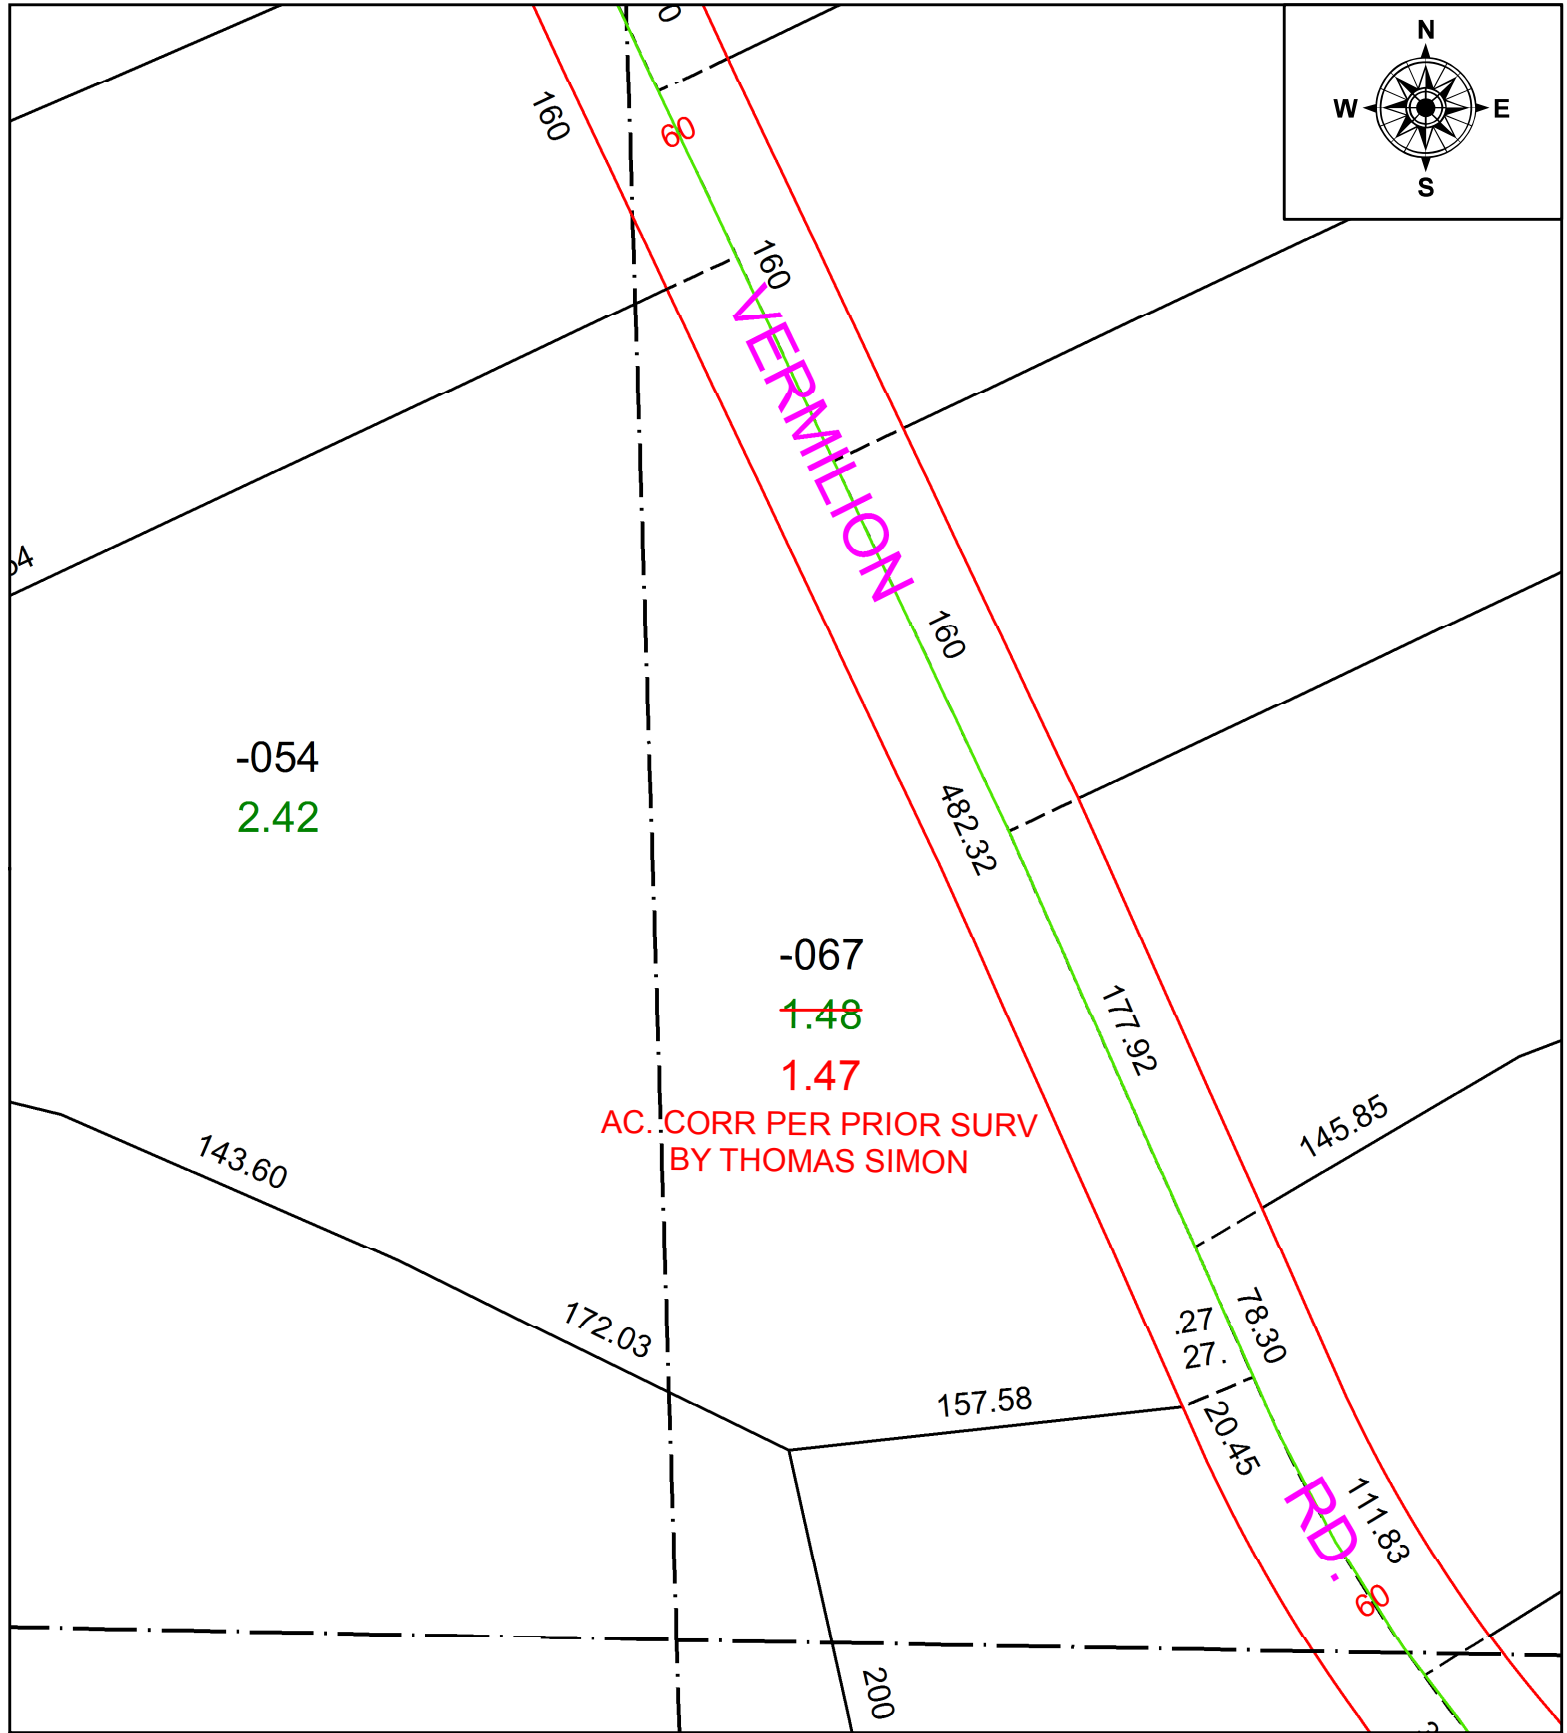

SPLITS/DEEDS PROCESSED
LORAIN COUNTY TAX MAP DEPARTMENT
226 MIDDLE AVE. ELYRIA, OH

SURVEYED BY:	THOMAS A. SIMON
CLOSURE:	1: 179472
MAP PAGE(S):	01-00-035-A
APPROVED BY:	AC DATE: 5-19-2021
SCALE:	1" = 75' PRIOR INSTRUMENT: 2021: 0804486