



PARENT PARCEL: 03-00-111-104-006, -007, -008, -015

CHILD PARCEL: 03-00-111-104-018

STARTING POINT: SE CORNER OF S/L 65

COMBINATION

22-04567

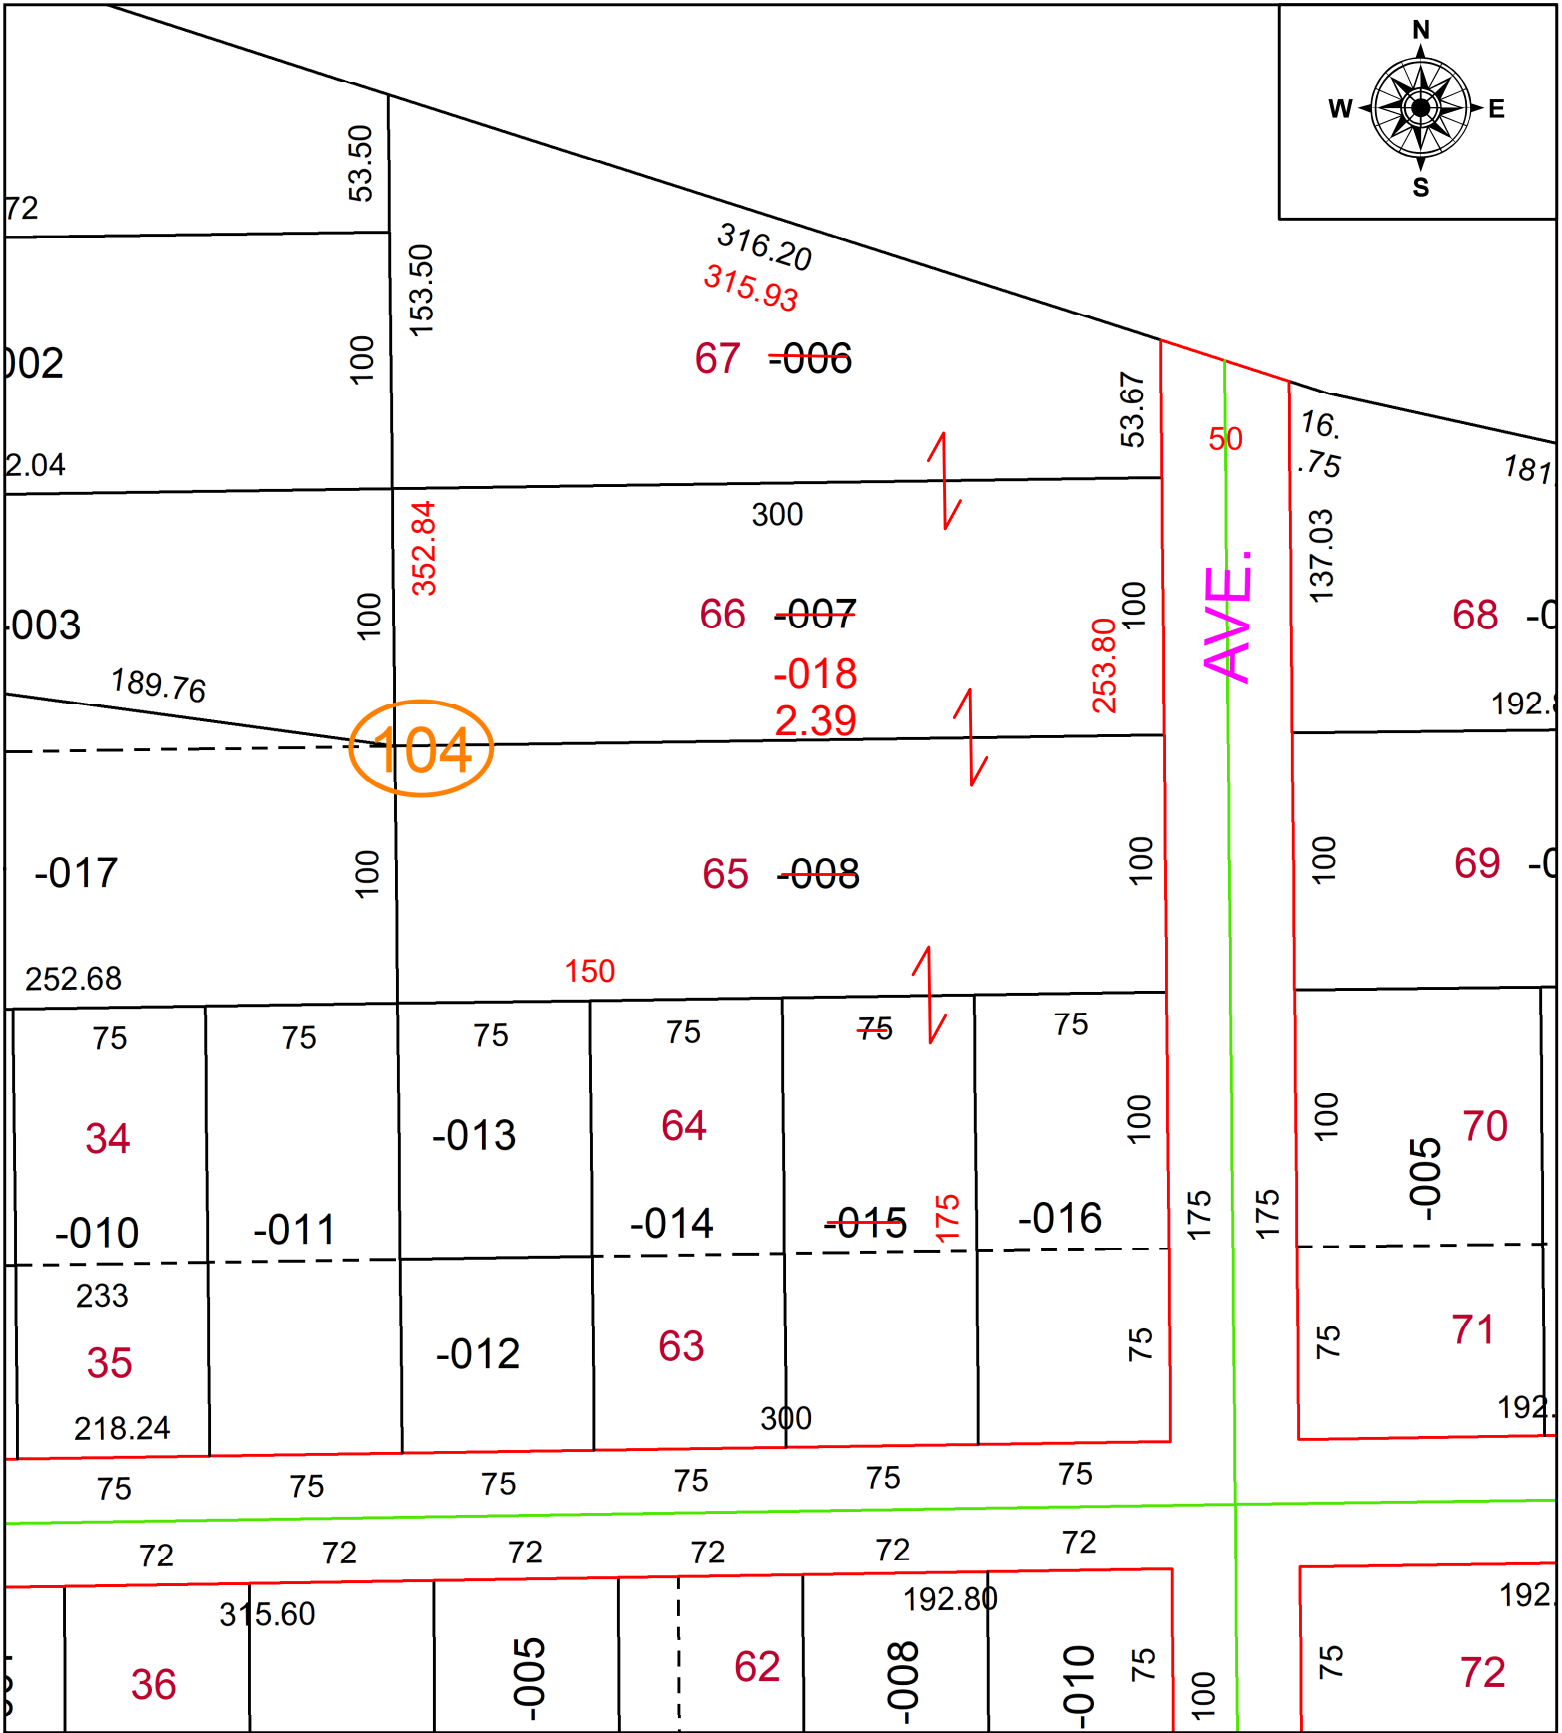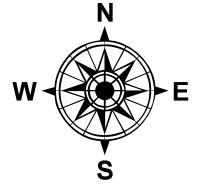

SPLITS/DEEDS PROCESSED
 LORAIN COUNTY TAX MAP DEPARTMENT
 226 MIDDLE AVE. ELYRIA, OH

SURVEYED BY: JOSHUA S. RIEDY SURV # 50707
 CLOSURE: 1: 253146
 MAP PAGE(S): 03-00-111-A
 APPROVED BY: AC DATE: October 06, 2022
 SCALE: 1 in = 75 ft PRIOR INSTRUMENT: 2021- 0848731