


PARENT PARCEL: 03-00-113-102-080 & -092


CHILD PARCEL: 03-00-113-102-108 **AC. CORR. PER SURVEY HOWARD McILVRIED**

STARTING POINT: CL OF BROADWAY & COOPER FOSTER PARK RD.

22-04568

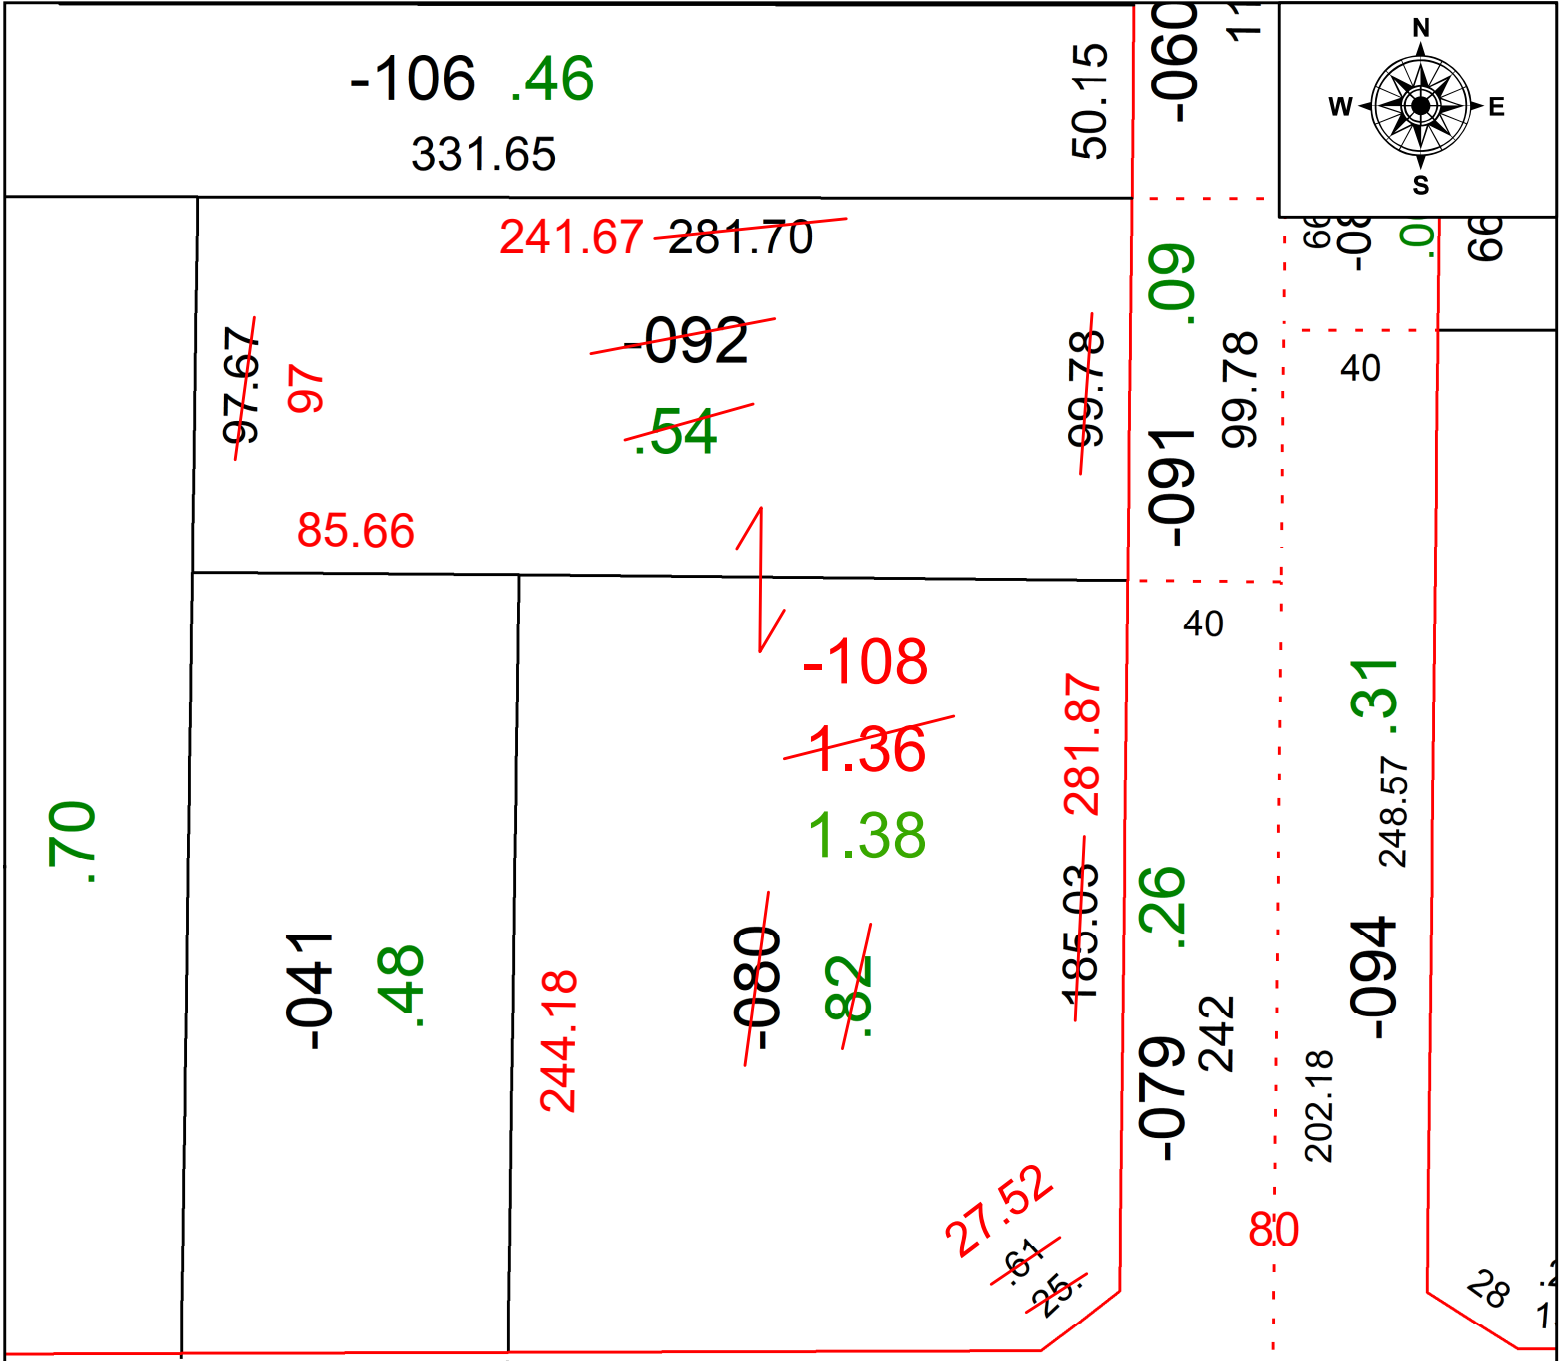

COOPER-FOSTER PARK

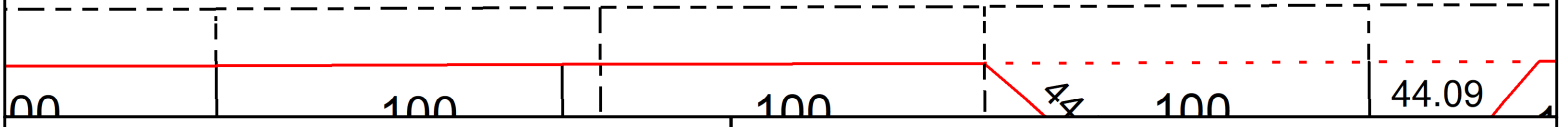

**SPLITS/DEEDS PROCESSED**  
 LORAIN COUNTY TAX MAP DEPARTMENT  
 226 MIDDLE AVE. ELYRIA, OH

SURVEYED BY: HOWARD McILVRIED SURVEY #: 50708  
 CLOSURE: 1:131782  
 MAP PAGE(S): 03-00-113  
 APPROVED BY: DMA DATE: 10/6/2022  
 SCALE: 1" = 50' PRIOR INSTRUMENT: 2022-0887966