


PARENT PARCEL: 03-00-113-109-011

21-04569-C


CHILD PARCEL: _____

STARTING POINT: C/L OF NORTH RIDGE ROAD AND LAND CONVEYED IN VOL 561, PG 180

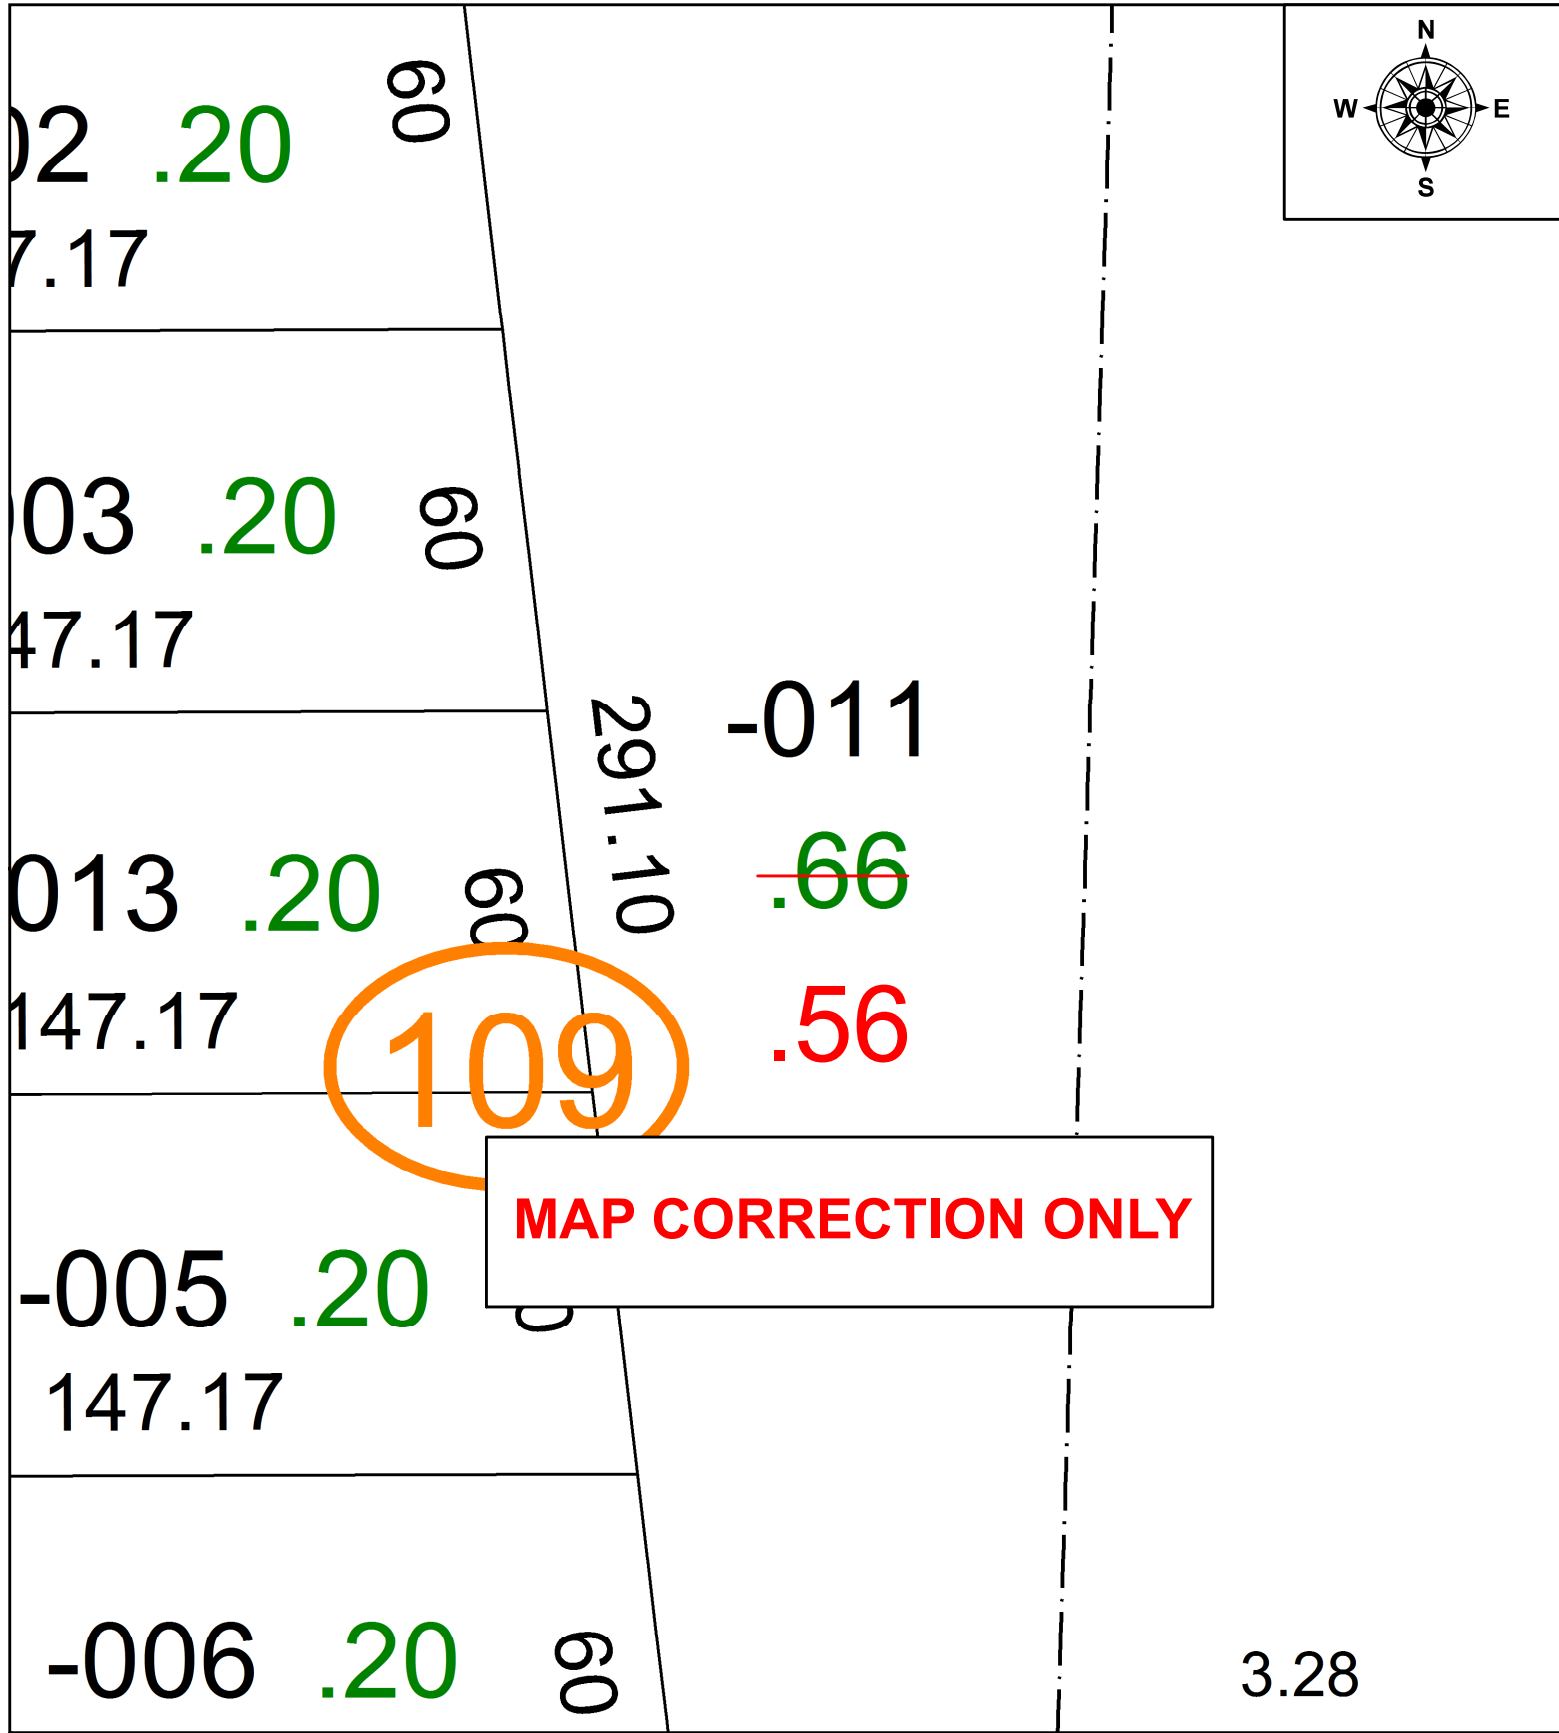

109

MAP CORRECTION ONLY

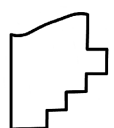

SPLITS/DEEDS PROCESSED
 LORAIN COUNTY TAX MAP DEPARTMENT
 226 MIDDLE AVE. ELYRIA, OH

SURVEYED BY: _____ N/A
 CLOSURE: _____ N/A
 MAP PAGE(S): _____ 03-00-113-B
 APPROVED BY: _____ AC DATE: _____ 5-20-2021
 SCALE: _____ 1" = 30 PRIOR INSTRUMENT: _____ 2012-0441622