

PARENT PARCEL:

03-00-007-101-009, -050, & -051

CHILD PARCEL:


03-00-007-101-066


ACREAGE CORRECTION PER SURVEYOR PATRICK MCGANNON

22-04569

STARTING POINT:

MONUMENT BOX @ INTERSECTION OF ORG. C/L OF ABBE RD & NORTH LINE OF O.L. 7

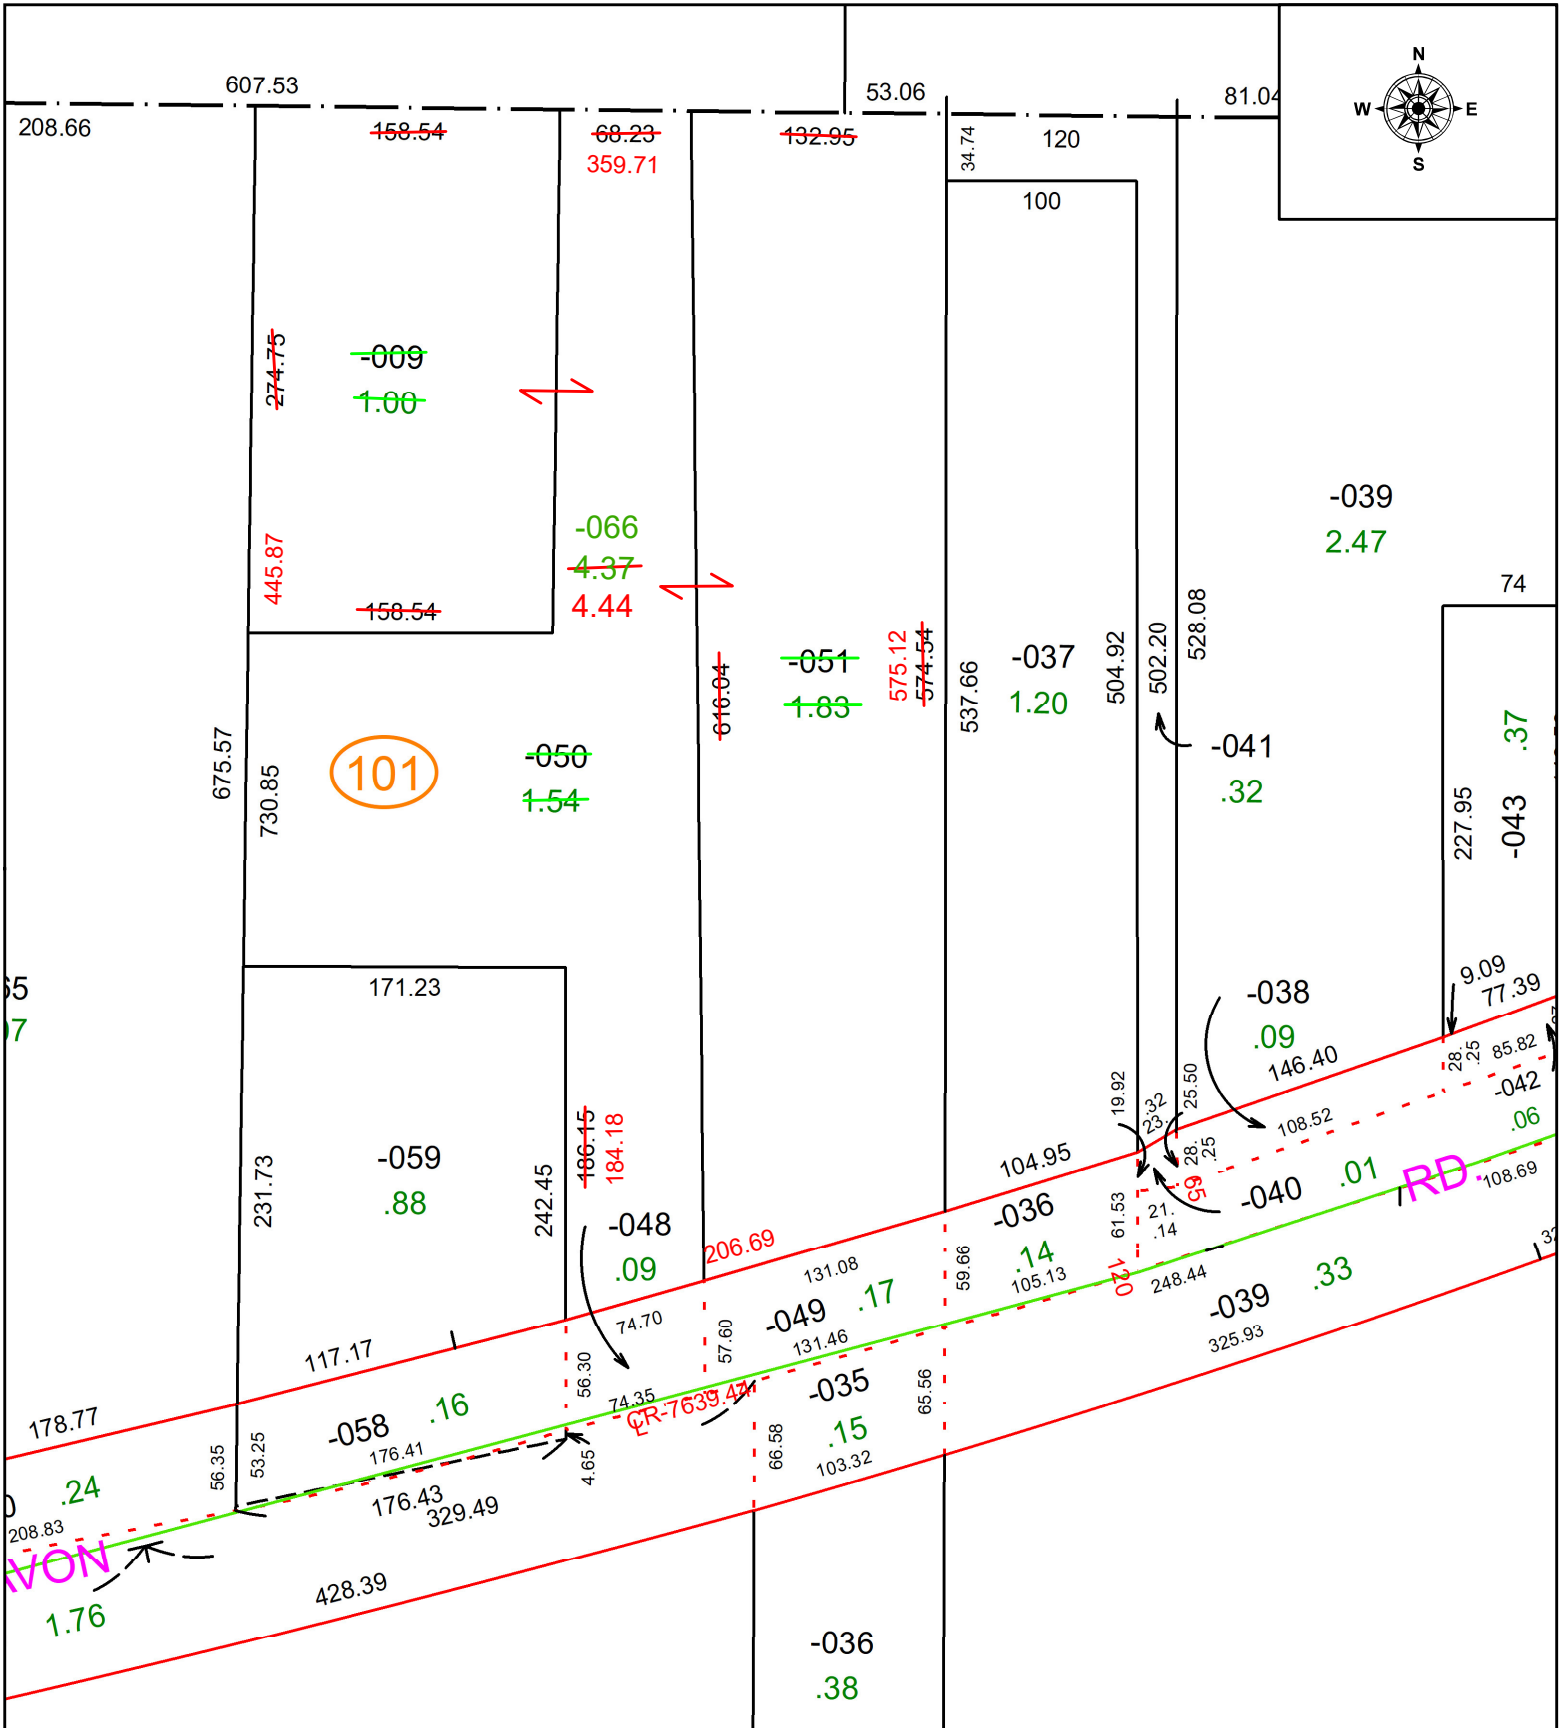

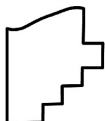 **SPLITS/DEEDS PROCESSED**
 LORAIN COUNTY TAX MAP DEPARTMENT
 226 MIDDLE AVE. ELYRIA, OH

SURVEYED BY: PATRICK MCGANNON SURVEY # 50709
CLOSURE: 1: 235808
MAP PAGE(S): 03-00-007
APPROVED BY: WRZ **DATE:** 10/11/2022
SCALE: 1" = 100 **PRIOR INSTRUMENT:** DV 972, PG 518