


PARENT PARCEL: 05-00-016-101-191

CHILD PARCEL: 05-00-016-101-192 & -193

N/A

22-04570

STARTING POINT: INTERSECTION OF C/LS OF WILLOW CREEK DR & SOUTH LAKE ST

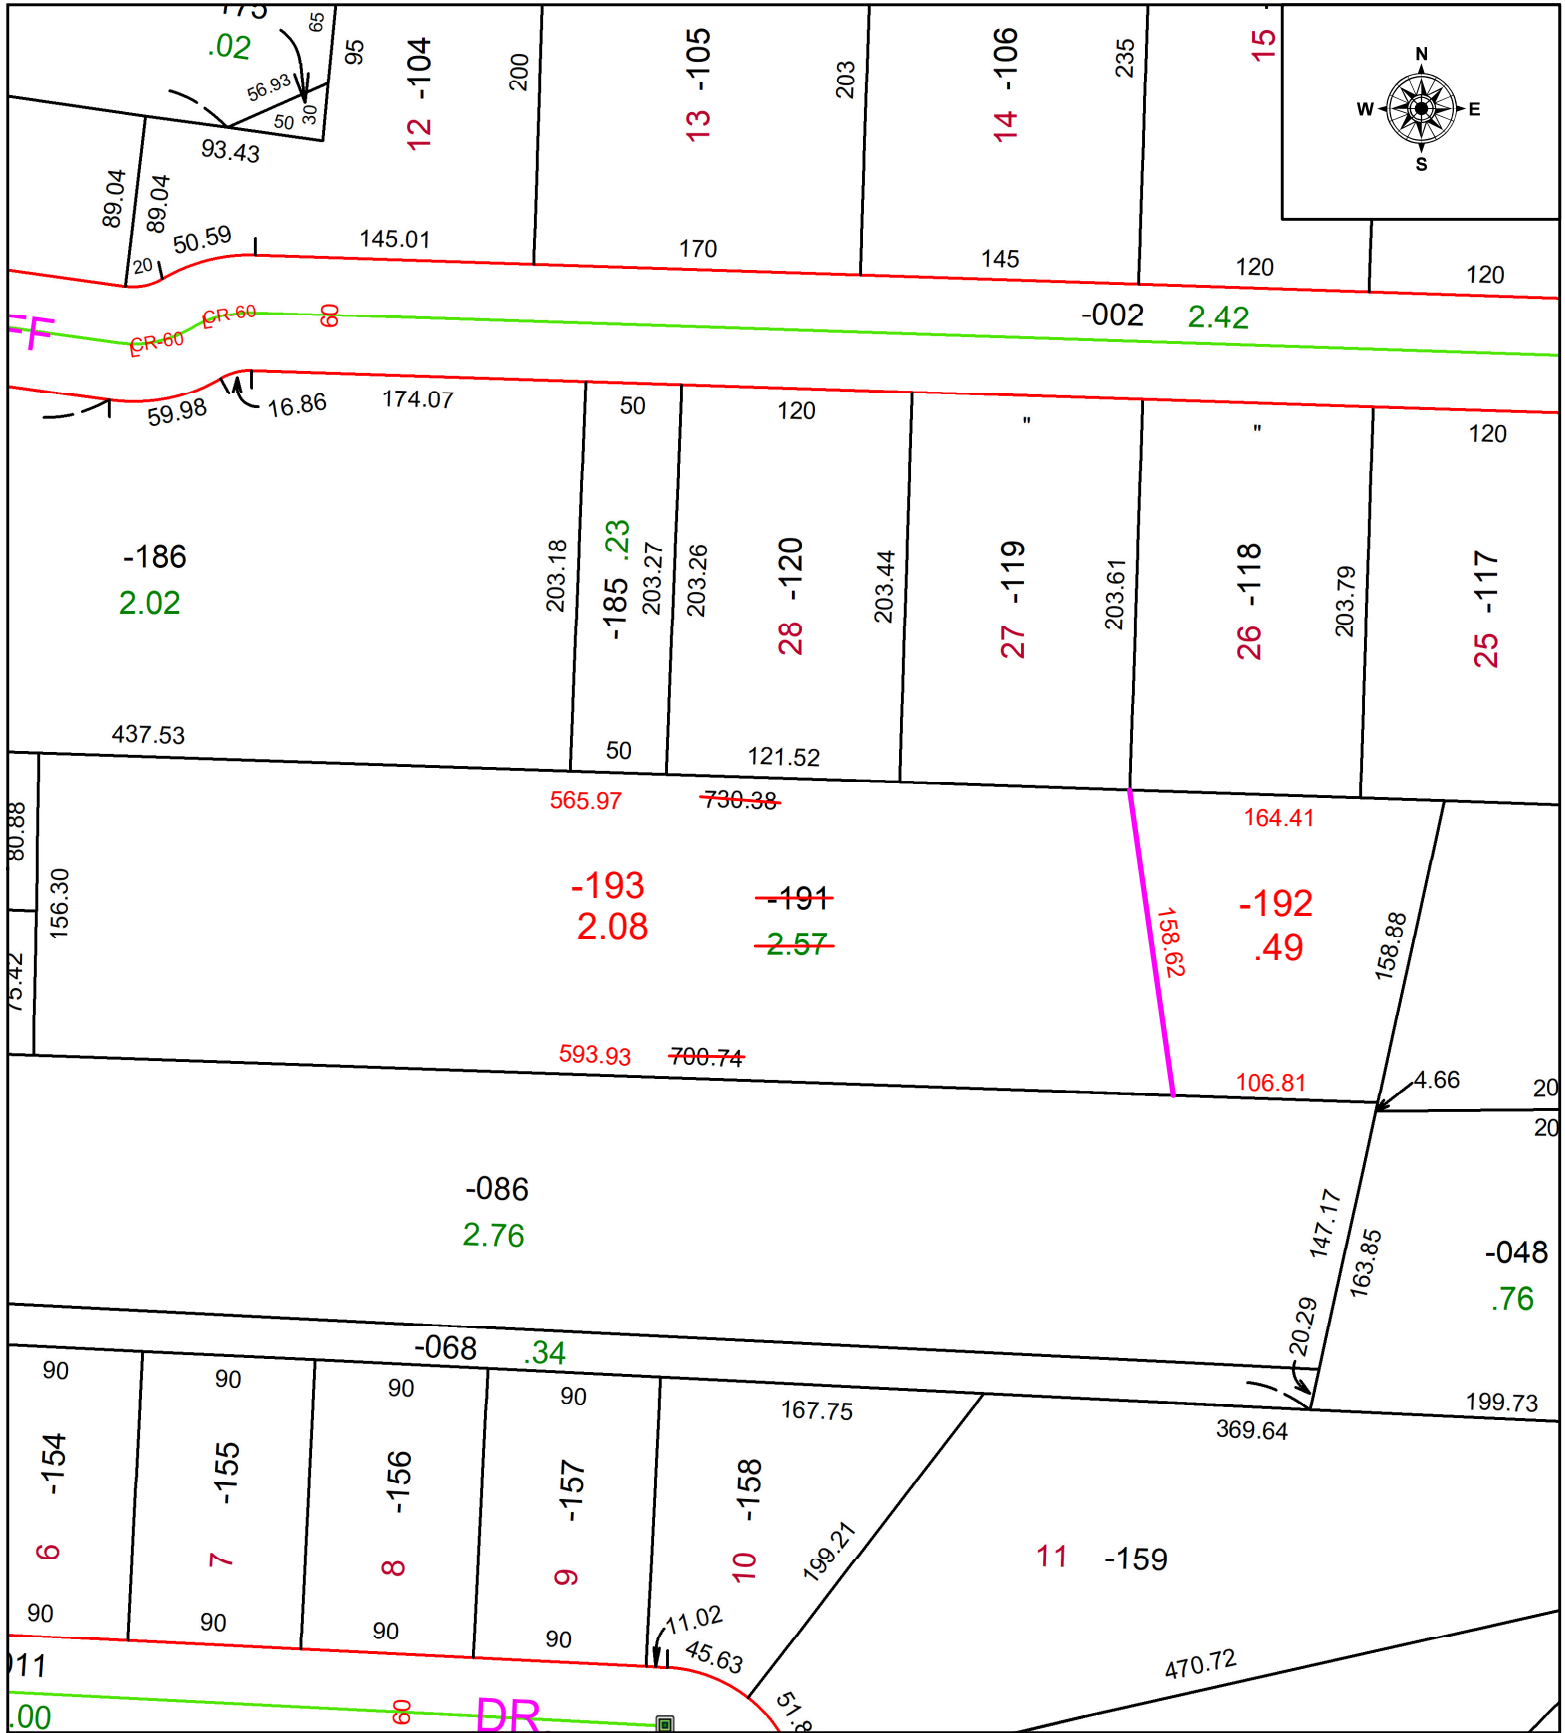

SPLITS/DEEDS PROCESSED
 LORAIN COUNTY TAX MAP DEPARTMENT
 226 MIDDLE AVE. ELYRIA, OH

SURVEYED BY: JOSHUA RIEDY SURVEY # 50710
 CLOSURE: 1: 362073
 MAP PAGE(S): 05-00-016
 APPROVED BY: WRZ DATE: 10/12/2022
 SCALE: 1" = 100 PRIOR INSTRUMENT: #2022-0859893