
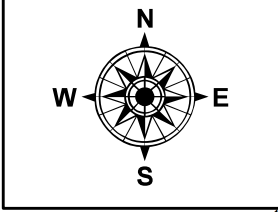


PARENT PARCEL: 05-00-097-103-008

CHILD PARCEL: 05-00-097-103-143 THRU -146


STARTING POINT: CL OF QUARRY RD. & NORTH RIDGE RD.

22-04571

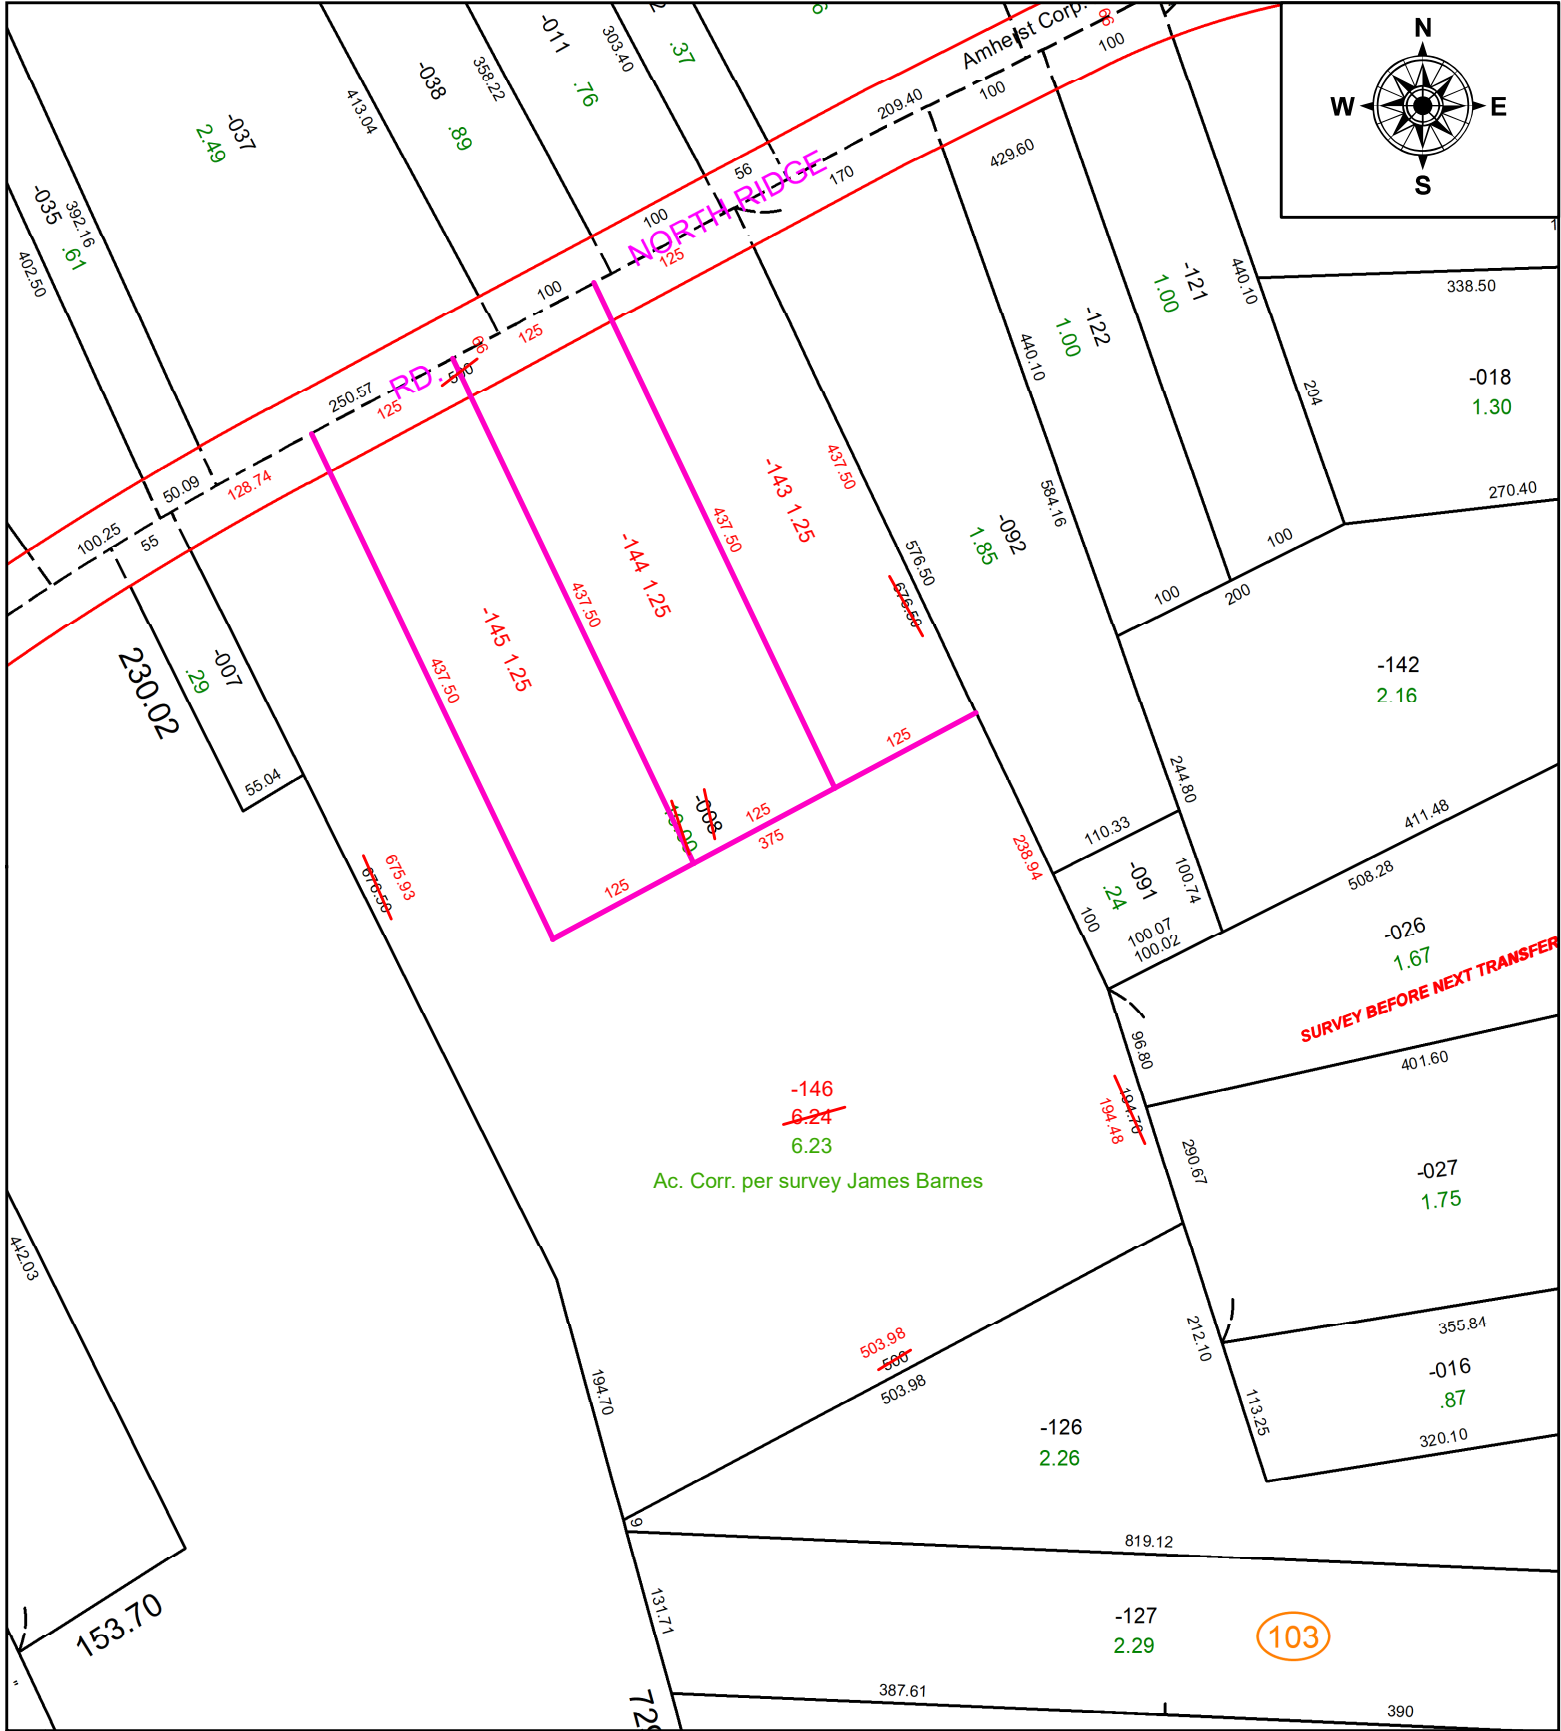

SURVEY BEFORE NEXT TRANSFER

103

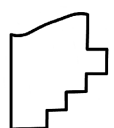

SPLITS/DEEDS PROCESSED
 LORAIN COUNTY TAX MAP DEPARTMENT
 226 MIDDLE AVE. ELYRIA, OH

SURVEYED BY: JAMES BARNES **SURVEY #:** 50712
CLOSURE: 1:-2147483648
MAP PAGE(S): 05-00-097
APPROVED BY: DMA **DATE:** 10/12/2022
SCALE: 1" = 150' **PRIOR INSTRUMENT:** 2022-0886060